


SIDE SEWER AS BUILT

CITY OF MOUNTLAKE TERRACE

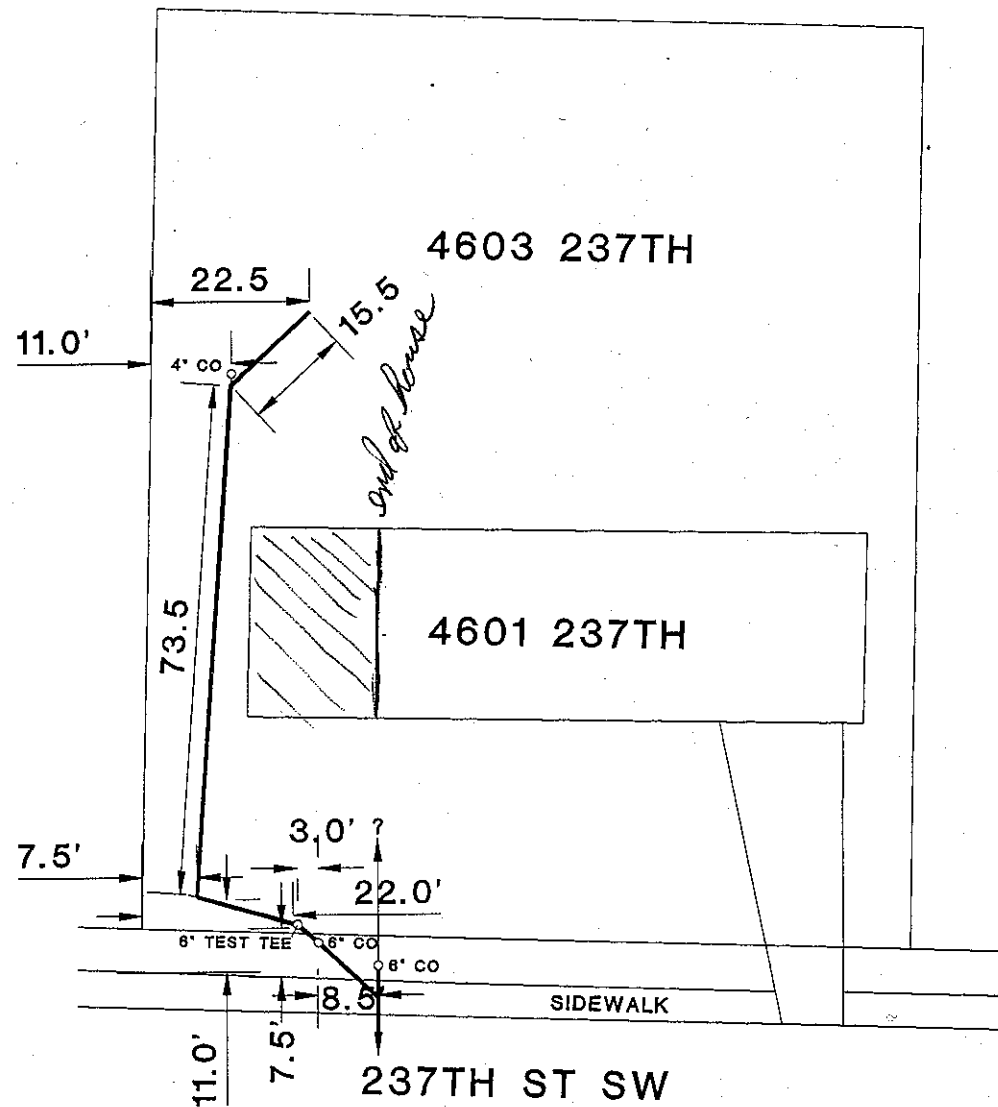

OWNER: - SEA COAST CONSTRUCTION

ADDRESS: - 4601 237TH ST SW

CONTRACTOR: - LYNNWOOD SEPTIC

PERMIT NO.: - U-94-09

ISSUE DATE: - 7/22/94

INSPECTED BY: - D.M.S.

DATE: - 8/5/94



NOT TO SCALE