

The City of Mountlake Terrace

APPLICATION

for

SIDE SEWER PERMIT

OUTSIDE ☐ INSIDE ☐ REPAIRS ☐

2188


CARD No. ....

EASEMENT No. ....

OWNER Elmer V. Mos. CONTRACTOR Synnwood Septic Tank PERMIT No. 3199

HOUSE No. 4511 STREET 34 AVENUE LOT No. 34 BLOCK No. 243 pl SW

NAME ADD. Terrace Ridge

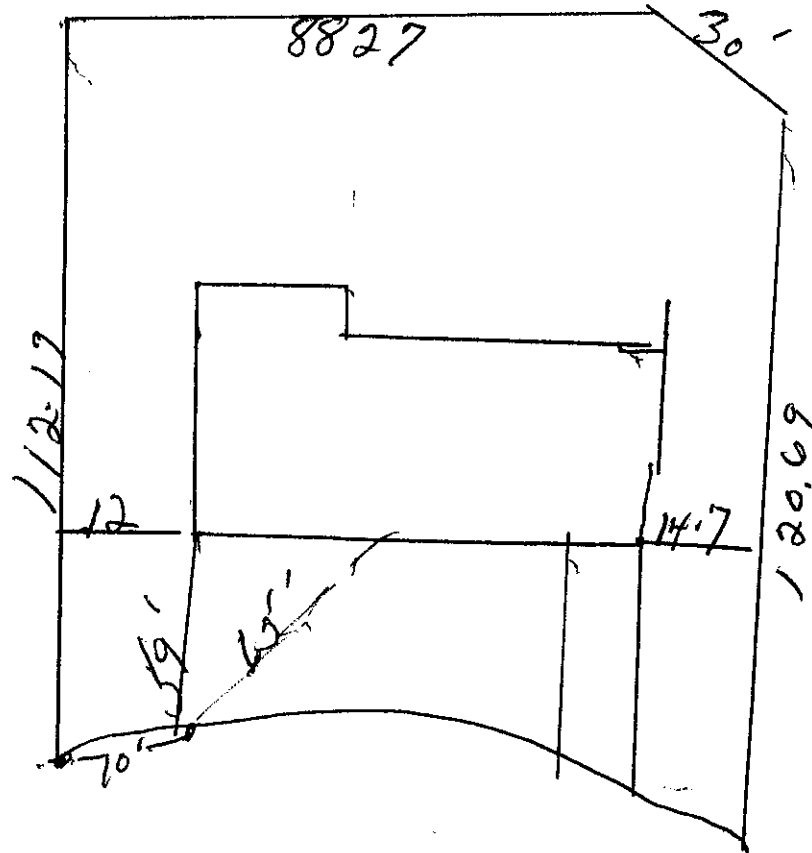

Date

Approved:

BACKFILL WORK ORDER ISSUED..... DEPOSIT, \$.....

SEWER WORK ORDER ISSUED.....

DATE..... BY.....