

The City of Mountlake Terrace

APPLICATION

for

SIDE SEWER PERMIT

OUTSIDE ☒ INSIDE ☐ REPAIRS ☐

CARD No. _____

EASEMENT No. _____


OWNER D THOMAS CONTRACTOR MONTES EXC PERMIT No. 4-39-83

HOUSE No. 21605 48TH AVE W STREET AVENUE LOT No. 2 BLOCK No. _____

NAME ADD SHAMINONWOOD VILLAGE

48TH AVE

SEPTIC TANK Cleared
OUT 1/17/84

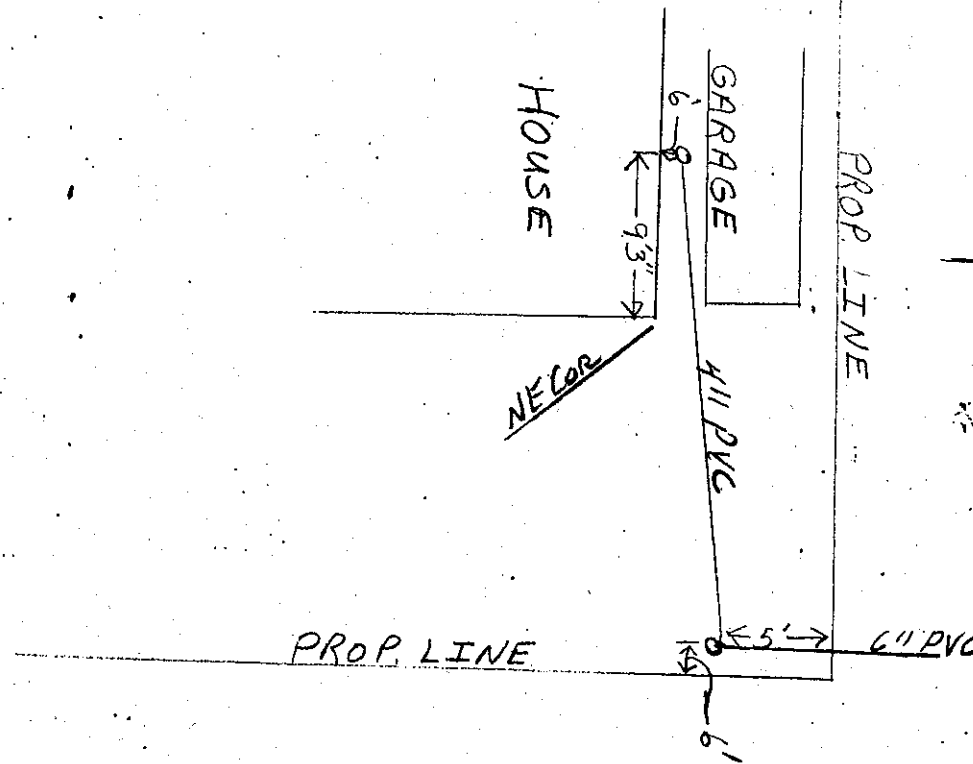

BACKFILL WORK ORDER ISSUED 1/18/84 DEPOSIT, \$ 20⁰⁰
SEWER WORK ORDER ISSUED 12/8/83

Approved: _____
DATE 1/18/84 BY F.H. Smith