

The City of Mountlake Terrace

APPLICATION

for
SIDE SEWER PERMIT

OUTSIDE ☐ INSIDE ☐ REPAIRS ☐


CARD No. _____

EASEMENT No. _____

OWNER RICHARD L DUBOIS CONTRACTOR SUBURBAN SEPTIC SERVICE PERMIT No. 384

HOUSE No. 22908 53 W STREET 12 AVENUE LOT No. 12 BLOCK No. 1

NAME ADD. MOUNTLAKE TERRACE BOX #12

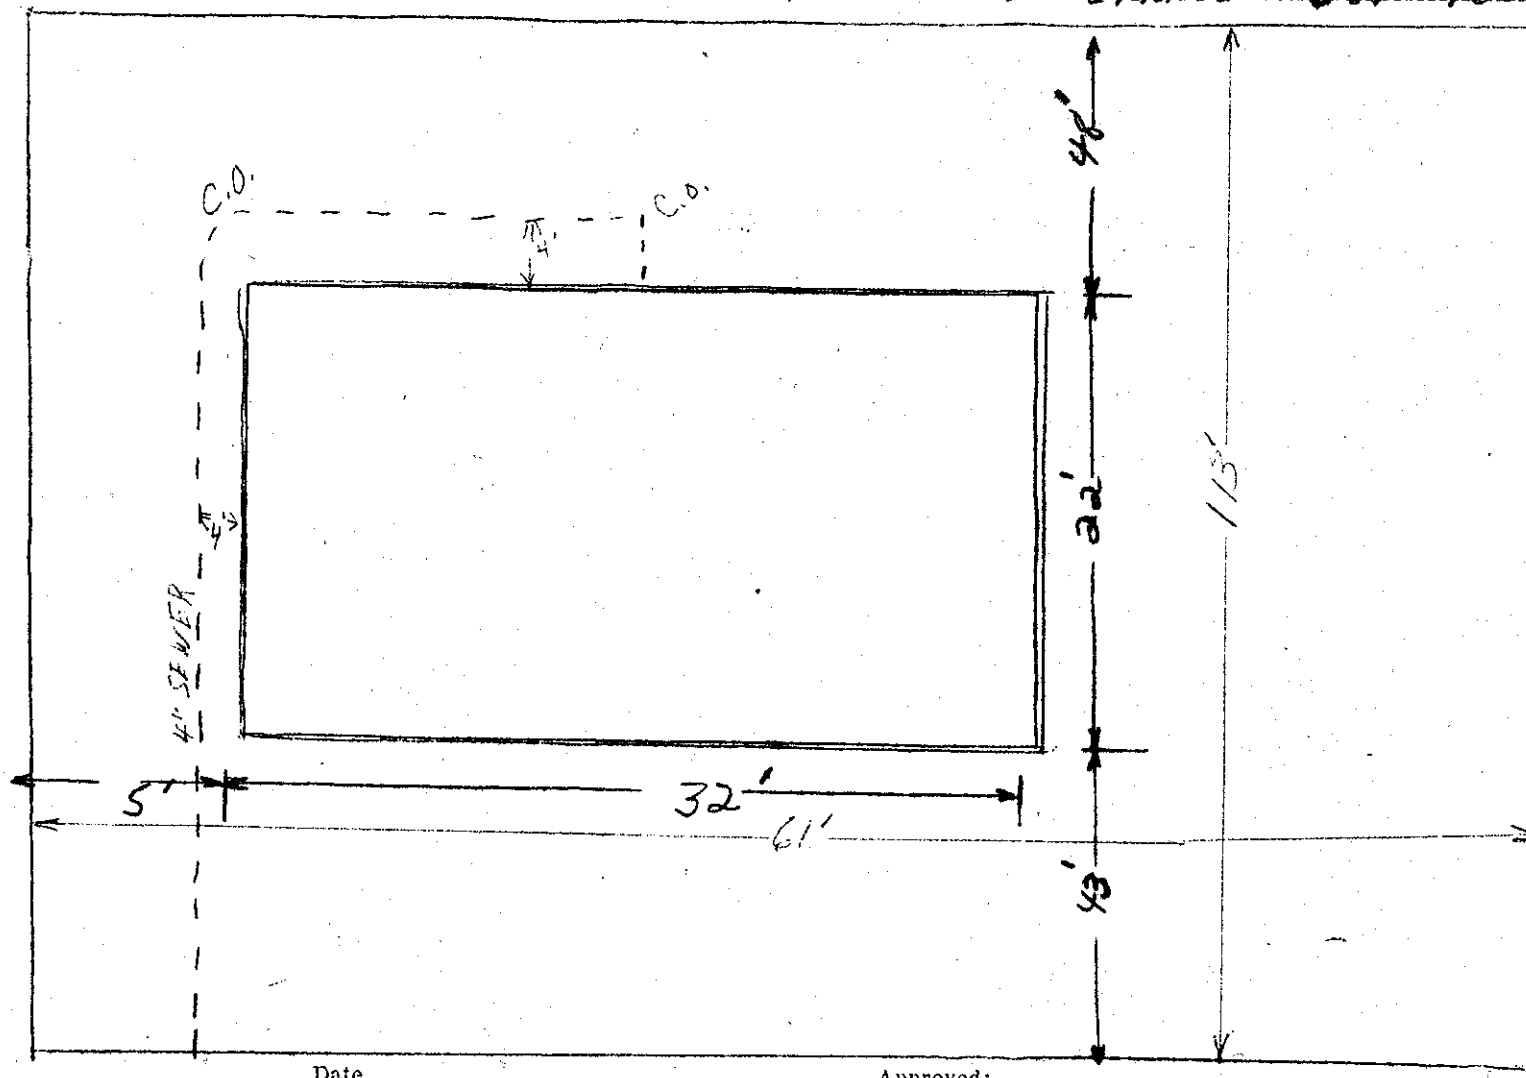

BACKFILL WORK ORDER ISSUED _____ DEPOSIT, \$ 10.00

SEWER WORK ORDER ISSUED _____

Approved: _____

DATE 8-17-60 BY S.M. Holtz INS & CON

#1813