

The City of Mountlake Terrace

APPLICATION

for

SIDE SEWER PERMIT

OUTSIDE ☐ INSIDE ☐ REPAIRS ☐


CARD No. _____

EASEMENT No. _____

OWNER SECURITY HOMES CONTRACTOR CASCADE SANITATION PERMIT No. 3897
HOUSE No. 5015 243 ST STREET 15 AVENUE LOT No. 3 BLOCK No. 3
NAME ADD PINE HILL ADD

10-3-96

5117 - 243 ^{on sewer}
5127 - 243 ^{septic}
5128 - 243 ^{septic}
no info
per Mike Shaw
county houses
3-6-96
Mike King
① maybe on sewer

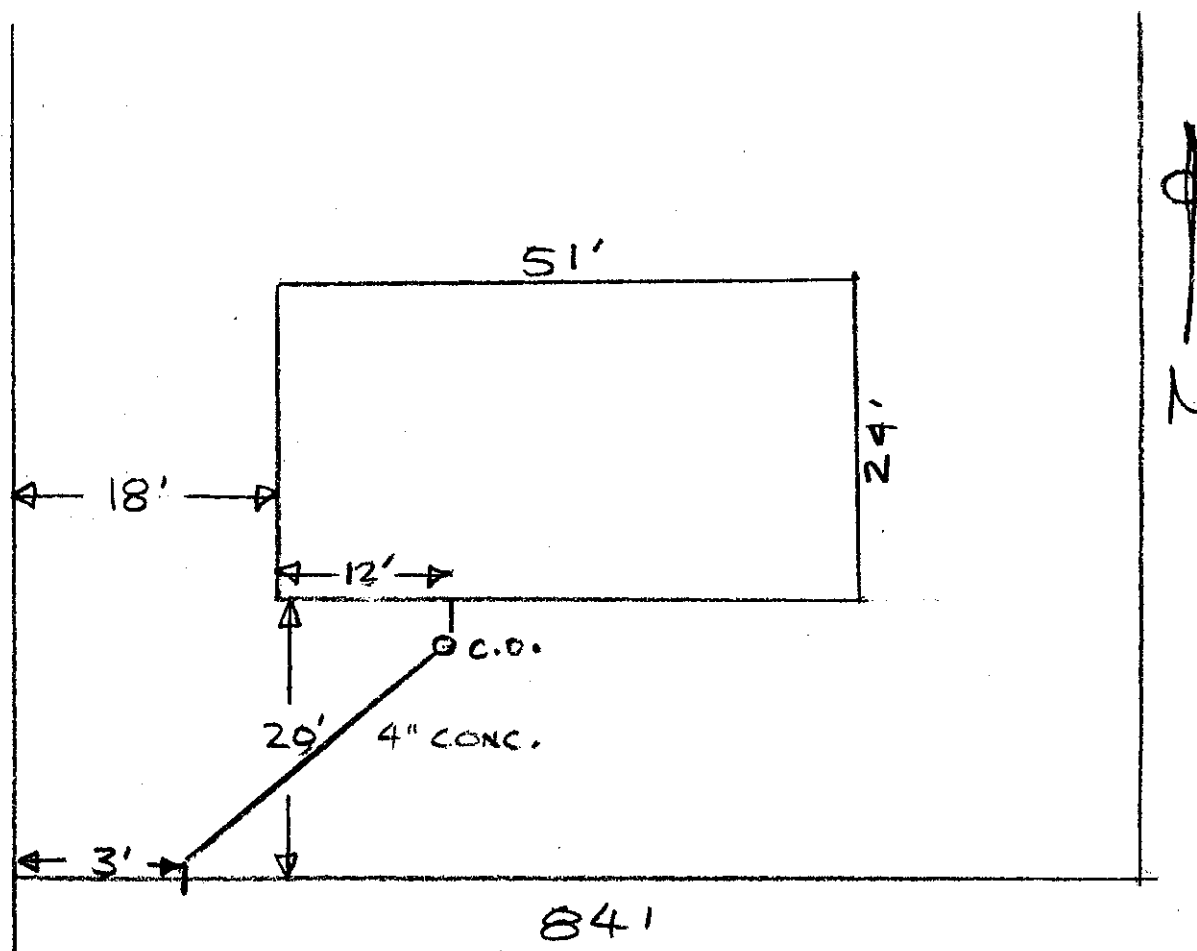

Date

Approved:

BACKFILL WORK ORDER ISSUED _____ DEPOSIT, \$ _____

SEWER WORK ORDER ISSUED _____

DATE 2-2-65 BY R. Baker