

44th AVE. W.

BM: SOUTH EDGE OF MON CASE
ELEV. 423.54, DATUM:
CITY OF MOUNTAIN TERRACE


212th ST. S.W.

NOTE: SANITARY SEWER IMPROVEMENTS
SHOWN ARE PROPOSED DURING
CONSTRUCTION OF L.I.D. STREET IMPROVEMENT PROJECT

NOTES:

1. ALL WORK AND MATERIALS SHALL BE IN ACCORDANCE WITH THE CITY OF MOUNTAIN TERRACE STANDARDS AND SPECIFICATIONS.
2. THE CONTRACTOR SHALL VERIFY THE LOCATION OF ALL EXISTING UTILITIES PRIOR TO ANY CONSTRUCTION OR EXCAVATION.
3. CONNECTIONS OF SIDE SEWERS MADE DIRECTLY INTO MANHOLES SHALL BE CHANGED TO MATCH SEWER MAIN CROWN.
4. MANHOLE TO BE INSTALLED WITHIN 24" OF S.W. (MH-20) SHALL BE PROVIDED WITH KNOCKOUTS AND CHANNLED FOR FUTURE SEWER SERVICE TO THE EAST AND WEST.
5. ALL GRAVITY FLOW SANITARY SEWER PIPE SHALL BE PVC SD-35.

214th ST. S.W.

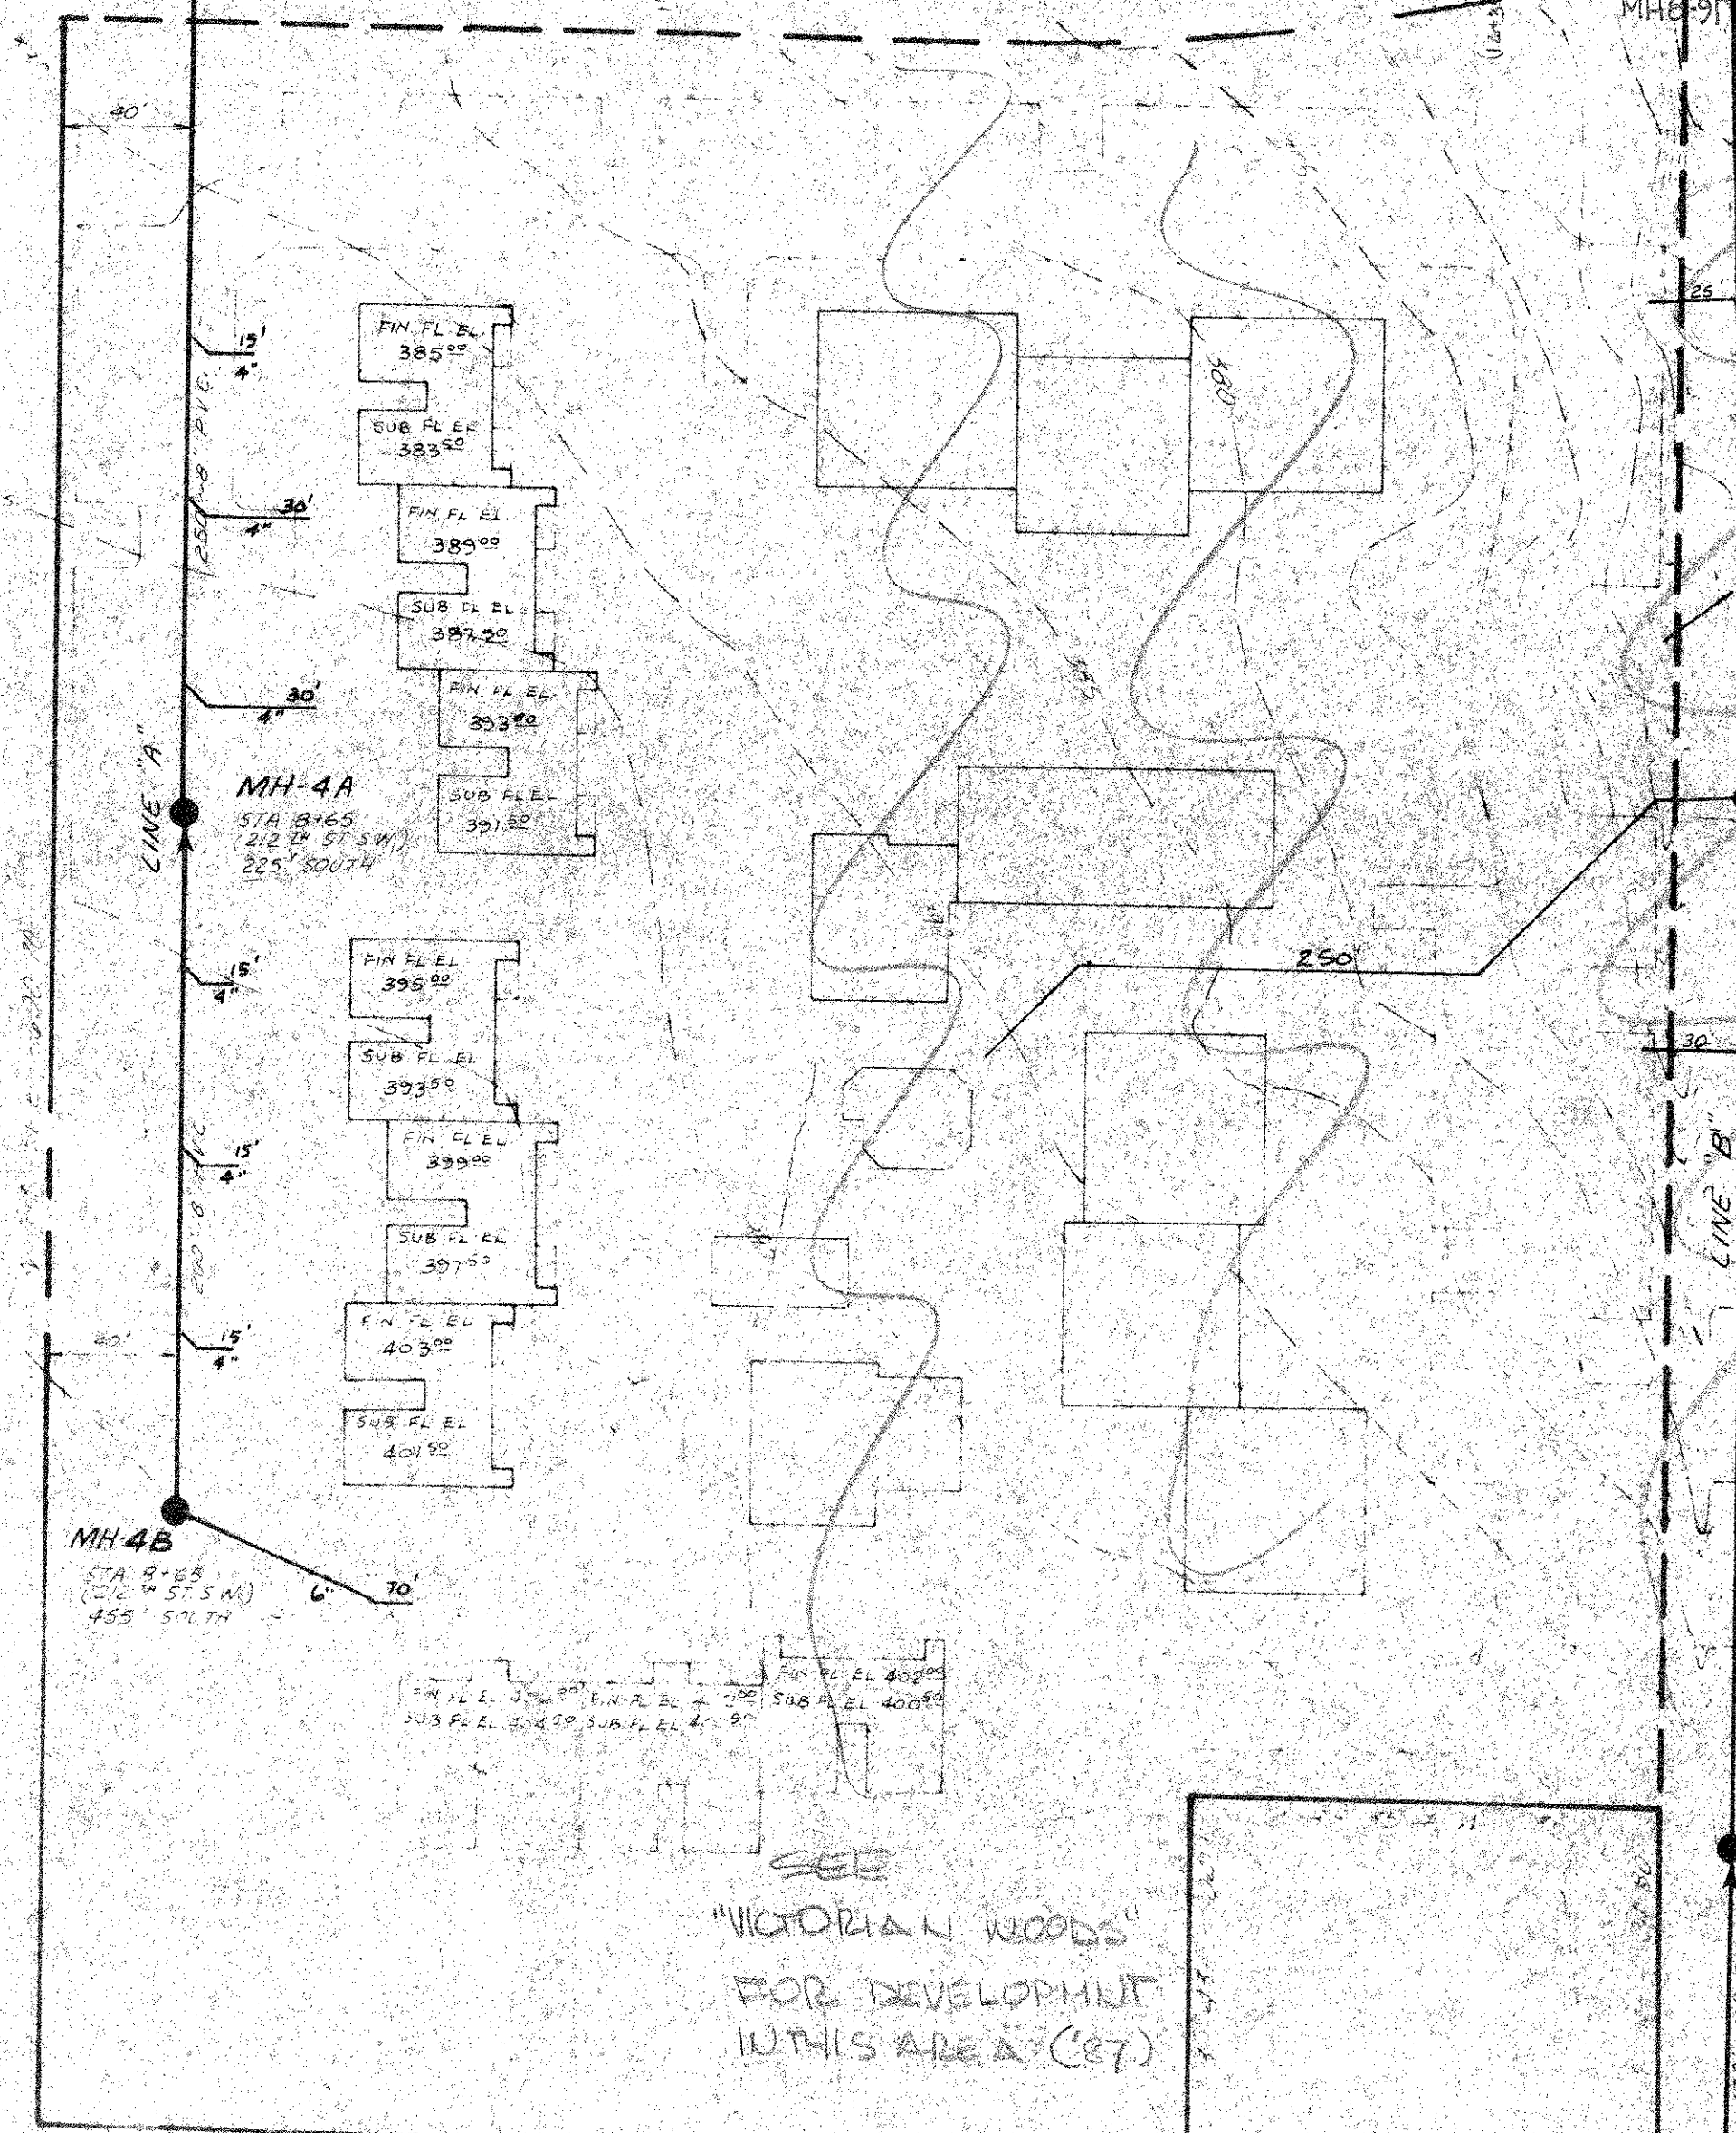

JOEL E. BRUCHMAN P.E.
12/13/80

SEWERAGE UNIT 8-9-A

77-80-2

WILDEMERE CONDOMINIUMS		J. B. FRIEL & COMPANY 9502 19 th AVENUE S.E., SUITE D EVERETT, WASHINGTON 98204	
FOR WILLIAM J. MURPHY, INC. MOUNTAIN TERRACE, WASHINGTON	DATE: JUNE, 1980	JOB NO. 80-1351	SHEET C2 OF C7
DR44W BY: PC	SANITARY SEWER PLAN		