


PROFILE		BY	DATE	IF		DATE	IN	DATE
SURVIVED		<i>DP</i>	<i>--</i>	TRACING CHECK	<i>L.H.</i>	<i>2-10-59</i>	REVISIONS	
PLOTTED		<i>DP</i>	<i>--</i>	GRADE CHECK	<i>DP</i>	<i>9-10-59</i>		
GRADES CHECKED				Sheet Cross Check	<i>E.A.</i>	<i>12-1-59</i>		
MANIFESTED				DESIGN CHECK	<i>C.M.</i>	<i>3-10-59</i>		
STRUCTURE NOT IN THIS CHFD								

PLAN	BY	DATE
SURVIVED	<i>DP</i>	<i>--</i>
PLOTTED	<i>DP</i>	<i>--</i>
NOTE BOOK		
ALIGNMENT CHECKED		
RT OF WAY CHECKED		
NO.		

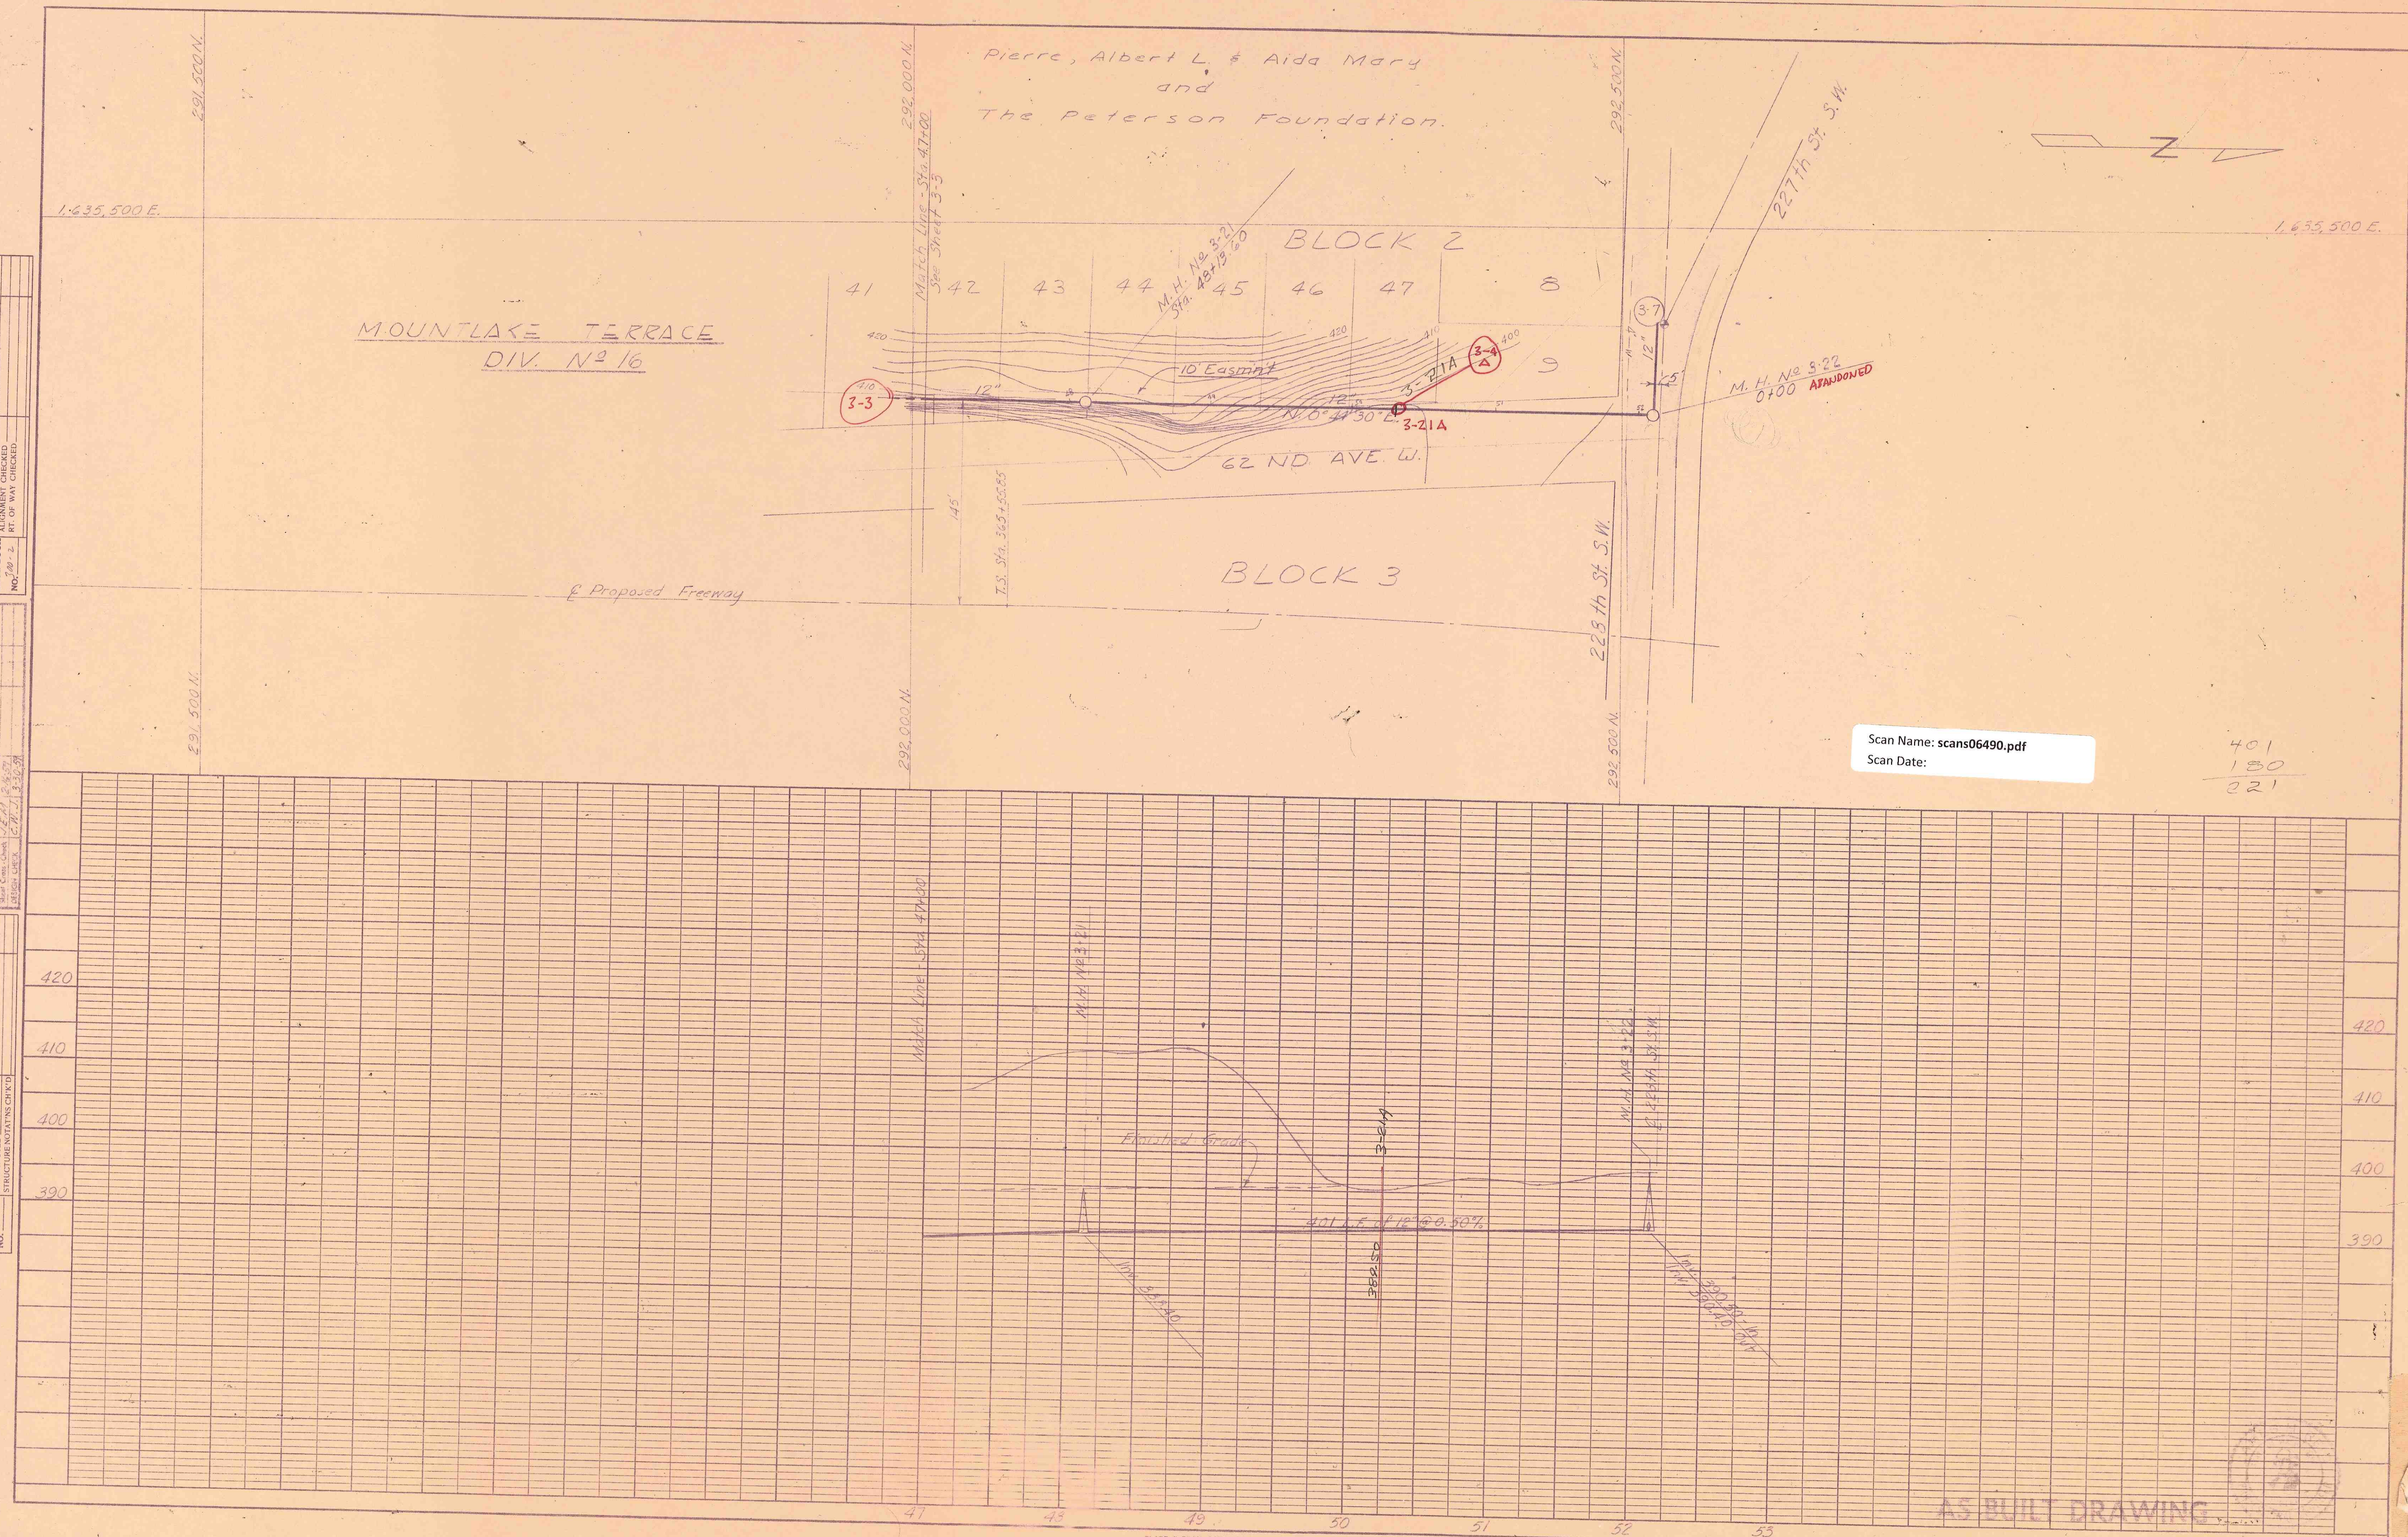

Scan Name: scans06490.pdf
Scan Date:

$$\begin{array}{r} 401 \\ 180 \\ \hline 221 \end{array}$$

AS BUILT DRAWING

JAMES H. REID & ASSOCIATES
CONSULTING ENGINEERS, 324 MAIN ST., EDMONDS, WASH.

DESIGN	DRAWN	CHECKED	DATE	H. SCALE 1"=30'	FILE NO. 5.50/3-4
L.N.	L.N.:J.M.	L.N.	3-30-59	V. SCALE 1"=10'	SHEET 4 OF 19
CITY OF MOUNTLAKE TERRACE SEWERAGE SYSTEM UNIT: 3					