



SIDE SEWER AS BUILT

CITY OF MOUNTLAKE TERRACE

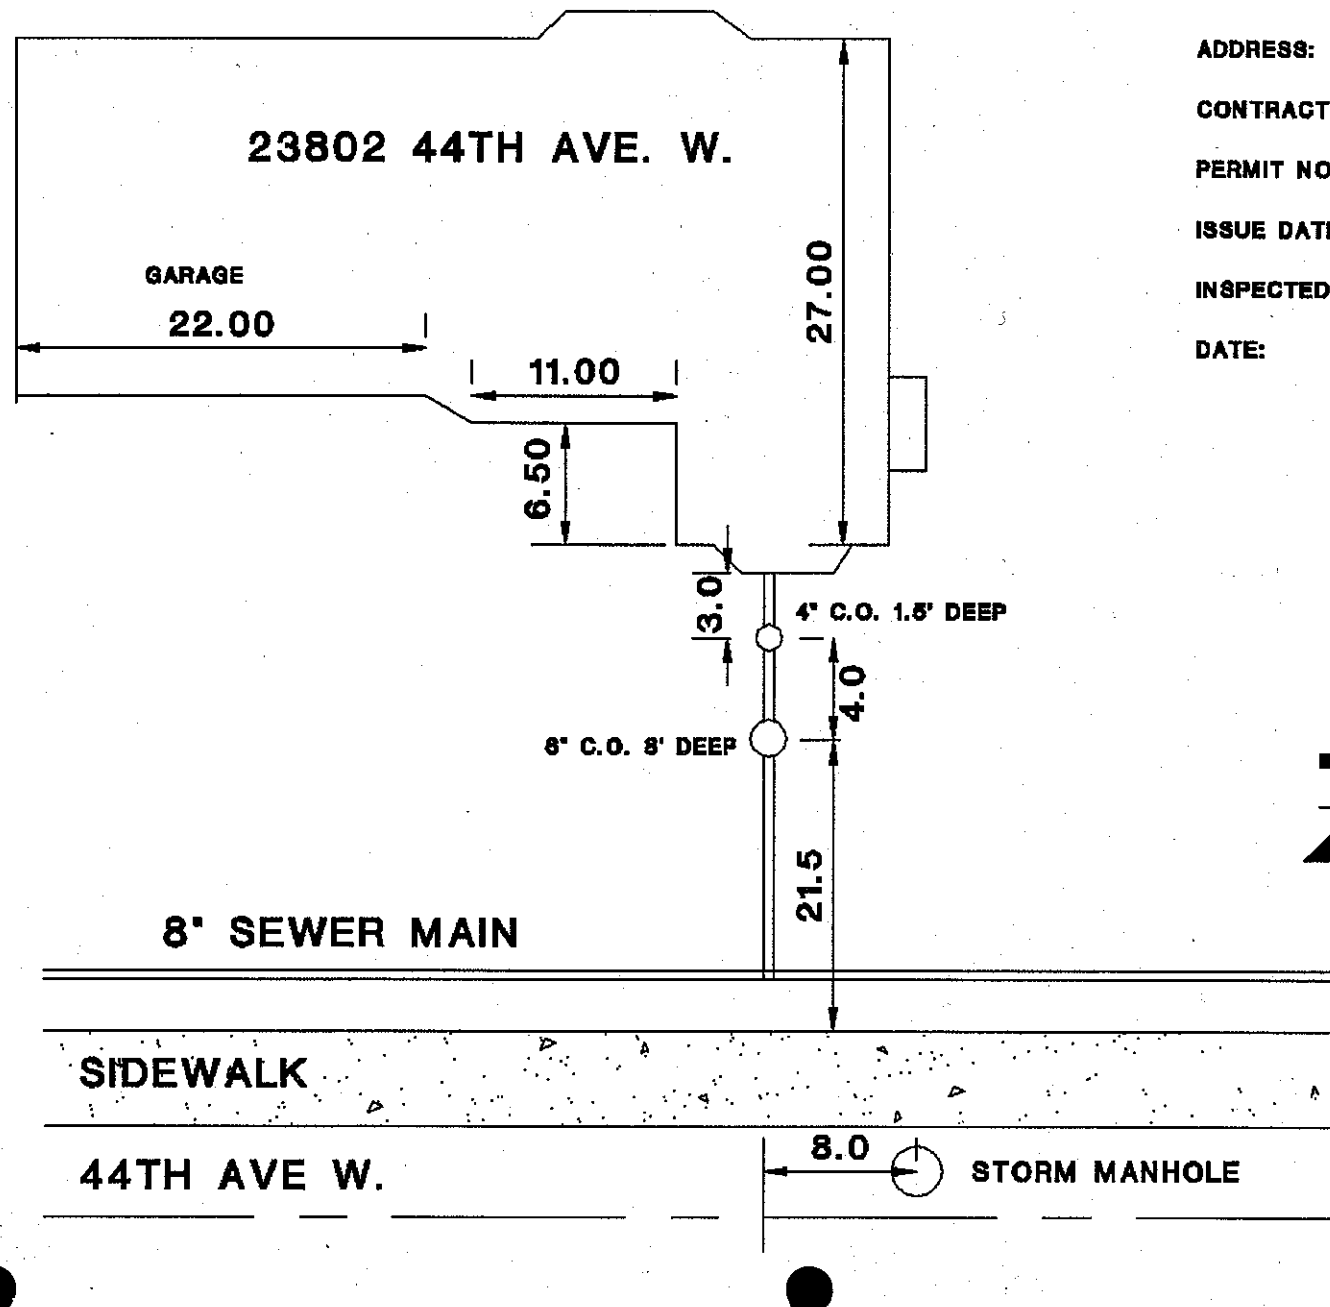

OWNER: SEABROOK DEVL
ADDRESS: 23802 44TH AVE
CONTRACTOR: LYNNWOOD SEPTIC
PERMIT NO.: U-92-10
ISSUE DATE: 1-17-92
INSPECTED BY: D.M.S.
DATE: 1-17-92

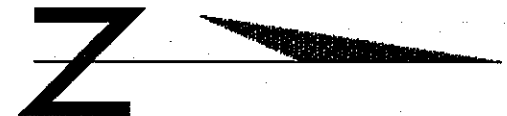

ll