


PLAN	DATE	BY
SURVEYED		
NOTED		
ALIGNED		
CHECKED		
RT. OF WAY CHECKED		
NO.		

PROFILE	DATE	BY
SURVEYED		
NOTED		
ALIGNED		
CHECKED		
RT. OF WAY CHECKED		
NO.		

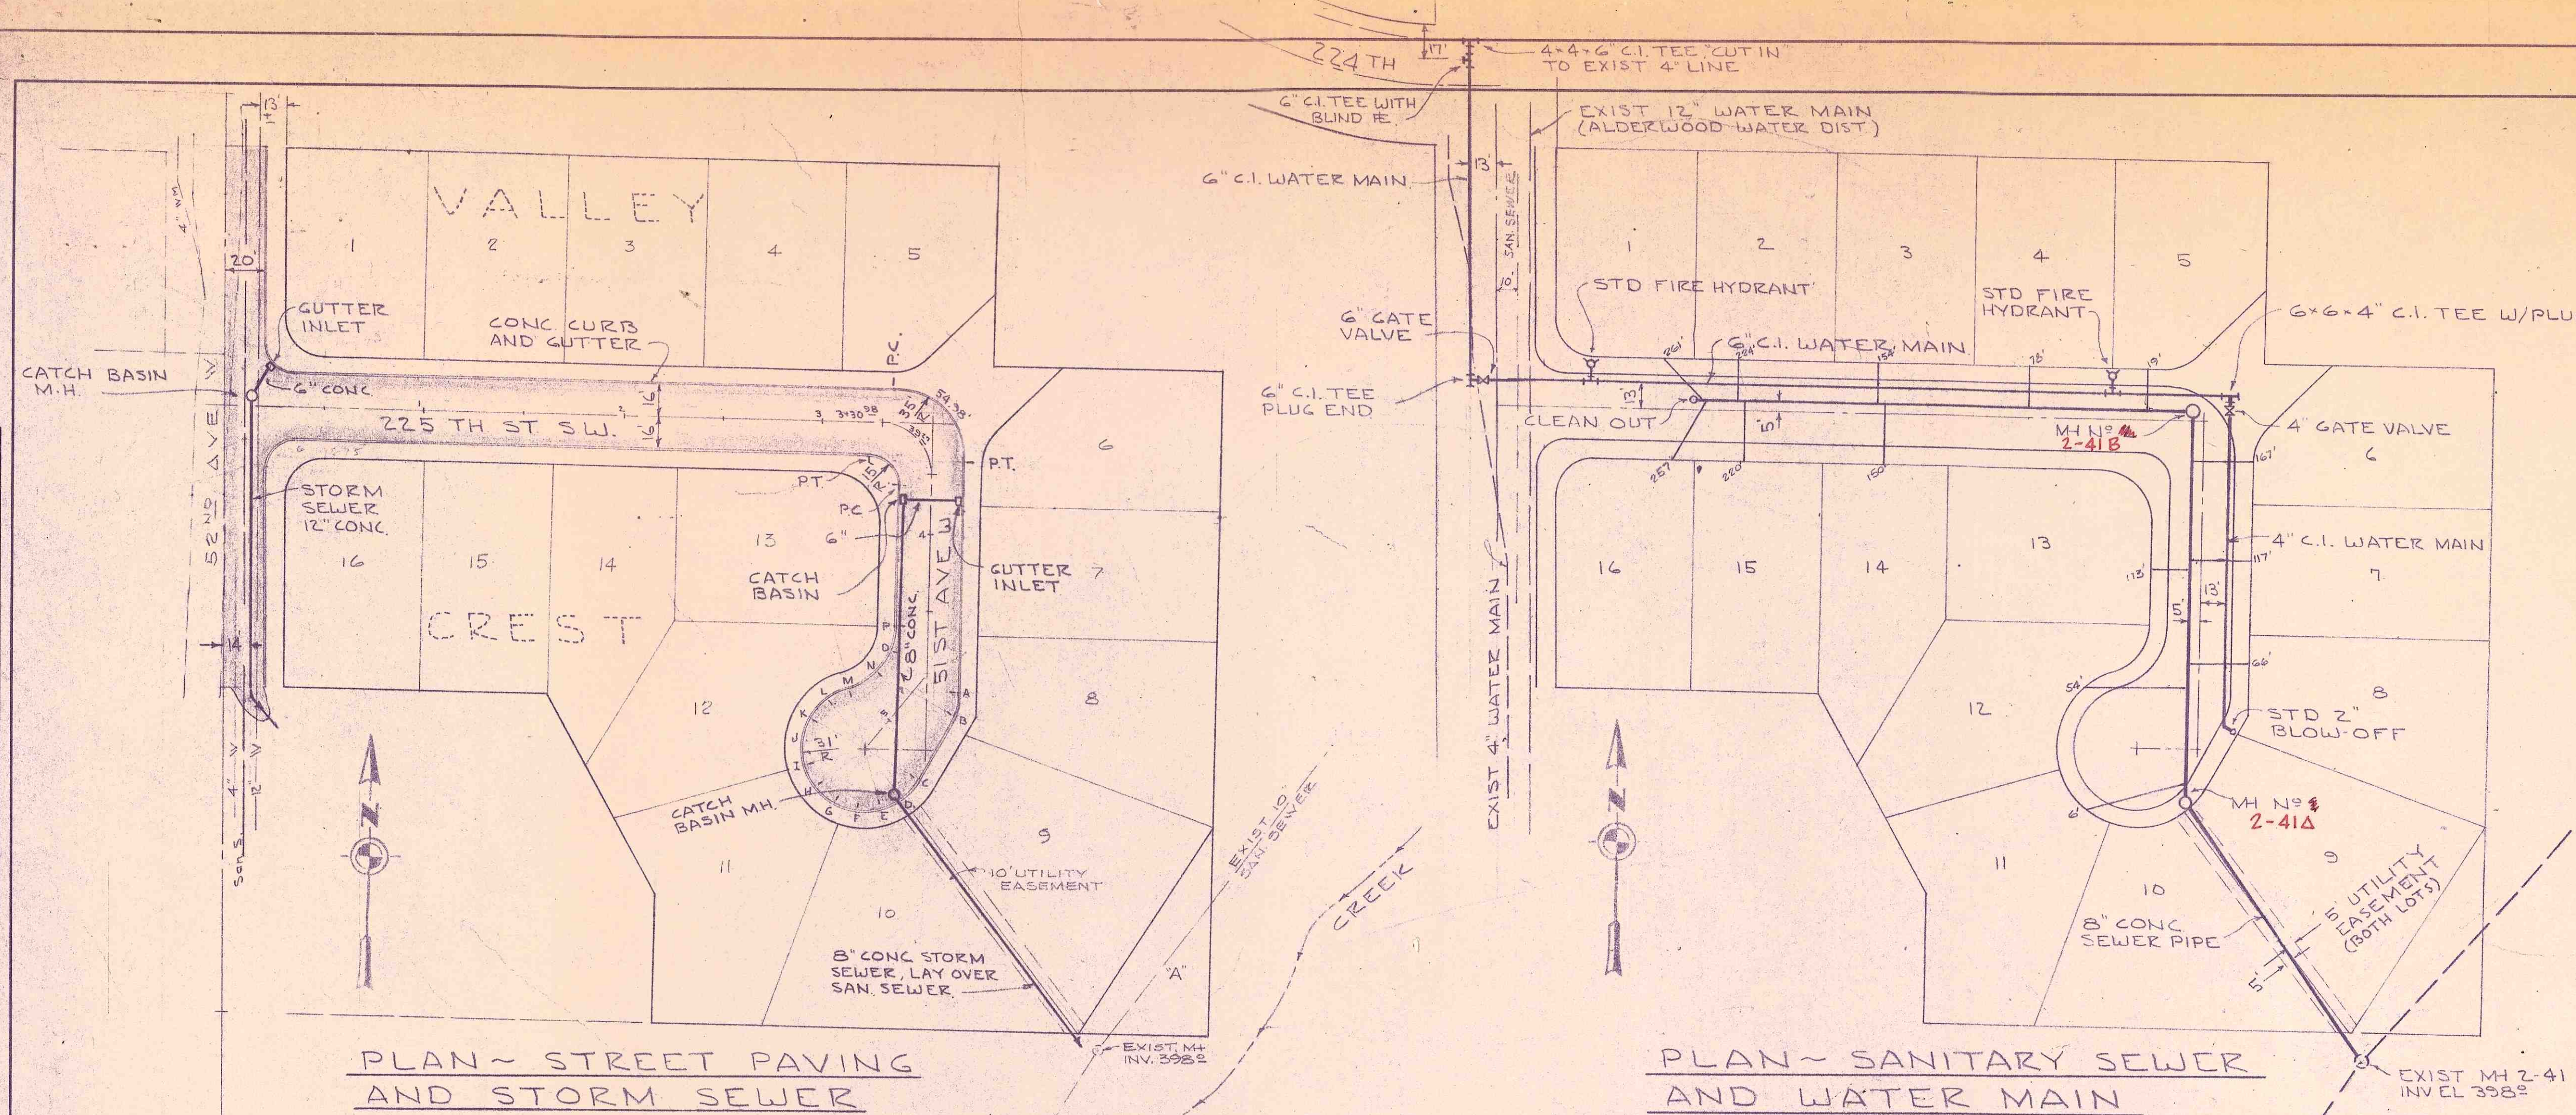

NOTE:
ALL UNDERGROUND UTILITIES ARE
SHOWN ACCORDING TO AVAILABLE
PUBLIC RECORDS. IT SHALL BE THE
CONTRACTORS RESPONSIBILITY TO
VERIFY EXISTENCE & LOCATION.

Scan Name: scans06313.pdf
Scan Date:

NO.	REVISIONS	DATE	BY
1	LOWER STREET & RELOCATE STORM SEWER	JULY 5, 1961	KCT
CITY OF MOUNTLAKE TERRACE			
VALLEY CREST			
STREET GRADES & UTILITIES			
REID, MIDDLETON & ASSOCIATES, INC.			
CONSULTING ENGINEERS & LAND SURVEYORS			
324 MAIN STREET EDMONDS, WASHINGTON			
FILE NO.	5174		
SHEET	OF		

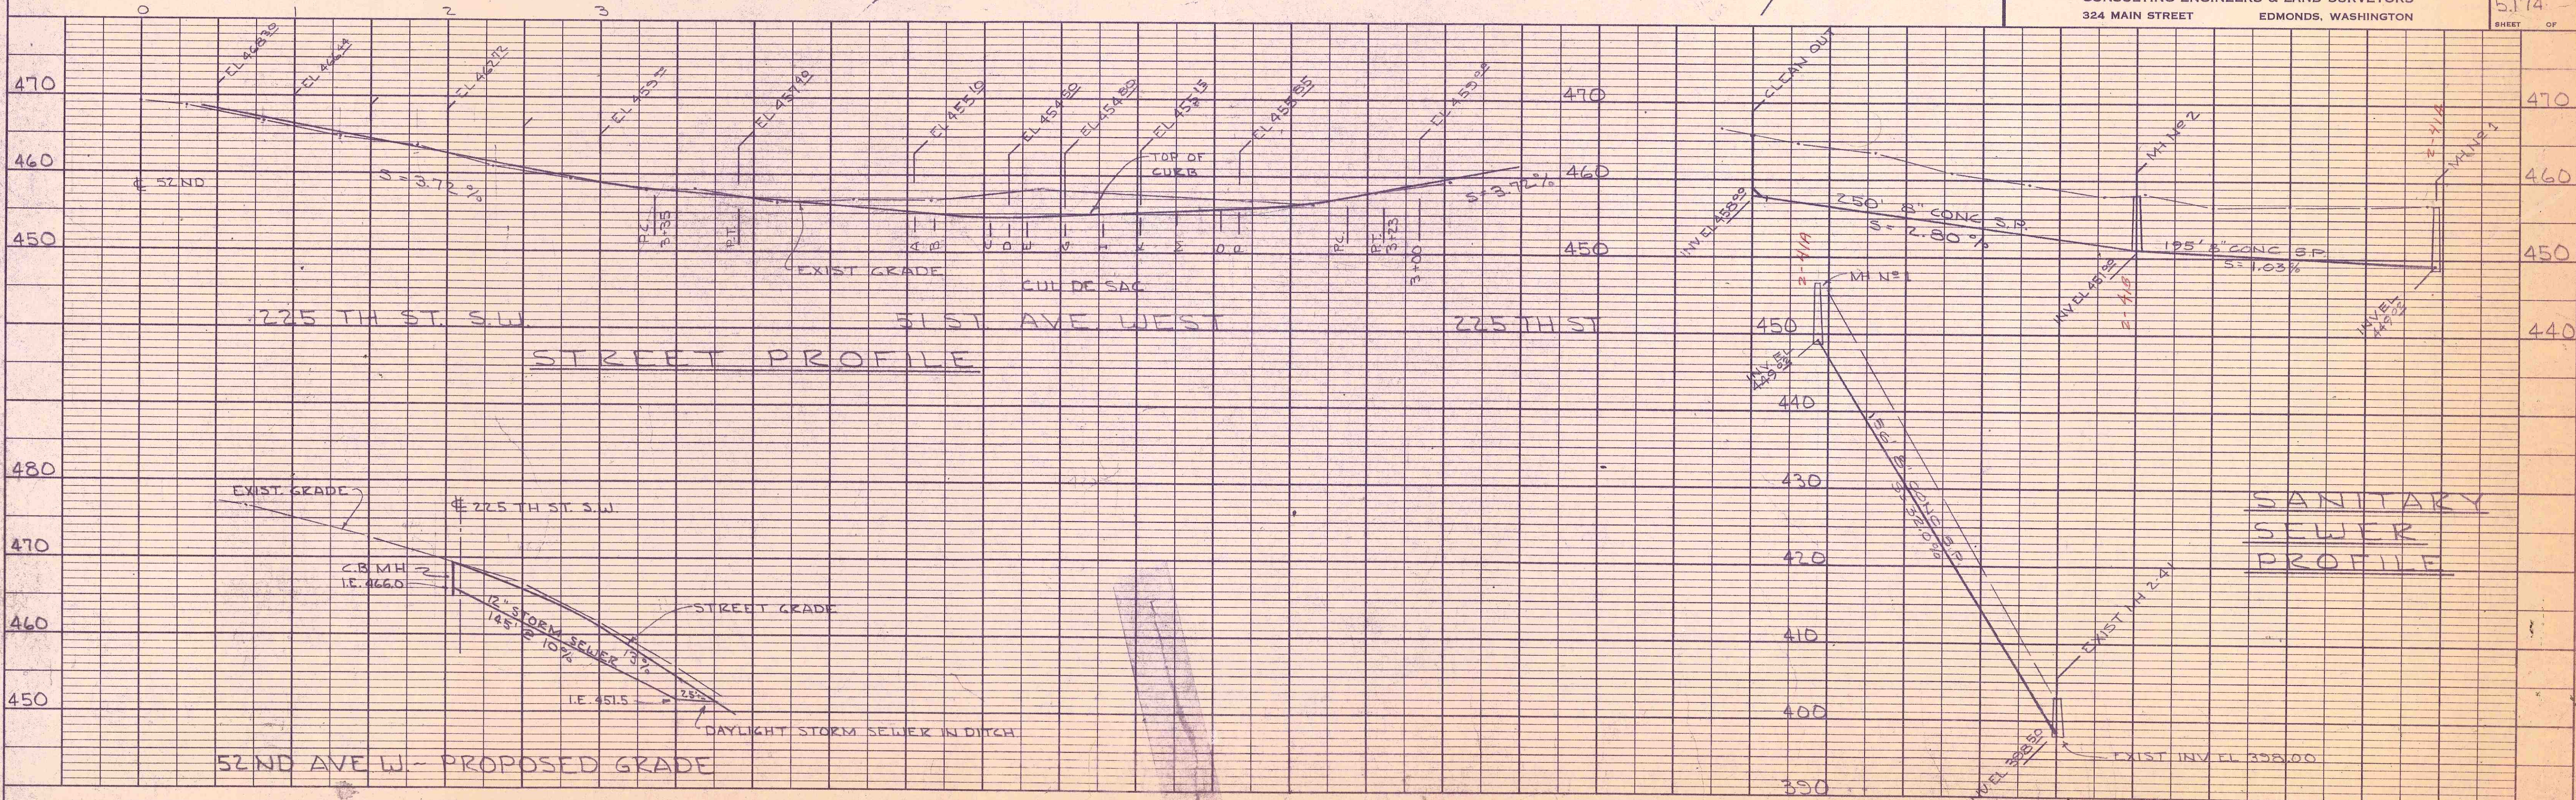


PLATE 1 - PLAN-PROFILE D.P.R. & R.E. STANDARD
AGEPROOF VELLUM - MADE AND PRINTED IN U.S.A.
EUBENE DIETZGEN CO.

AS BUILT DRAWING
2-12-A