

The City of Mountlake Terrace

APPLICATION

for

SIDE SEWER PERMIT

OUTSIDE ☒ INSIDE ☐ REPAIRS ☐

CARD No.

EASEMENT No. 235 P1P5

OWNER BERNARD R. DESMOND

CONTRACTOR HOME

PERMIT No. 2311


HOUSE No. 22504 60TH W

STREET  
AVENUE LOT No. 12

BLOCK No. 2

NAME ADD. DIVISION 25

*71 1/2' W of house  
9 1/2' E of PL  
19 1/2' N of sewer Main  
c/o location in meter lot  
60TH AVE. W = 30'*

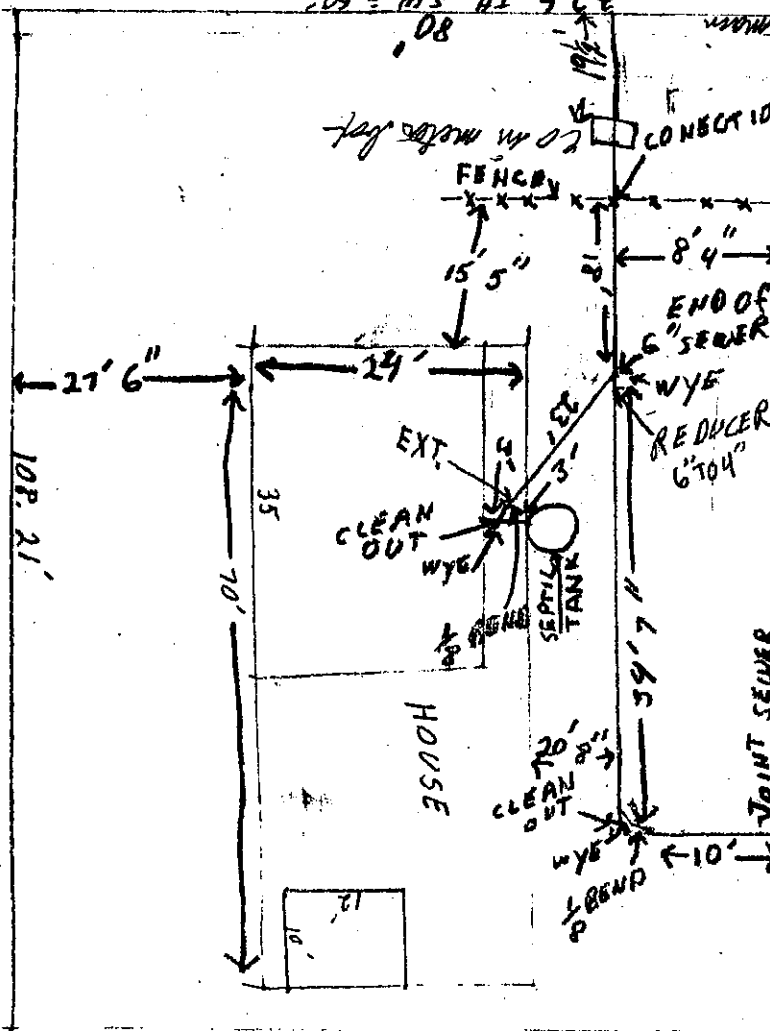

CITY OF  
MOUNTLAKE TERRACE

APR 5 1960

Plan Approved

*to 6009-225th P15W*

BACKFILL WORK ORDER ISSUED

DEPOSIT, 10.00 3/30/60

SEWER WORK ORDER ISSUED

Approved:

DATE 4/5/60

BY