

The City of Mountlake Terrace

APPLICATION

for

SIDE SEWER PERMIT

OUTSIDE ☐ INSIDE ☐ REPAIRS ☐


CARD No. _____

EASEMENT No. _____

OWNER WILLIAM TURK, JR. CONTRACTOR _____ PERMIT No. 4-3-73

HOUSE No. 24009 54TH W STREET _____ AVENUE LOT No. _____ BLOCK No. _____

NAME ADD _____

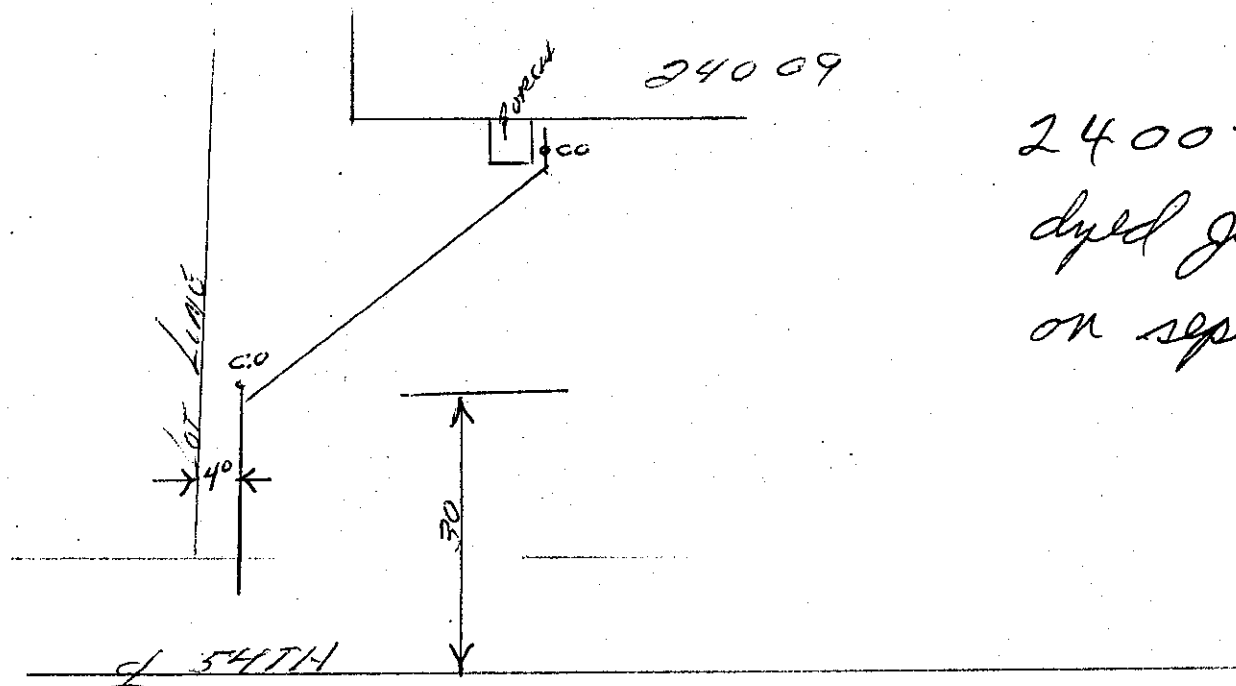

24007-54
dyed July 1991
on septic

Date _____

Approved: _____

BACKFILL WORK ORDER ISSUED _____ DEPOSIT, \$ _____

SEWER WORK ORDER ISSUED _____ DATE _____ BY _____