

APPLICATION

CARD No. _____

The City of Mountlake Terrace

for SIDE SEWER PERMIT

EASEMENT No. _____

H & R Homes P O Box 644 Lynnwood, Wash 98036

CONTRACTOR Universal Utility Contractors Inc.

PERMIT No. 74-18

OWNER _____

CONTRACTOR 11411 203rd St N E Woodenville


HOUSE No. 22213-62 TH PL W

STREET 13
AVENUE LOT No. _____

BLOCK No. _____

NAME ADD Greenridge

Side Sewer Permit No U-26-75 issued 3-21-75 to Lynnwood Septic Tank Co.
Installed, inspected, accepted and asbilt made 3/21/75 *JH Smith*

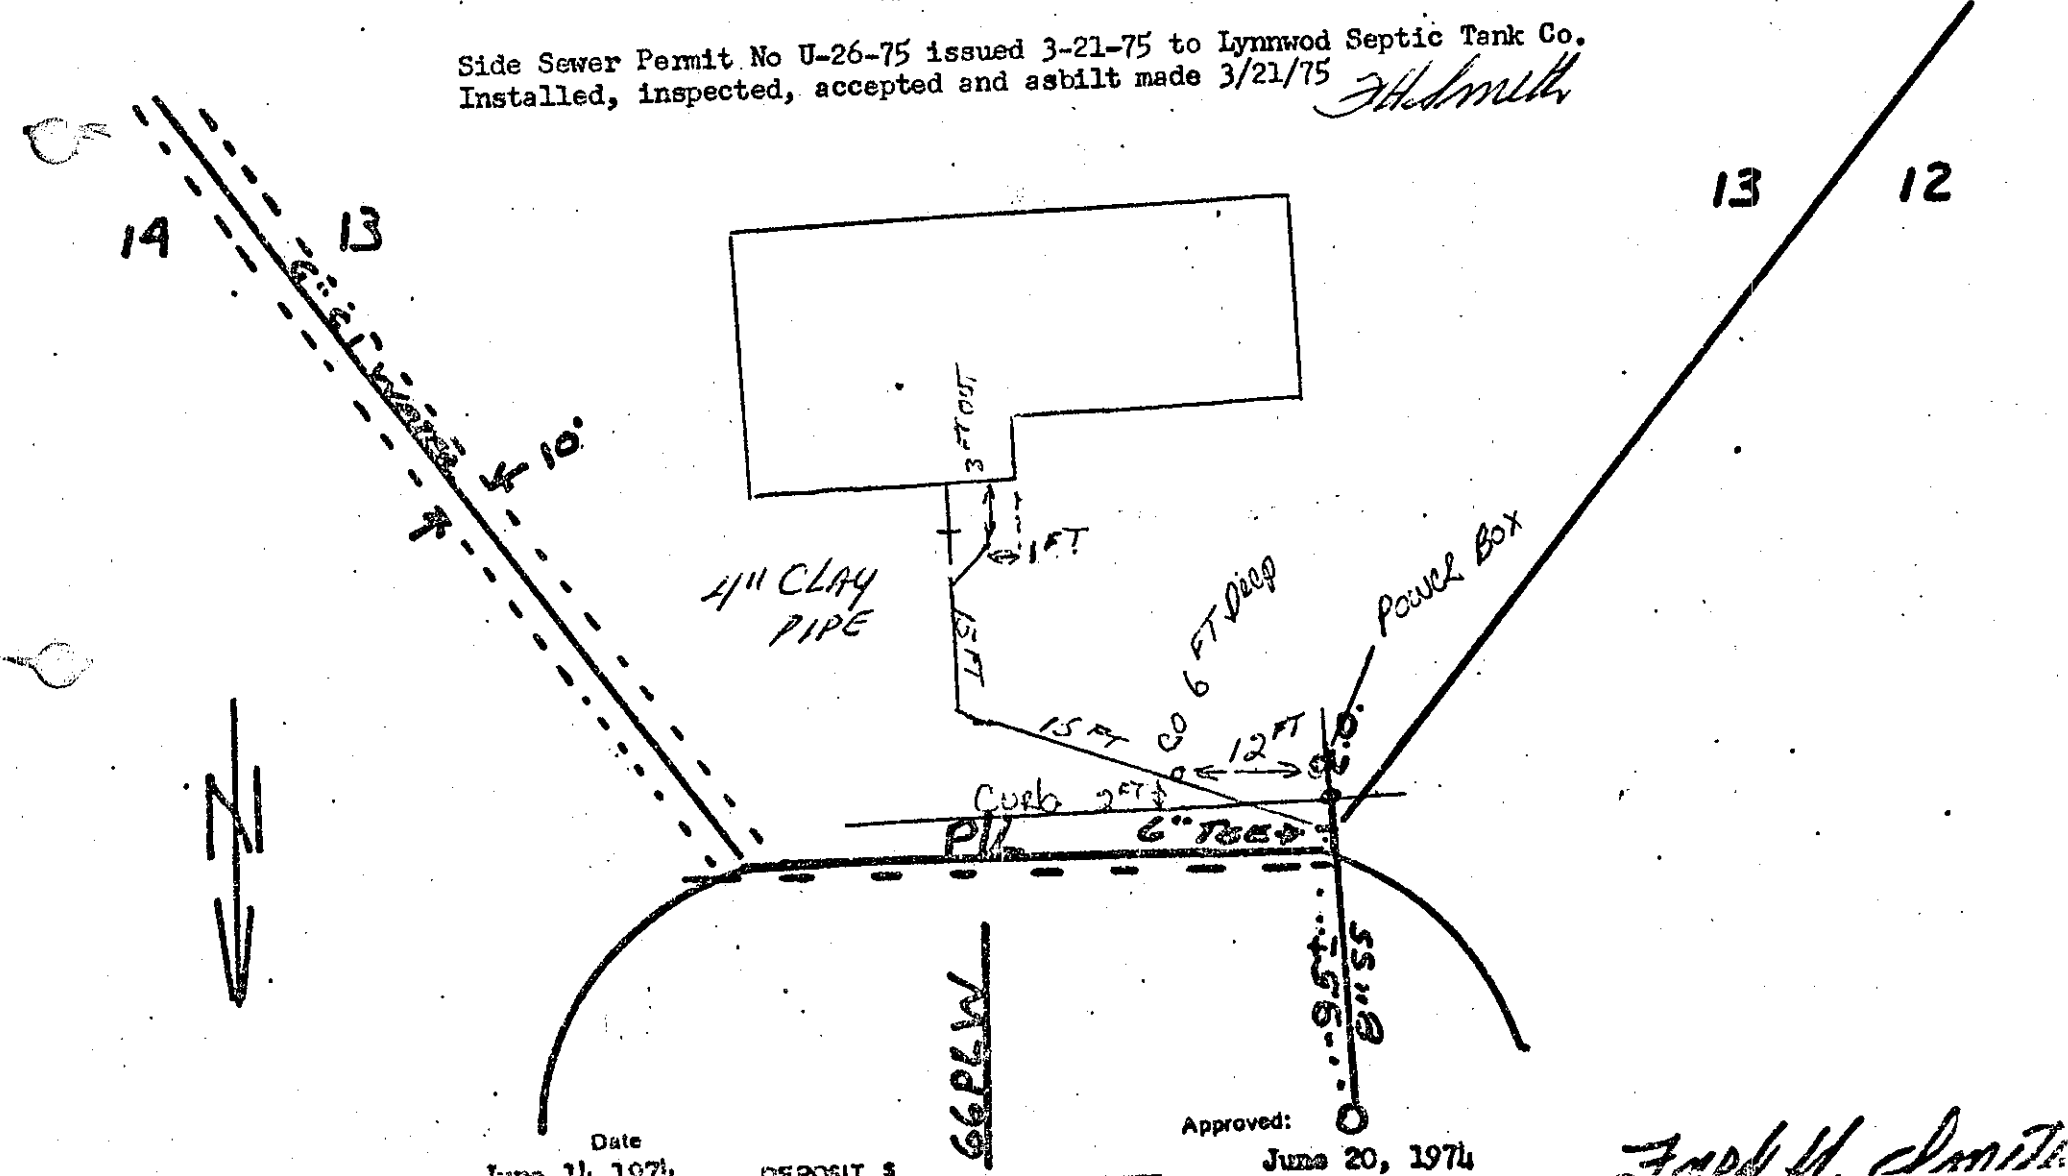

Date June 20, 1974

DEPOSIT. \$ _____

Approved: _____

June 20, 1974

JH Smith