

The City of Mountlake Terrace

APPLICATION

for

SIDE SEWER PERMIT

OUTSIDE ☒ INSIDE ☐ REPAIRS ☐

EASEMENT No. _____

OWNER FRED D HUDDLESTEN

CONTRACTOR SELF

PERMIT No. 2188


HOUSE No. 22909 W 53RD

STREET
AVENUE LOT No. 14

BLOCK No. 2

NAME ADD. D. J. 12

EXISTING SEPTIC TANK

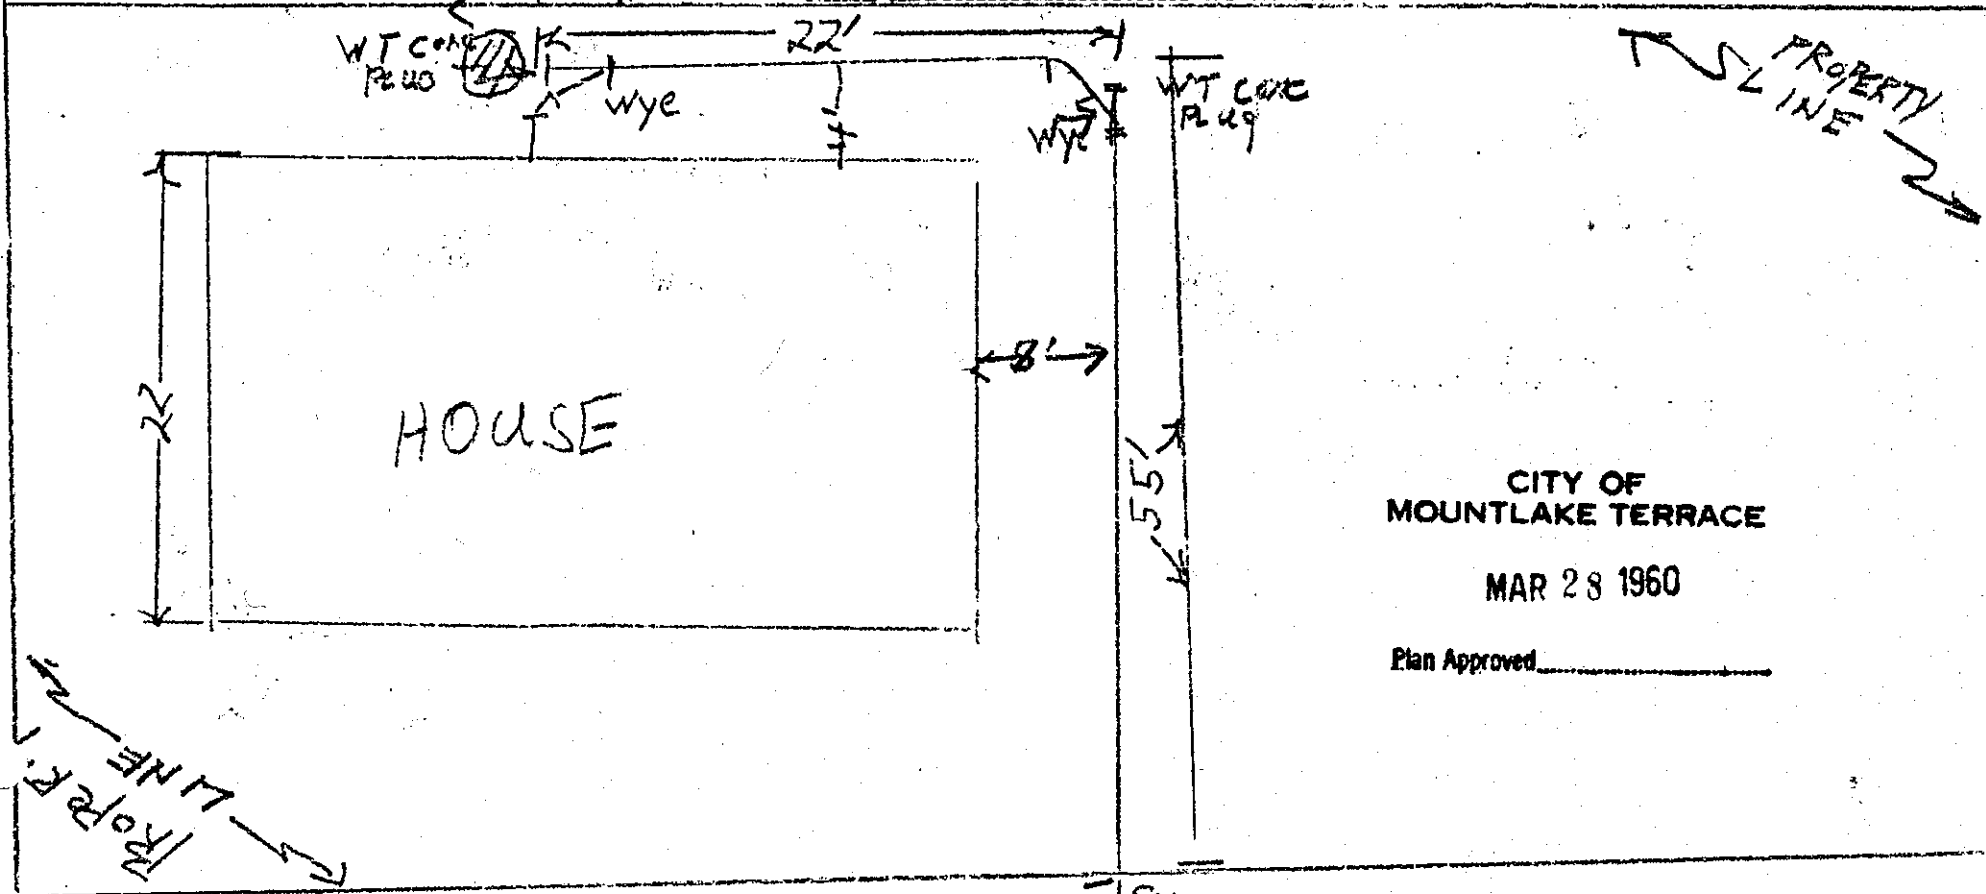

CITY OF
MOUNTLAKE TERRACE

MAR 28 1960

Plan Approved _____

SEWER MAIN

Date

BACKFILL WORK ORDER ISSUED _____

DEPOSIT, \$ 10.00

Approved:

SEWER WORK ORDER ISSUED _____

1002

DATE 3-29-60

BY Scott M. Kellon