


SURVEYED	BY	DATE
PLOTTED	<i>B.B.</i>	<i>11-10-58</i>
GRADES CHECKED		
NO. <i>18J - 58-64B. M. 3 NOTED.</i>		
STRUCTURE NOTAT'NS CH'IT'D <i>442-45</i>		

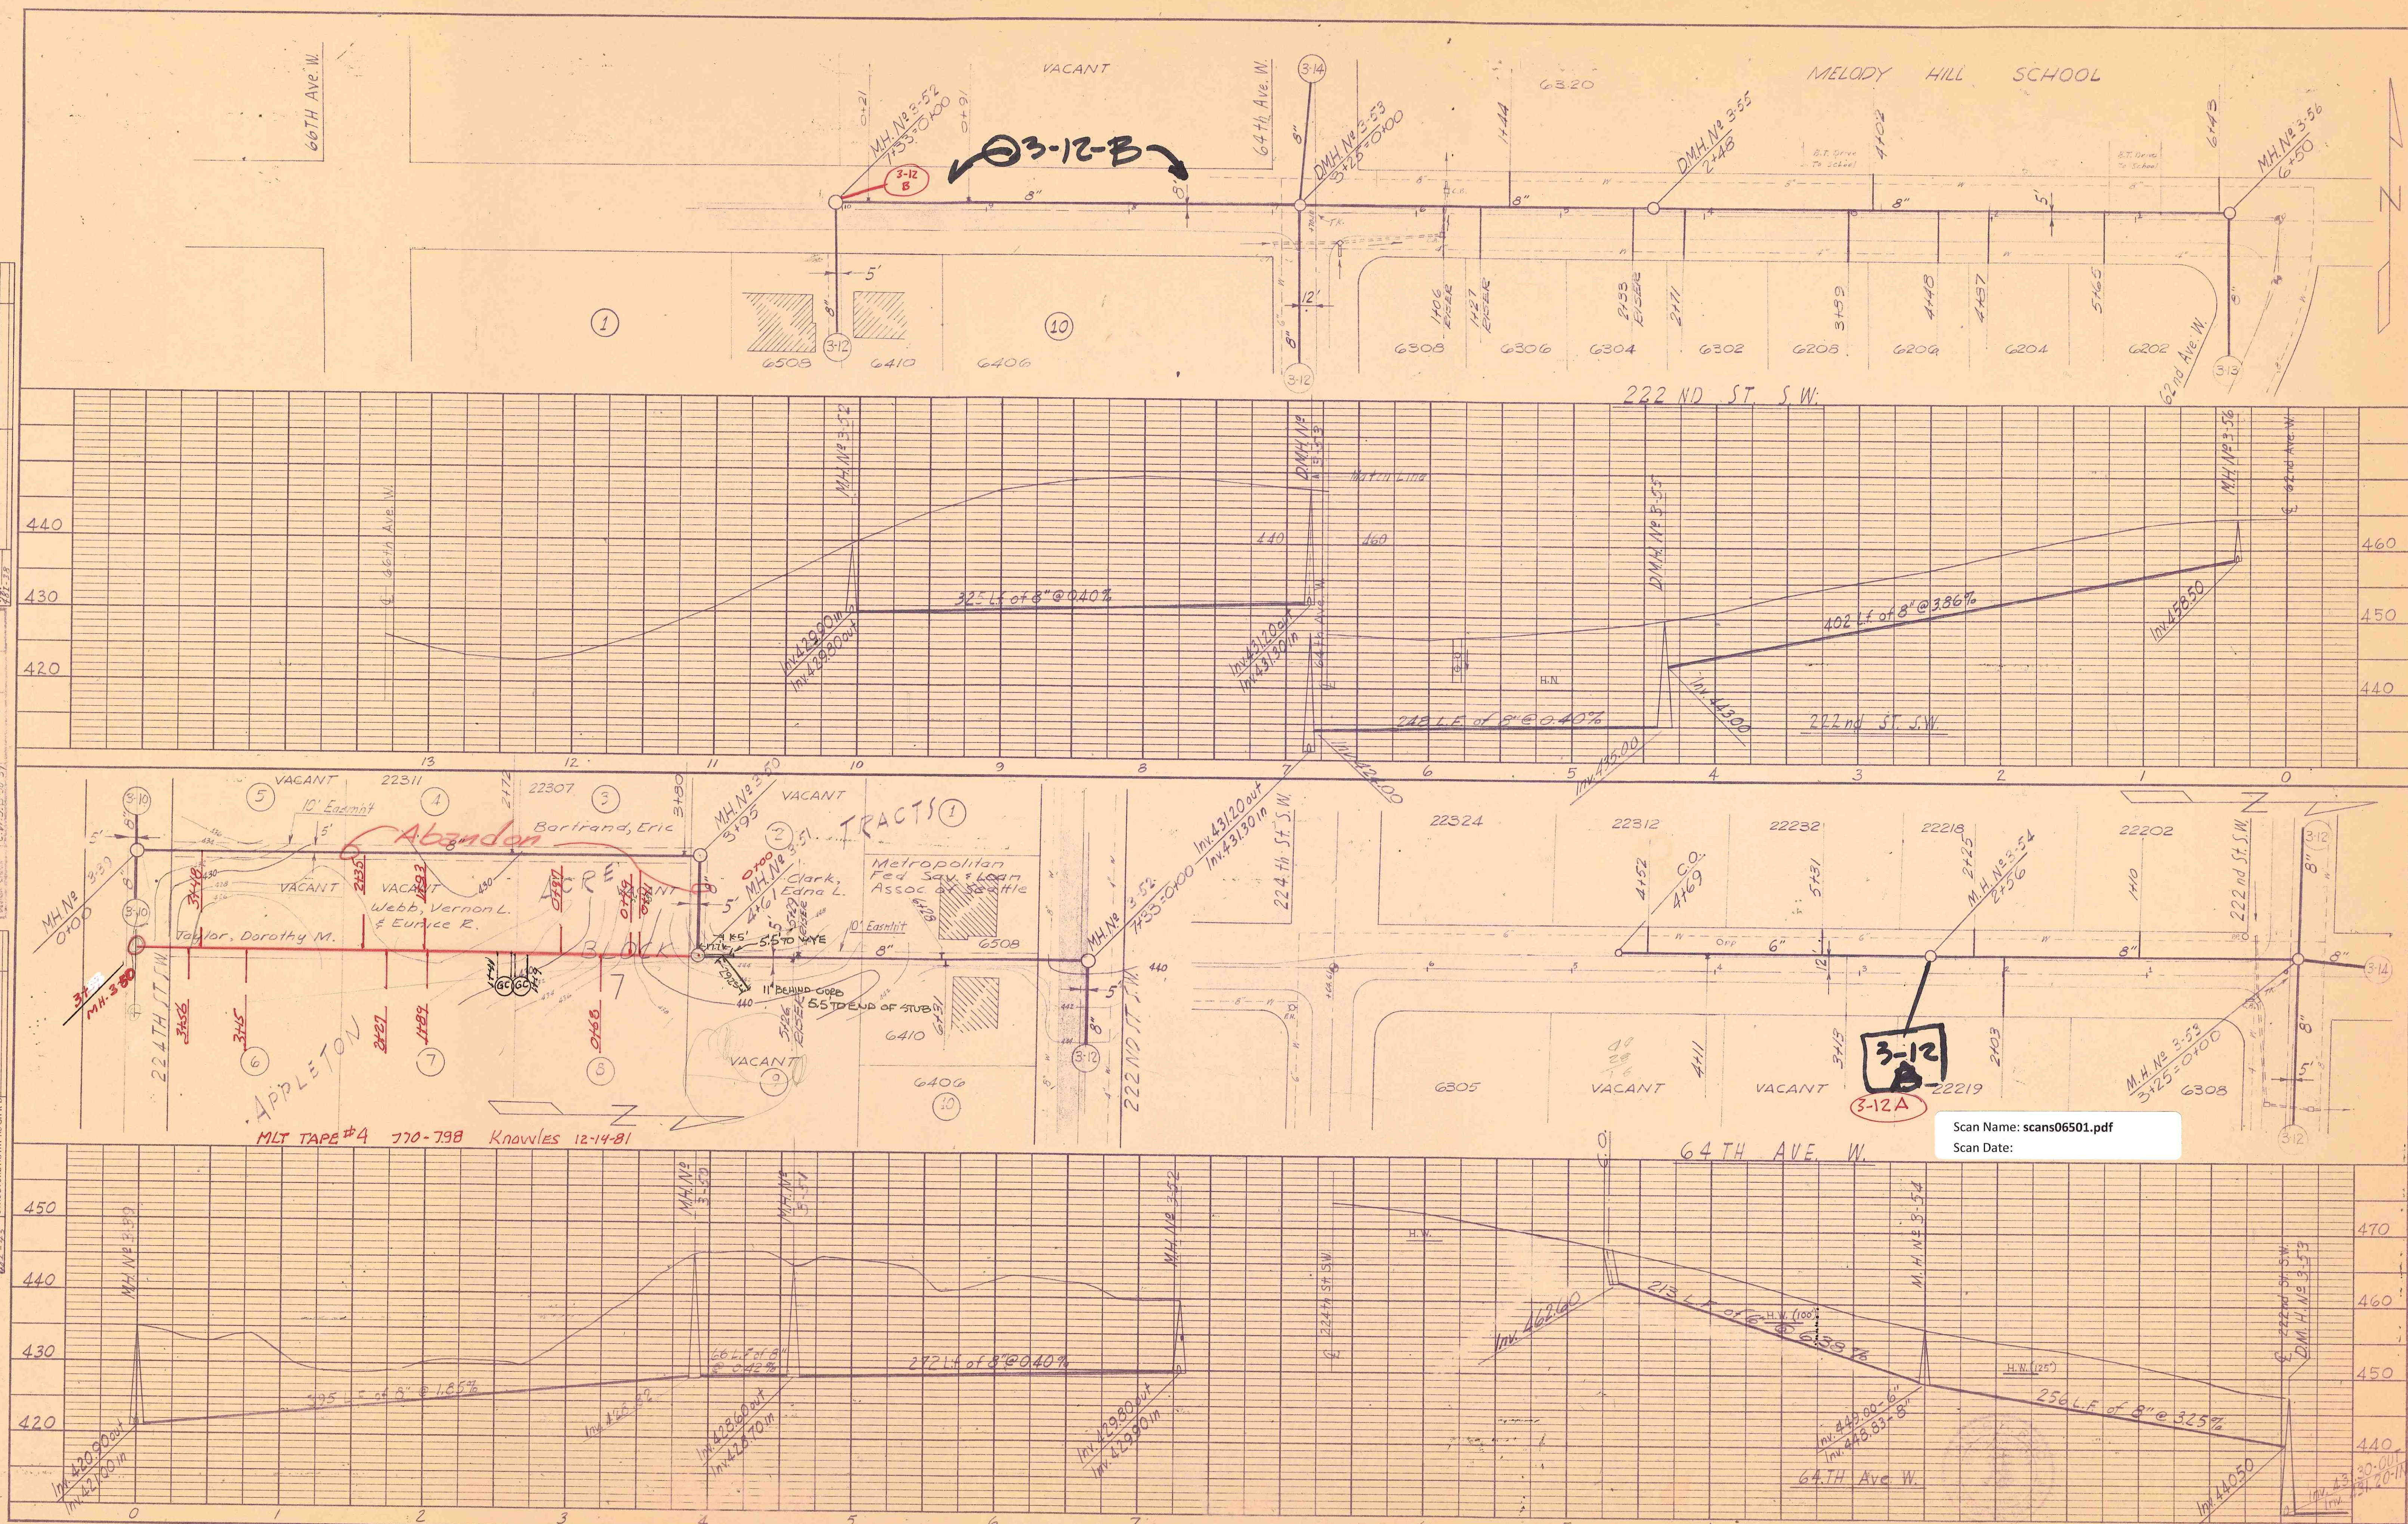

Scan Name: scans06501.pdf  
Scan Date:

AS BUILT DRAWING