




PLAN SCALE 1"=40'  
VERT SCALE 1"=5'

MADE IN U.S.A.  
CITY OF MOUNTLAKE TERRACE  
ENGINEERING DEPARTMENT

MADE IN U.S.A.  
CITY OF MOUNTLAKE TERRACE  
ENGINEERING DEPARTMENT

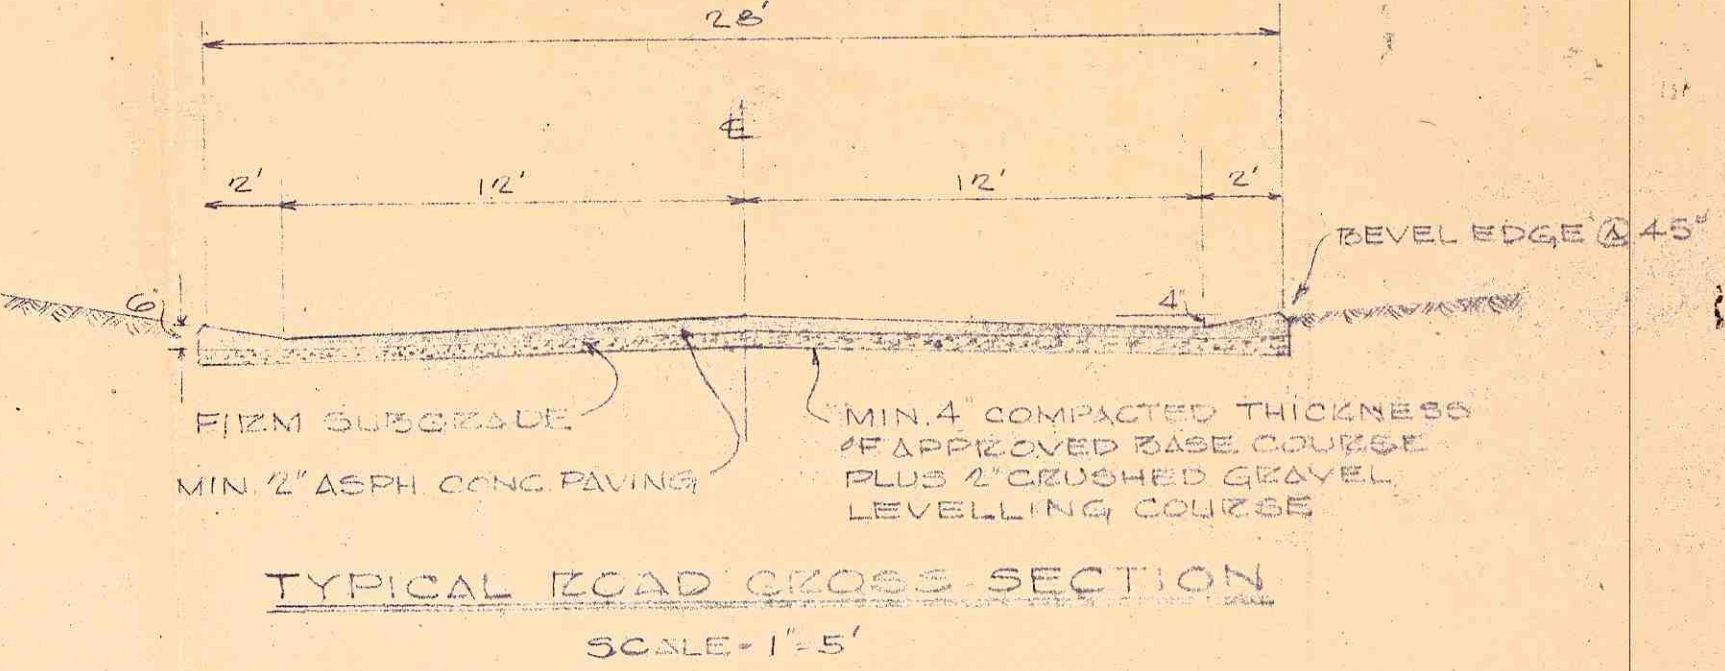


Scan Name: scans06537.pdf  
Scan Date:

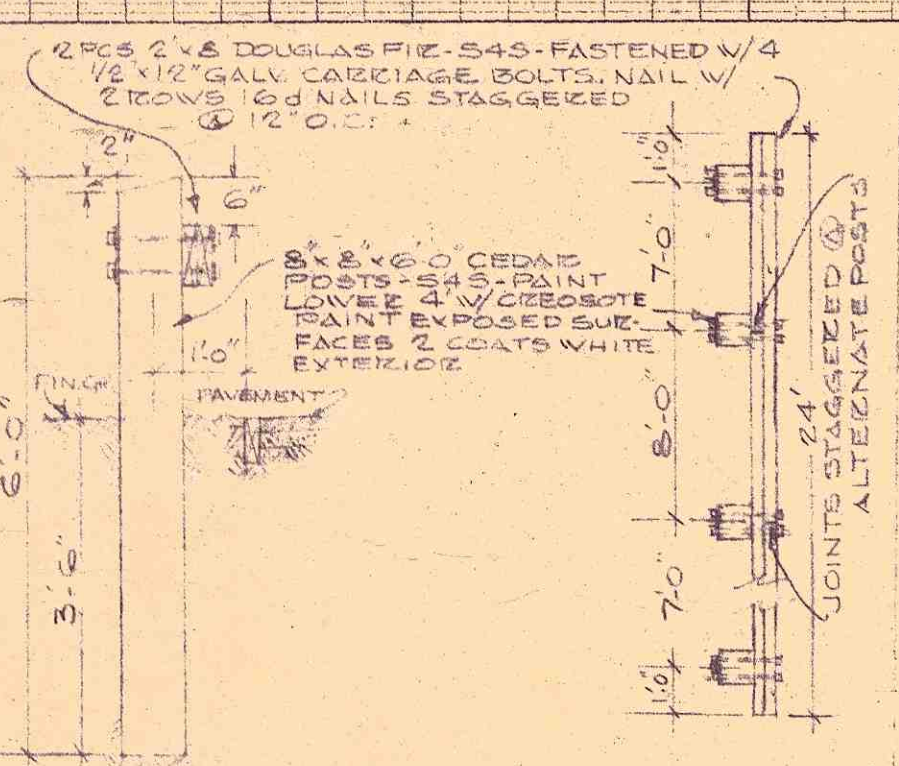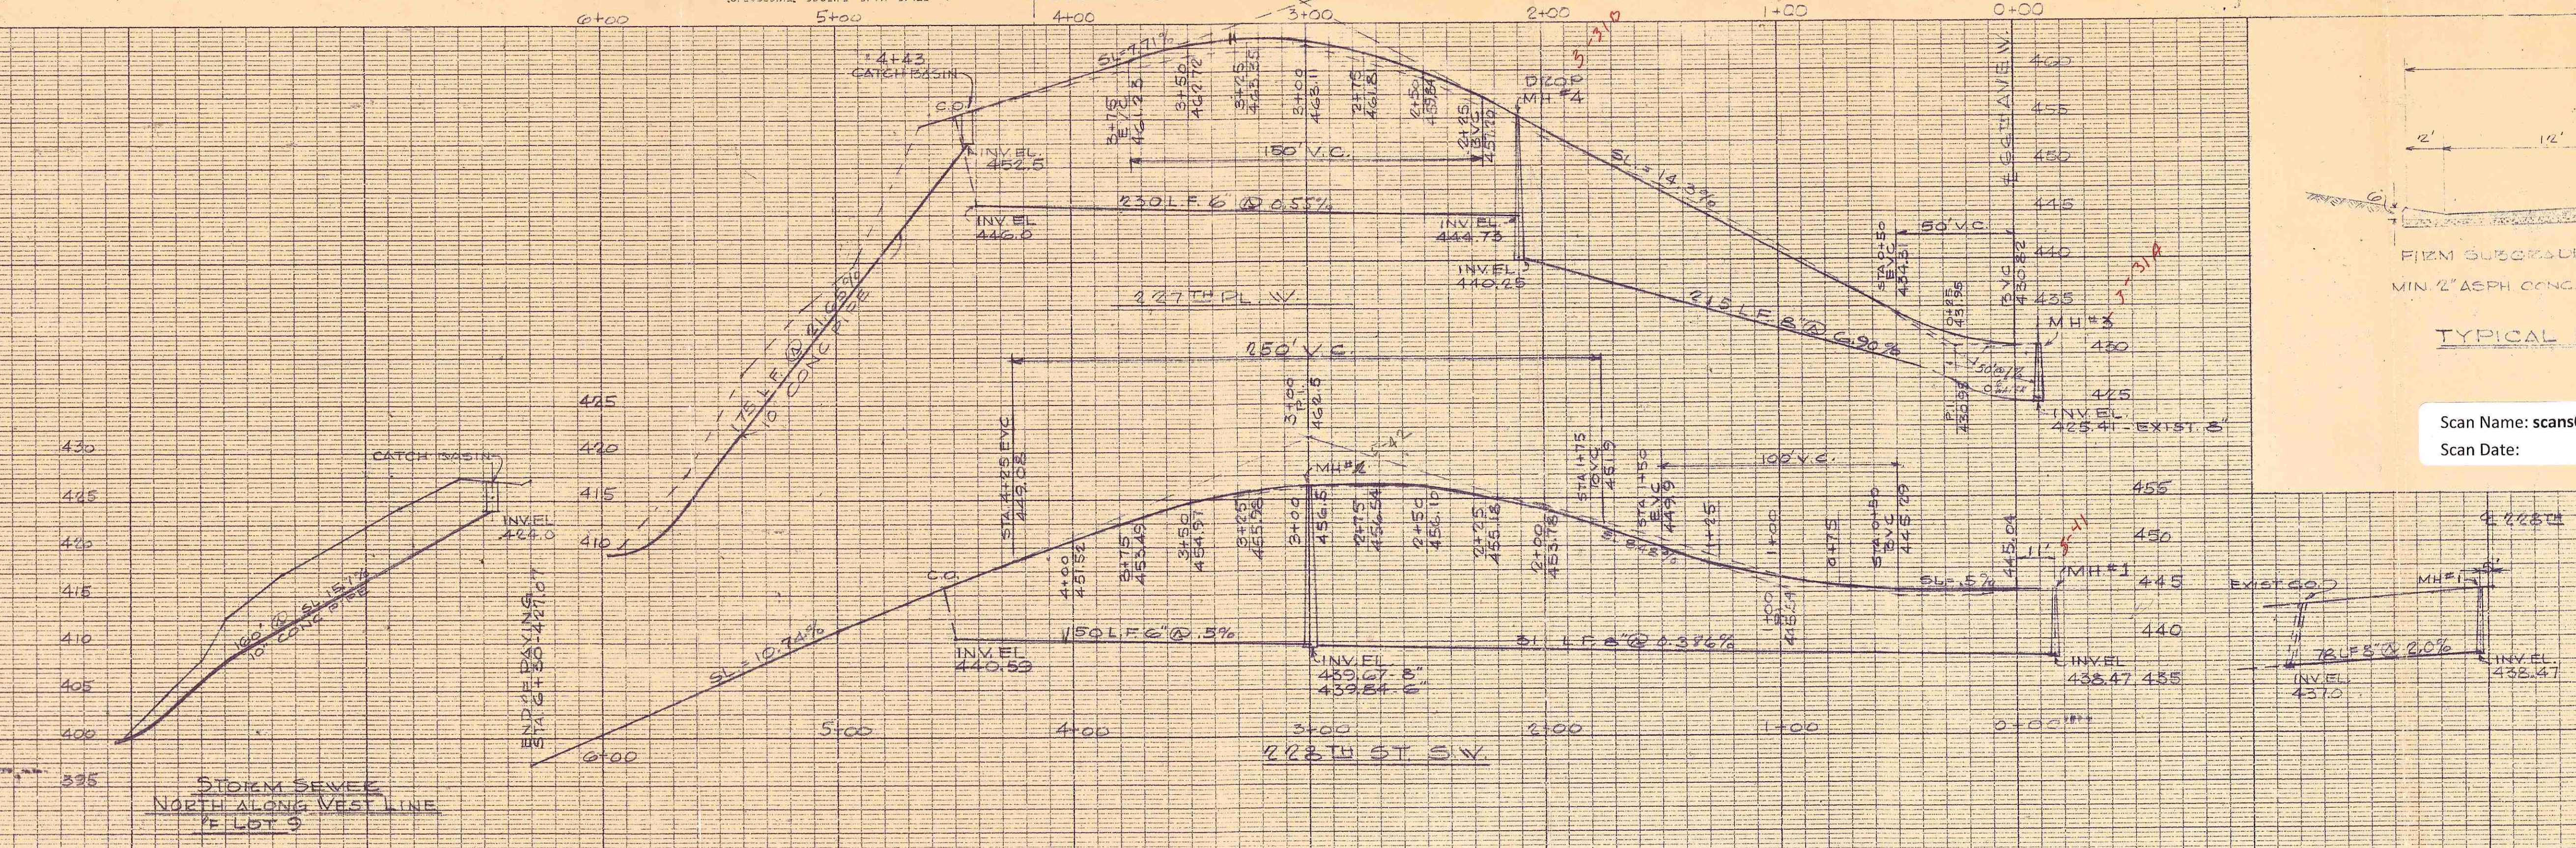

DETAILS OF STREET BARRICADE  
SCALE 1/2"=1'-0"

NOTE:  
1. STORM & SANITARY SEWERS SHALL BE CONSTRUCTED IN ACCORDANCE WITH SPECIFICATIONS FOR COMPREHENSIVE SEWERAGE PROJECT FOR CITY OF MOUNTLAKE TERRACE.  
2. CAST IRON PIPE SHALL BE CLASS 150 MECHANICAL JOINT TYPE WITH JOINTS COATED OUTSIDE & LINED INSIDE WITH LEAD-COATED CEMENT LINING NOT LESS THAN 1/16" THICK.

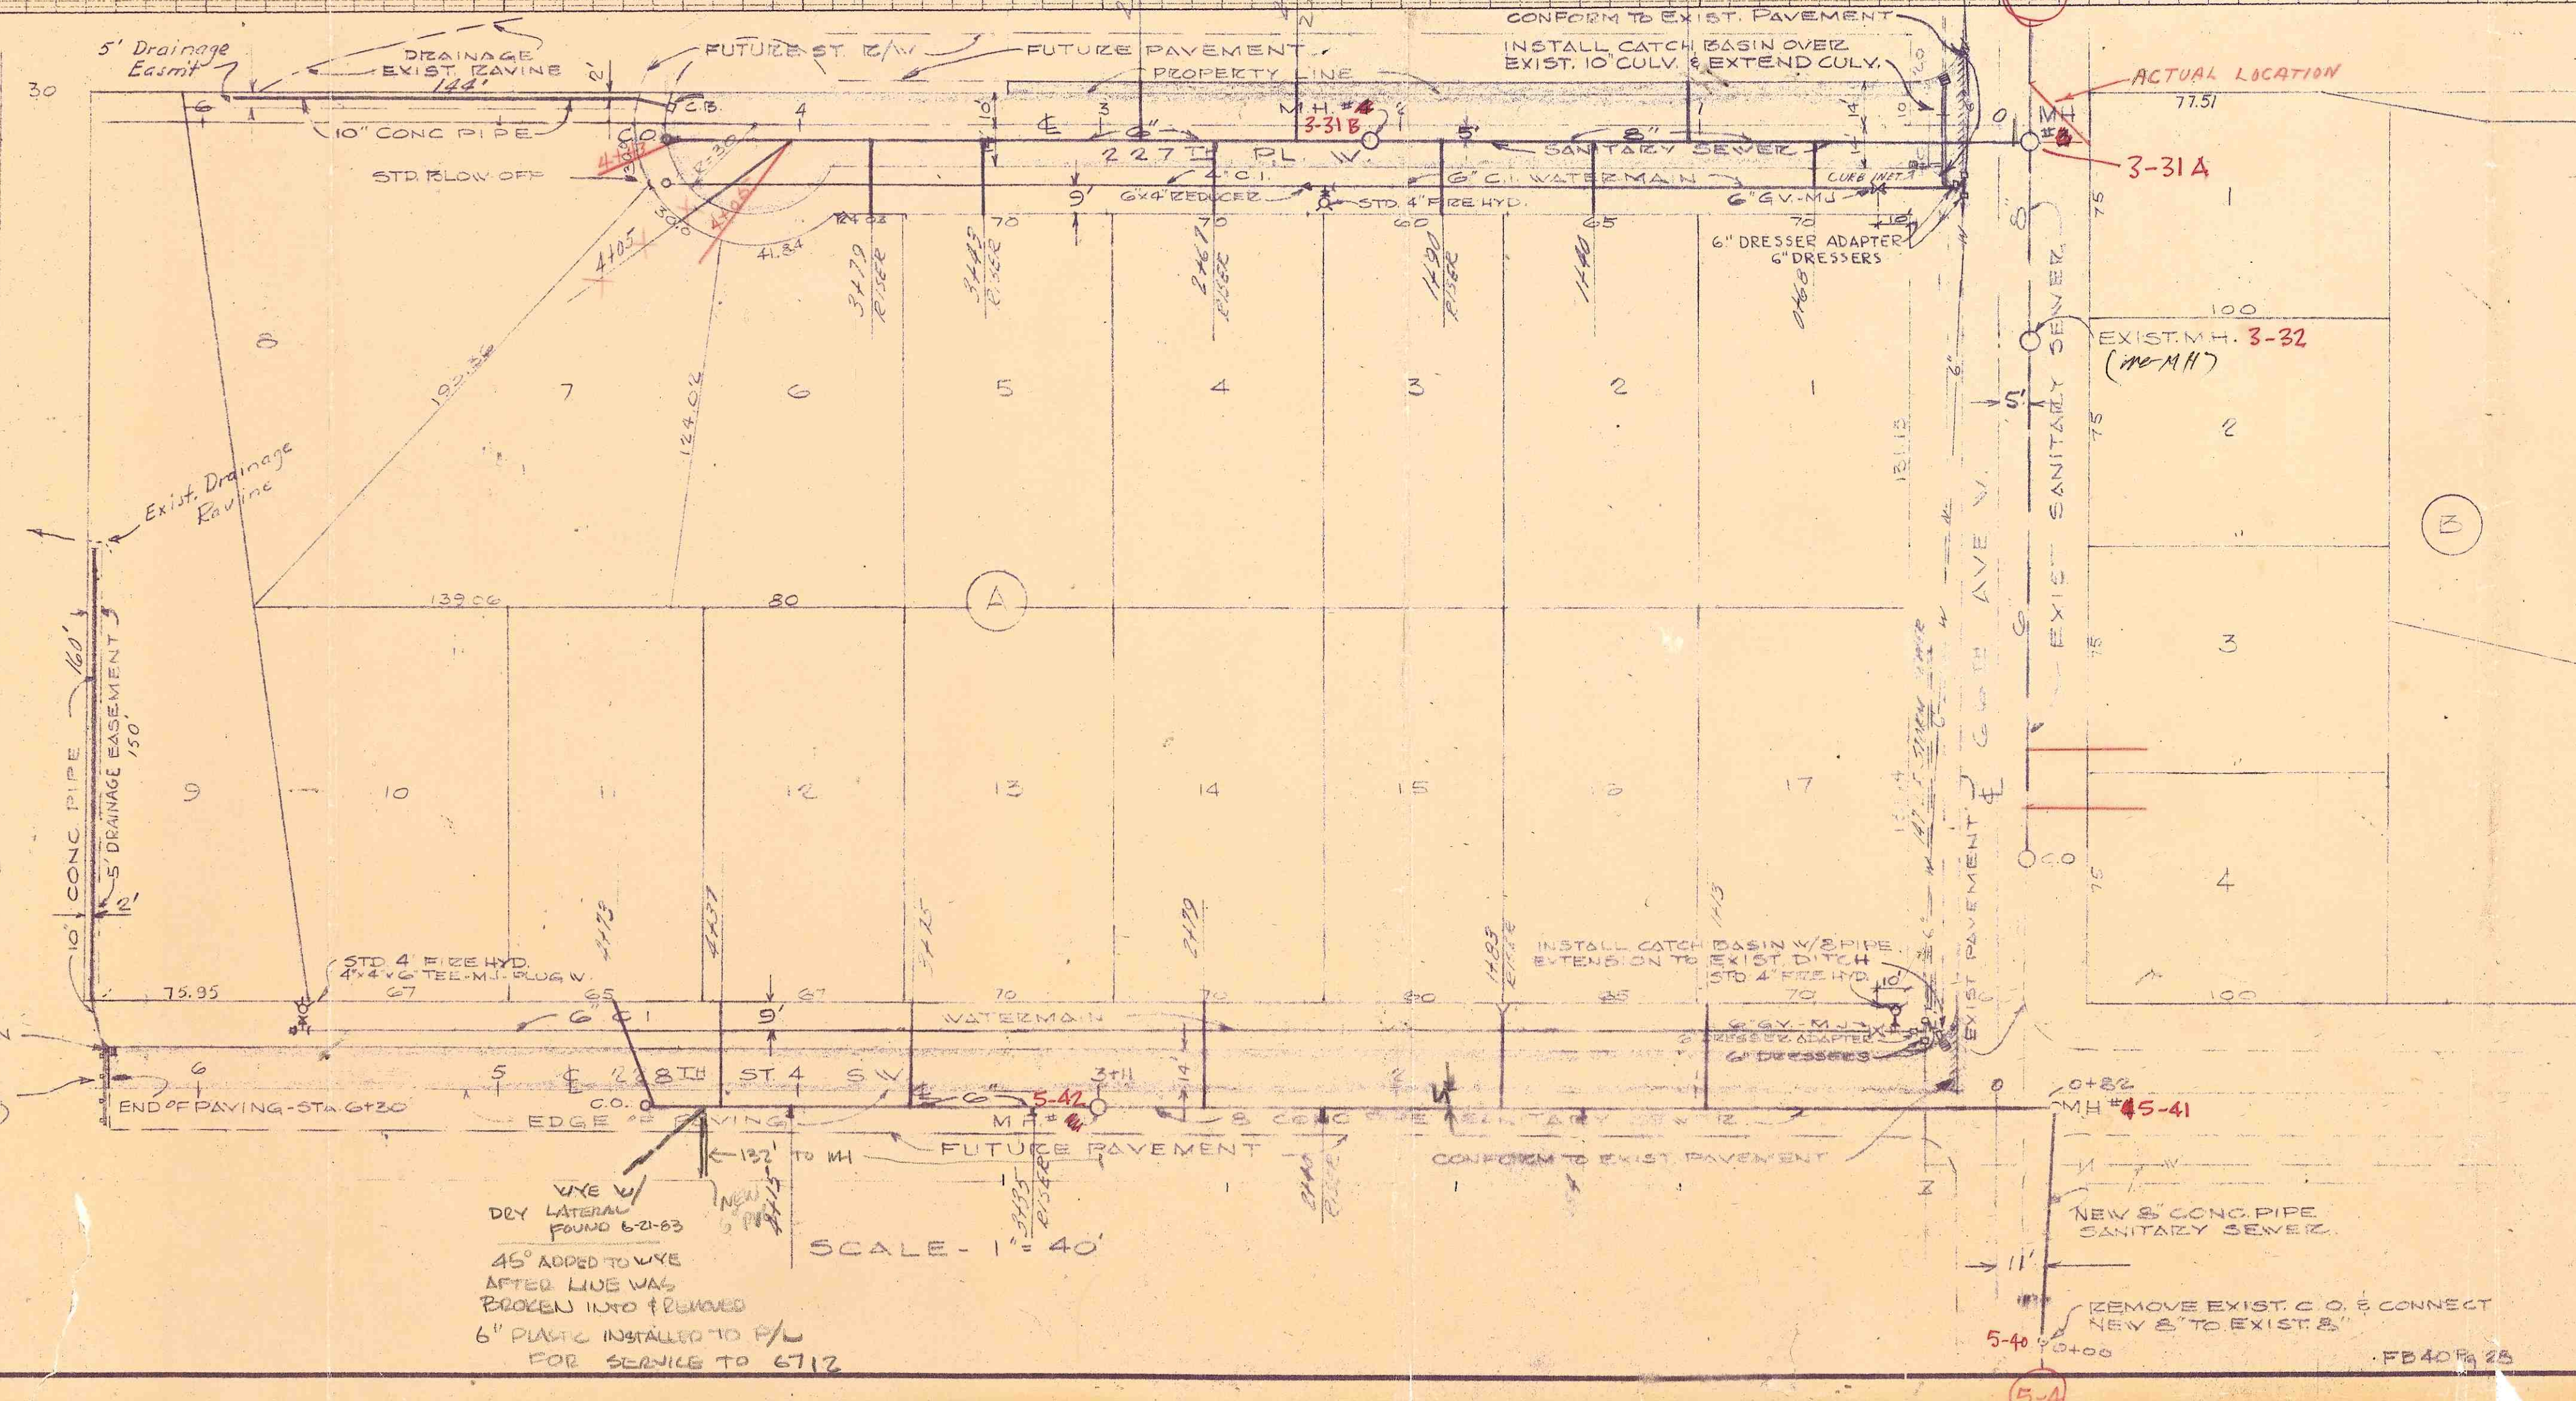

**5-4-A**

**AS BUILT DRAWING**

**CITY OF MOUNTLAKE TERRACE**

**IMPROVEMENT PLAN**

**STEINMAN ADDITION**

**JAMES H. REID & ASSOCIATES**  
CONSULTING ENGINEERS 420 BELL ST. EDMONDS, WASHINGTON

**PLAN, PROFILES**

**REVISION**

NO.	DATE	REVISION
1	3/24/64	CHANGED HYDRANT LOCATION & MAIN SIZE TO 12"
2	3/11/64	CHANGED LOT LAYOUT - REMOVED IMPROVEMENTS PL 15

**SCALE**  
AS NOTED

**DATE**  
10/7/59

**DESIGN**  
PLF-LN

**DRAWN**  
PLF

**CHECKED**  
LN

**FILE NO.**  
592-A01

**SHEET**  
1 OF 1