

The City of Mountlake Terrace

APPL' TION

FOR

SIDE SEWER PERMIT

OUTSIDE ☐ INSIDE ☐ REPAIRS ☐

CARD No. _____


EASEMENT No. _____

OWNER PETERSON DEVELOPMENT Co. CONTRACTOR LARRY'S DRAINFIELD-SEWER SERVICE PERMIT No. 3968

HOUSE No. 4206-219 STREET FORESTWOOD AVENUE LOT No. 10 BLOCK No. _____

135.37'

NAME ADD. FORESTWOOD

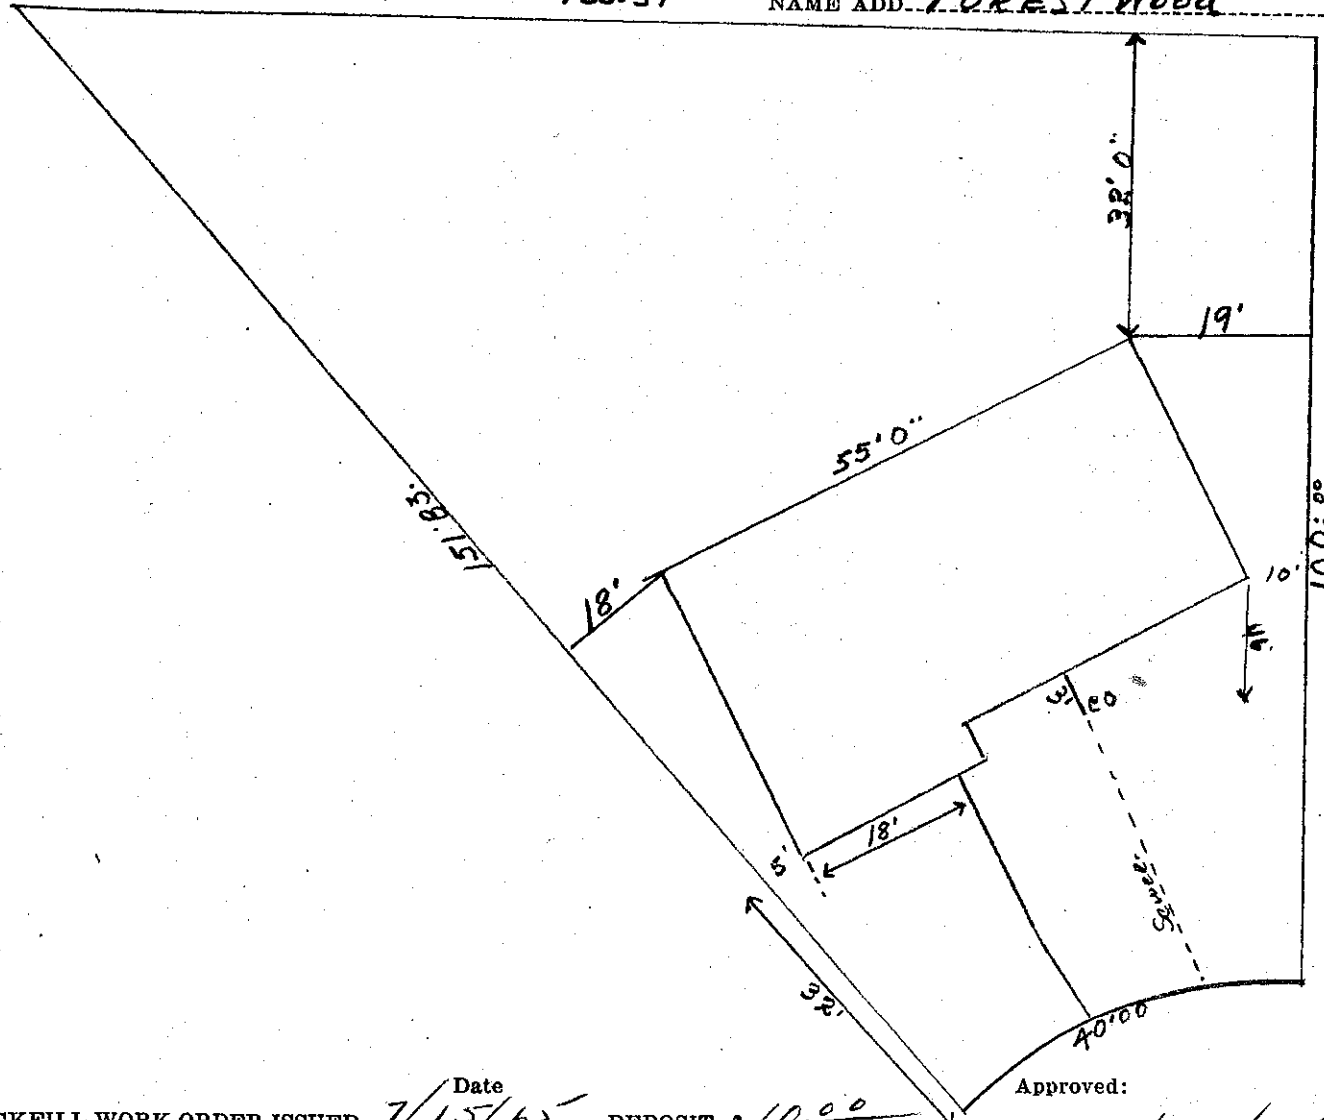

CITY OF
MOUNTLAKE TERRACE

JUL 15

Plan Approved [Signature]

Approved:

BACKFILL WORK ORDER ISSUED 7/15/65 Date 7/15/65 DEPOSIT, \$ 10.00

SEWER WORK ORDER ISSUED 7/15/65

DATE 7/15/65 BY George H. Baker

14785