



10 DEC. 1988

6/20/60  
JENNIFER  
JENNIFER

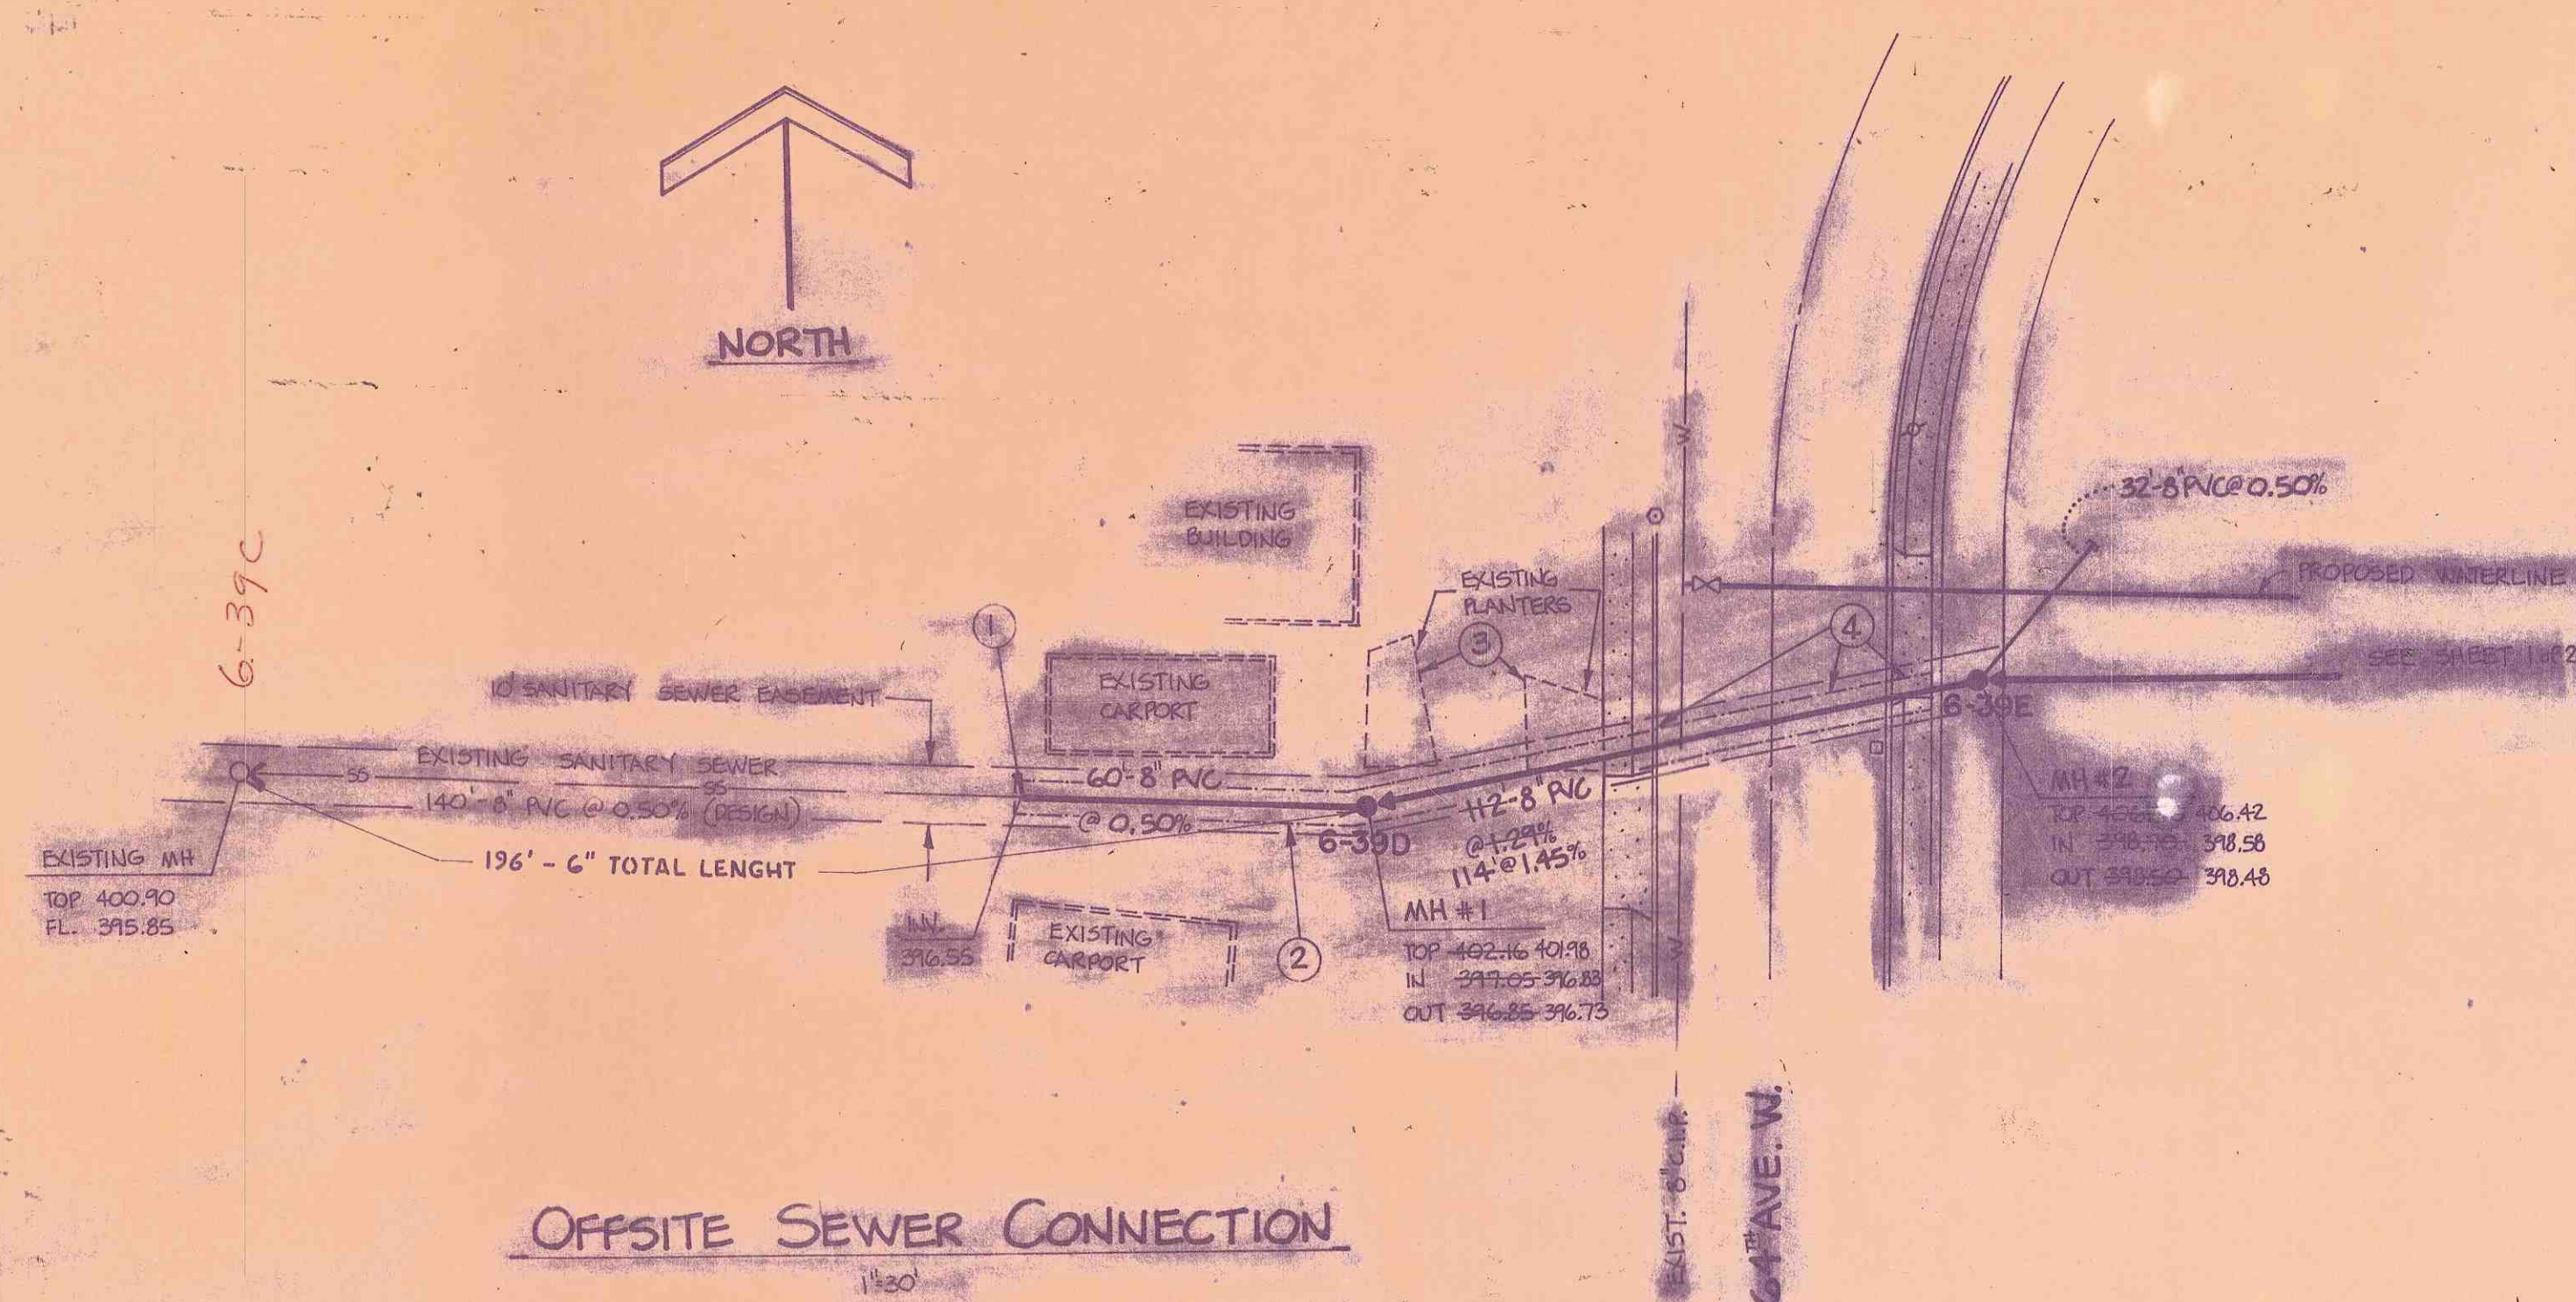

- ① REMOVE EXISTING LAMP-HOLE. VERIFY SLOPE OF EXISTING MANHOLE BEFORE PROCEEDING WITH EXTENSION.
- ② SAWCUT EXISTING ASPHALT AND RESTORE TO LIKE OR BETTER CONDITION.
- ③ RESTORE LANDSCAPING TO LIKE OR BETTER CONDITION.
- ④ SAWCUT EXISTING SIDEWALK AND STREET AND RESTORE TO LIKE OR BETTER CONDITION. USE SELECT BACKFILL IN RIGHT-OF-WAY AND PARKING AREA.

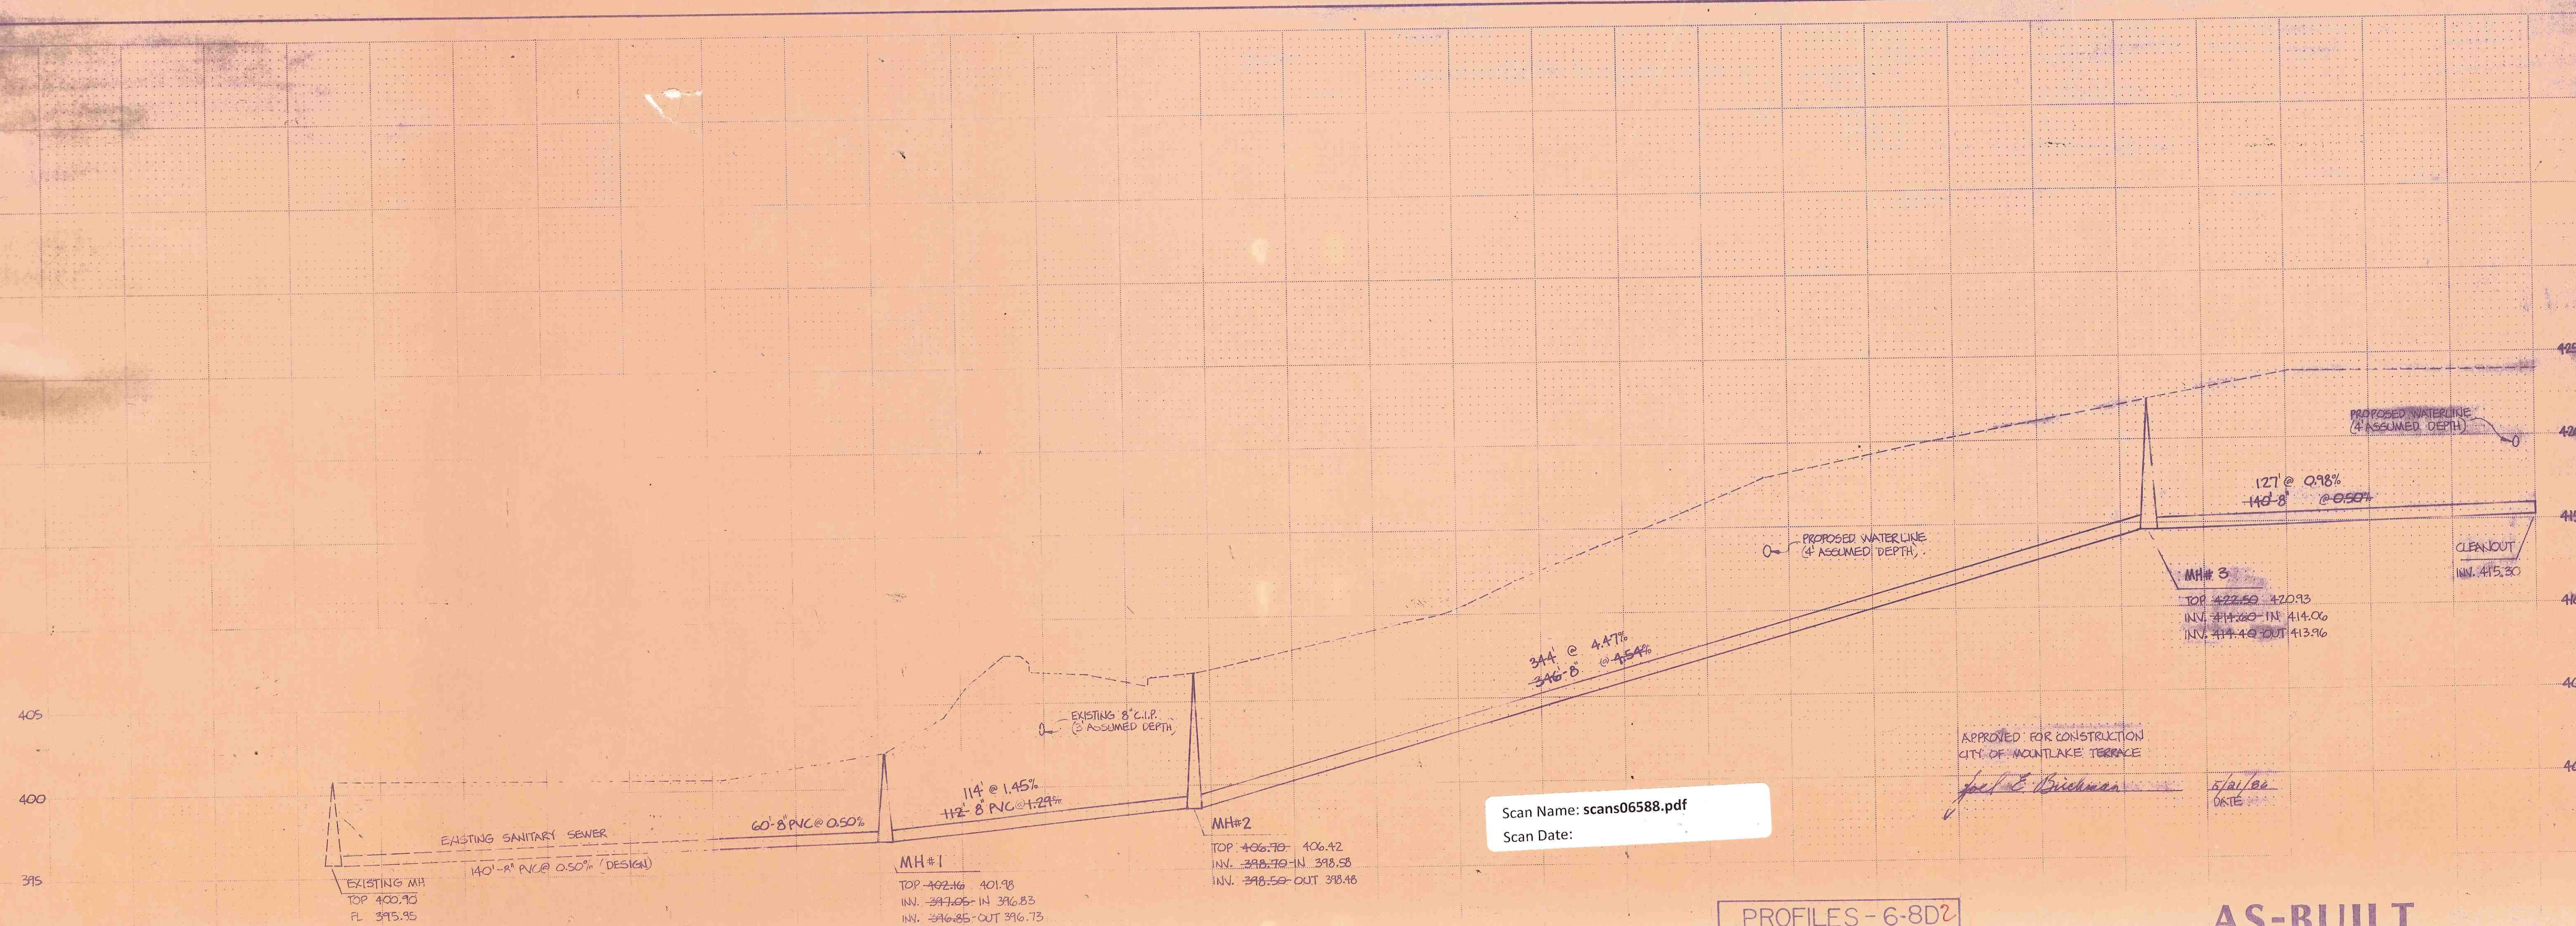

Scan Name: scans06588.pdf  
Scan Date:

APPROVED FOR CONSTRUCTION  
CITY OF MOUNTLAKE TERRACE

5/21/80  
DATE

PROFILES - 6-8D<sup>2</sup>

## AS-BUILT

**SANITARY SEWER PROFILE**  
**220th ST. PLAZA**

SHEET 2 OF  
FILE NO. 9350