
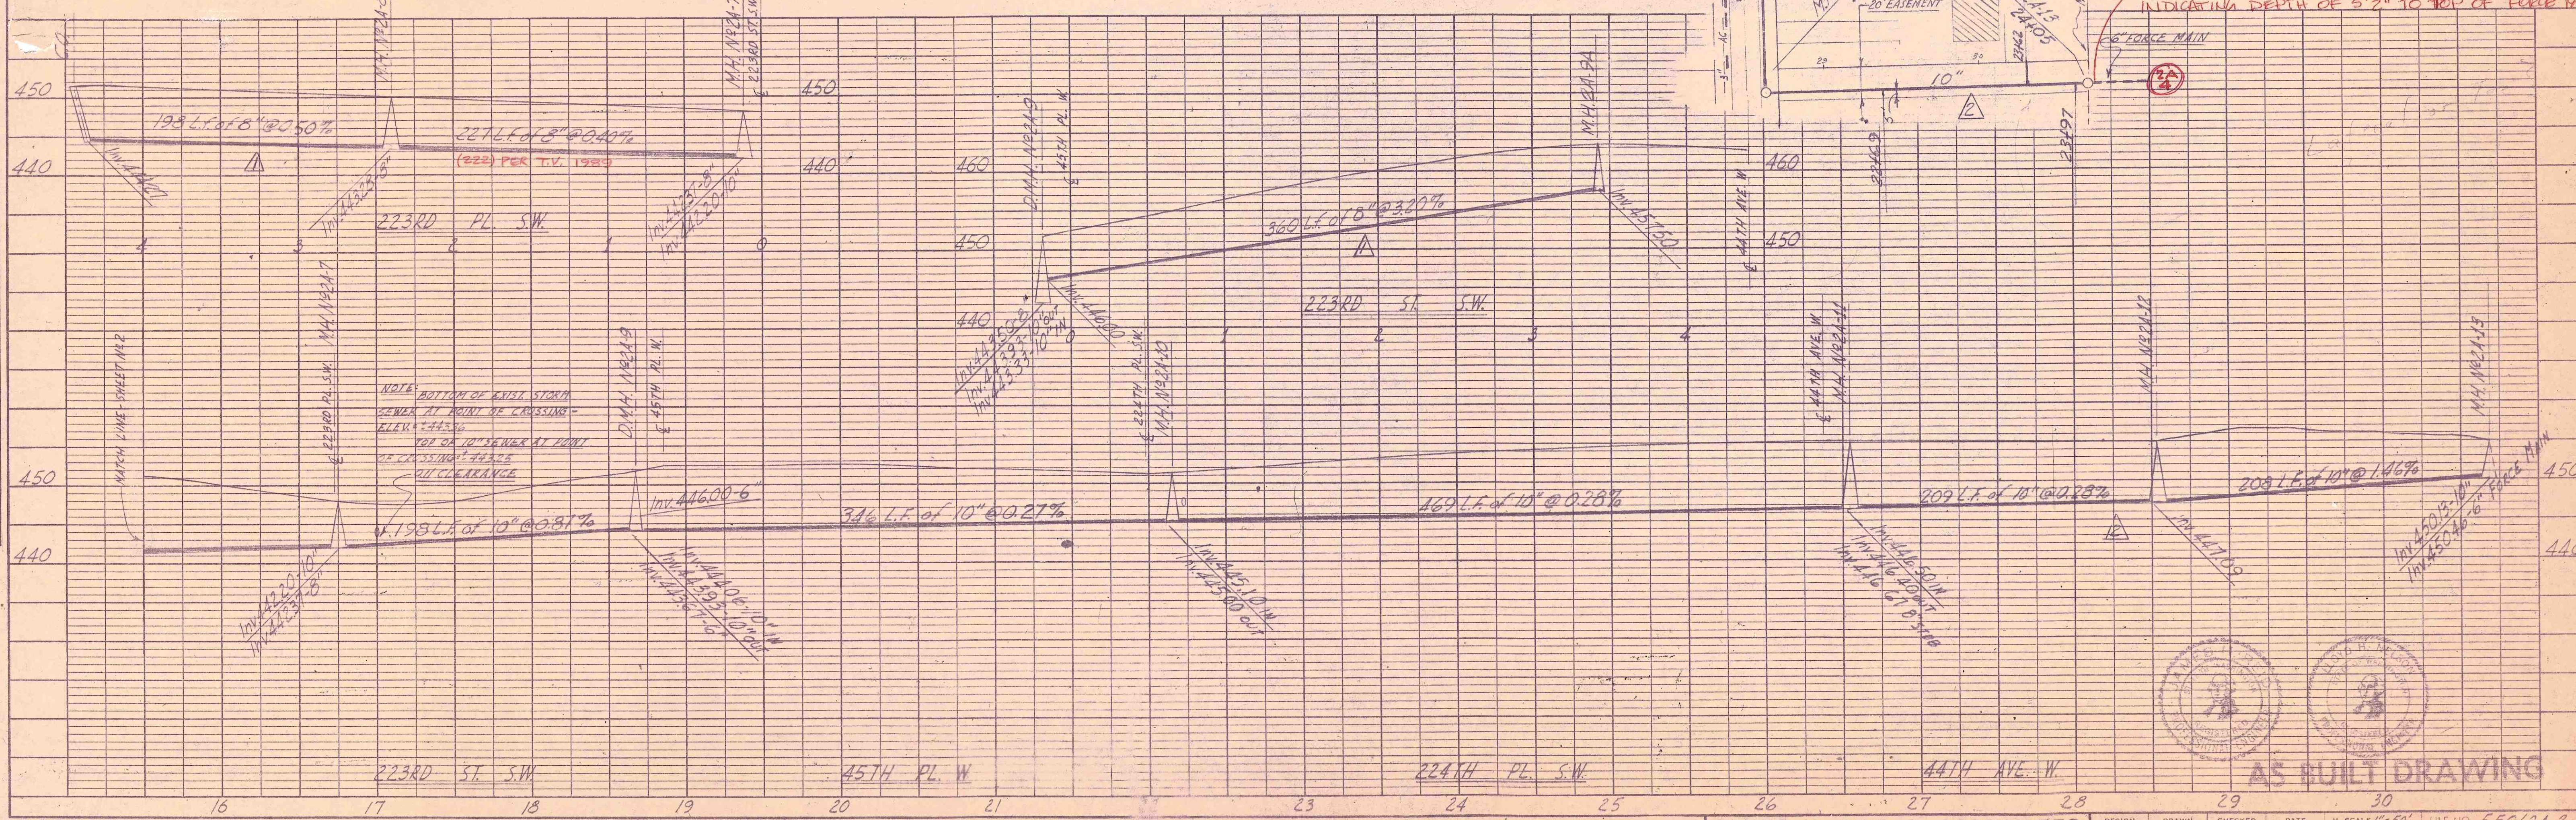


DATE	BY	DATE	BY	DATE	BY
PLAN					
NOTE BOOK					
NO. 3					
RT. OF WAY CHECKED					
NO. 3					

DATE	BY	DATE	BY	DATE	BY
PROFILE					
NOTE BOOK					
NO. 3					
STRUCTURE NOTATIONS CHECKED					
NO. 3					

DATE	BY	DATE	BY	DATE	BY
PROFILE					
NOTE BOOK					
NO. 3					
STRUCTURE NOTATIONS CHECKED					
NO. 3					

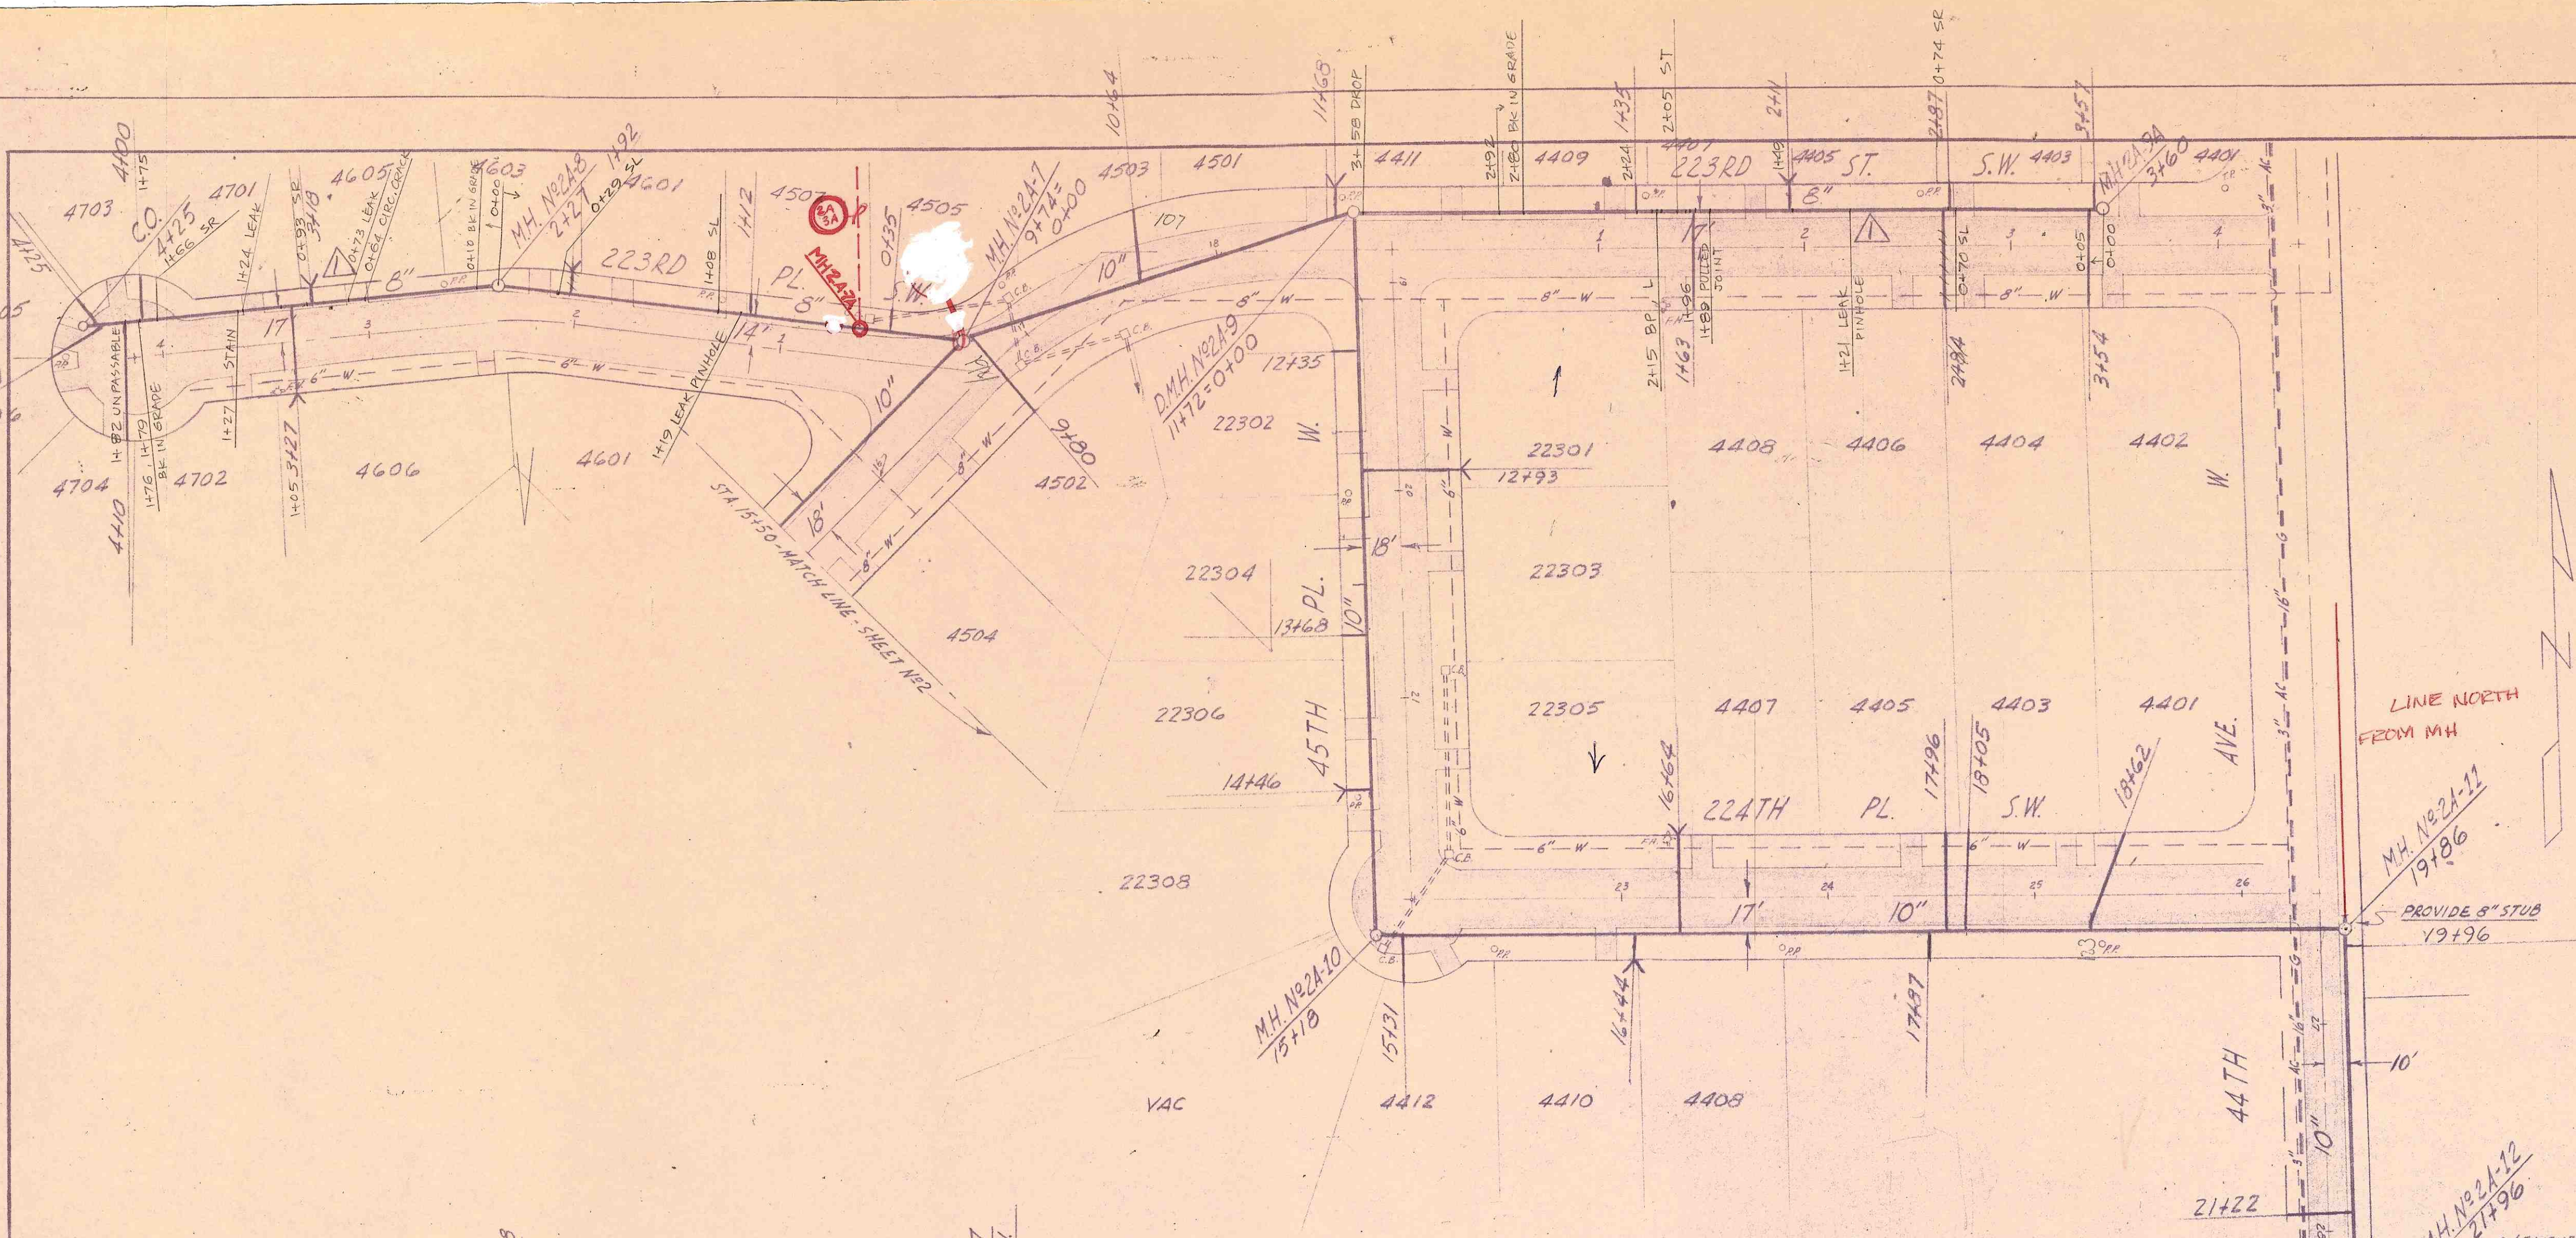

Scan Name: scans06351.pdf  
Scan Date:

GAS SERVICE IS LOCATED ON TOP OF MAIN - DEP  
MARKER INSTALLED AT EDGE OF SIDEWALK  
INDICATING DEPTH OF 5'2" TO TOP OF FORCE MAIN



AS BUILT DRAWING