

The City of Mountlake Terrace

APPLICATION

for

SIDE SEWER PERMIT

OUTSIDE ☒ INSIDE ☐ REPAIRS ☐

CARD No. _____

EASEMENT No. 1352626

OWNER ELIZABETH NOBLE

CONTRACTOR SELF

PERMIT No. 26


HOUSE No. 23203-55TH. WEST

STREET AVENUE LOT No. 2

BLOCK No. 2

NAME ADD.

Division No. 6

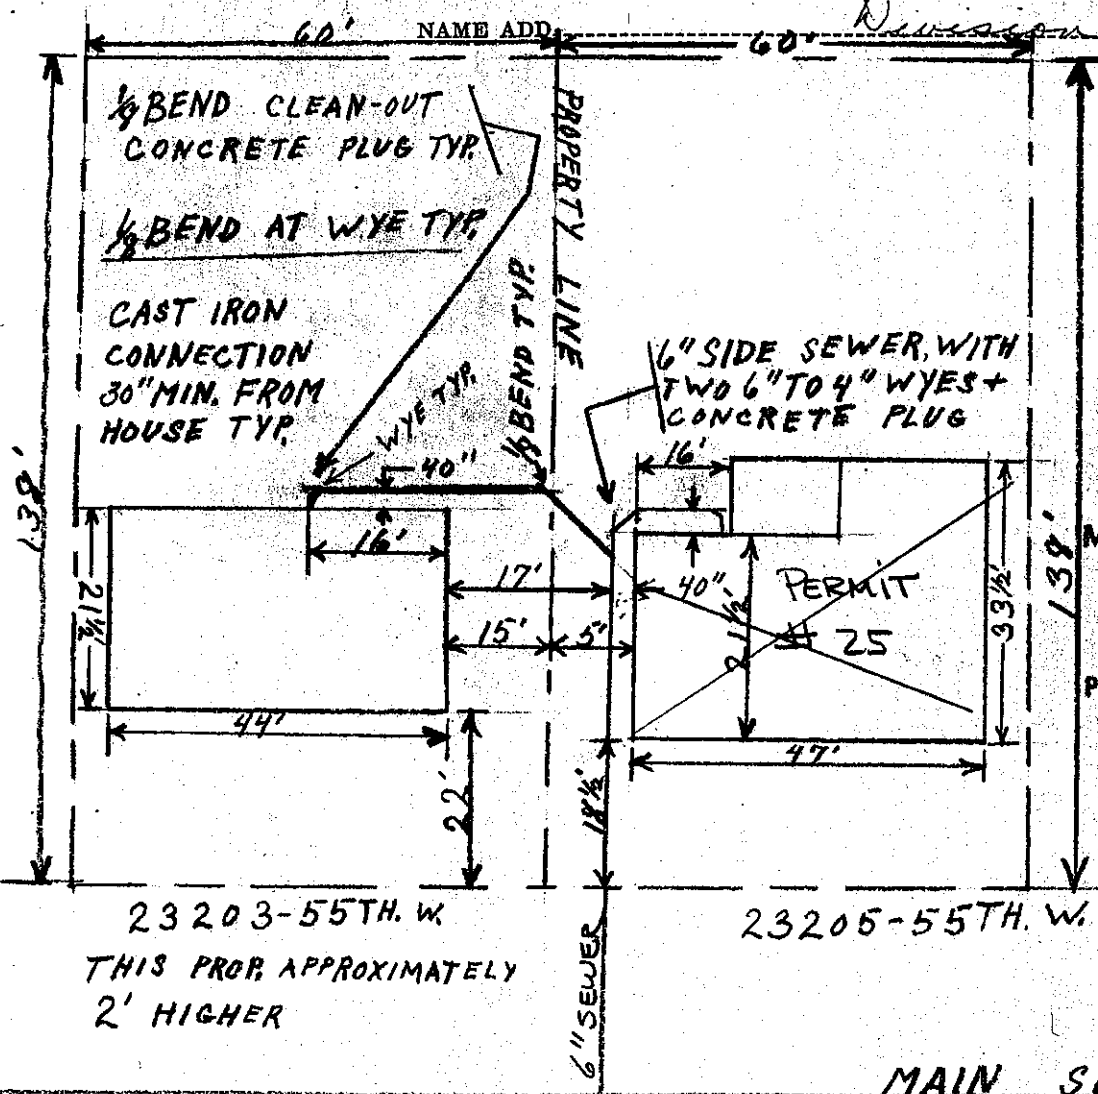

CITY OF MOUNTLAKE TERRACE

OCT 5 1959

Plan Approved J. Fairman S.M.H.

MAIN SEWER LINE

Date

Approved:

BACKFILL WORK ORDER ISSUED

DEPOSIT, \$100

8-18-59

SEWER WORK ORDER ISSUED

DATE 1-21-60

BY Scott M. Holton INS+CON