

The City of Mountlake Terrace

443600  
APPLICATION

for

SIDE SEWER PERMIT

OUTSIDE ☒ INSIDE ☐ REPAIRS ☐


CARD No. ....

EASEMENT No. 1420980 ✓

OWNER James P. Miller CONTRACTOR \_\_\_\_\_ PERMIT No. 470

HOUSE No. 5006 - 239th SW STREET \_\_\_\_\_  
238 Pl. S.D. AVENUE LOT No. Lot 12 Replat of 40 E. Harborway  
BLOCK No. 2nd Pl. S.D.

NAME ADD. ....

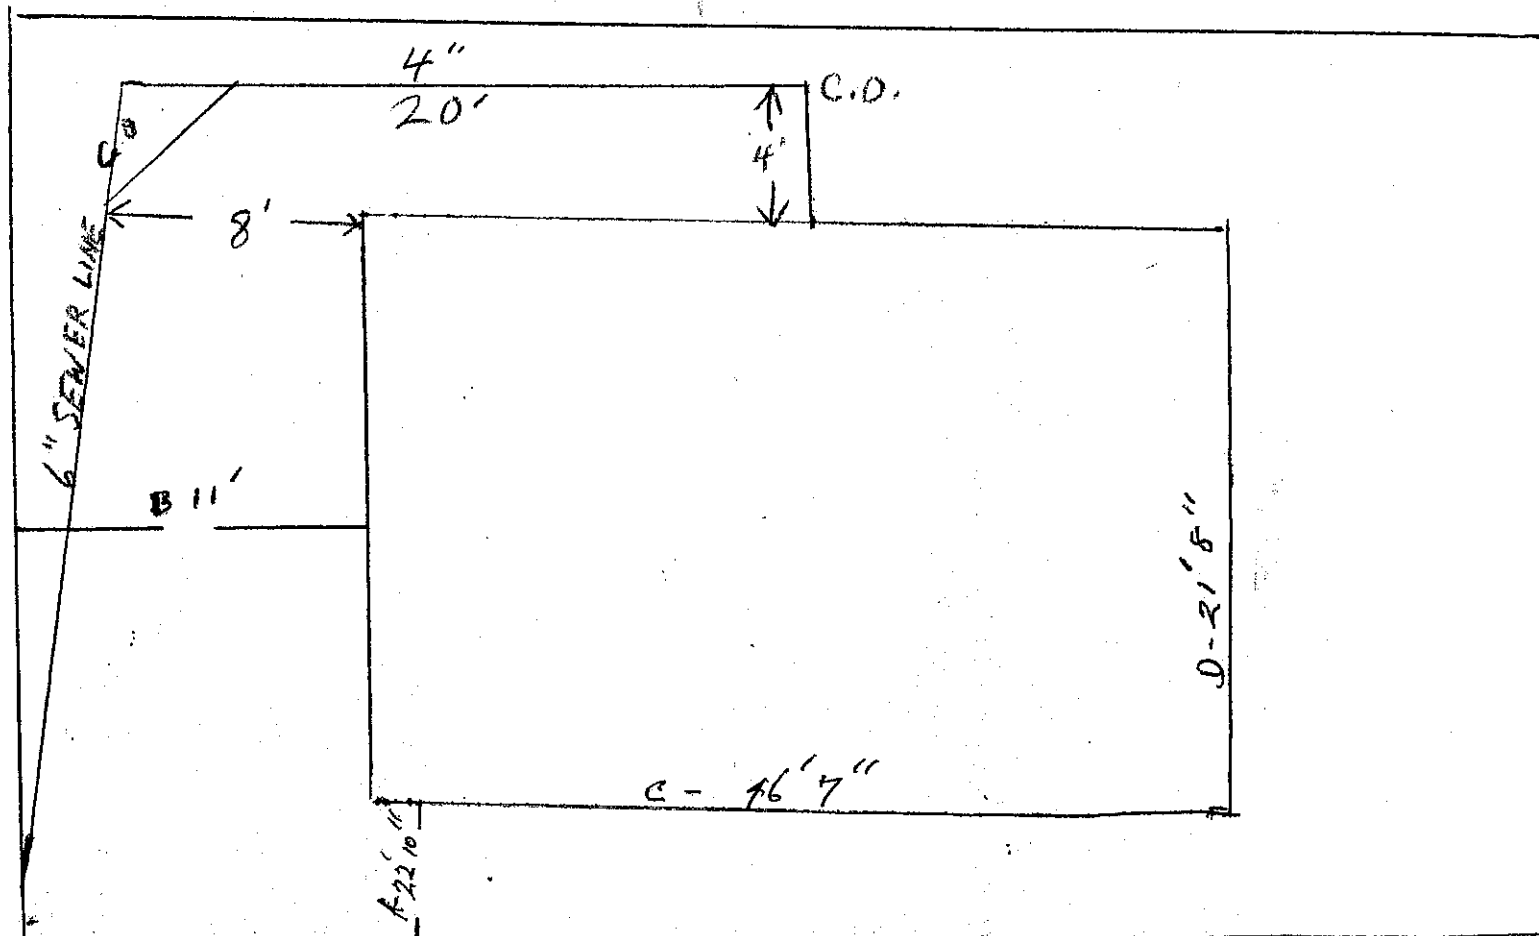

Sewer line  
BACKFILL WORK ORDER ISSUED \_\_\_\_\_ Date \_\_\_\_\_ Approved: \_\_\_\_\_  
SEWER WORK ORDER ISSUED \_\_\_\_\_ DEPOSIT, \$ 10.00  
9-24-60 DATE 9-28-60 BY S. M. Holton IKStCON  
#1912