

K. M. TOSTER

CARD No. \_\_\_\_\_

## SIDE SEWER PERMIT

OUTSIDE ☒ INSIDE ☐ REPAIRS ☐

EASEMENT No. \_\_\_\_\_


OWNER Raye M. Foster CONTRACTOR None PERMIT No. 2653

HOUSE No. 23504 - 52 W. STREET  
AVENUE LOT No. 16 BLOCK No. 10

NAME ADD

Div. 1

Concrete septic tank  
1/8 Bend clean out plug

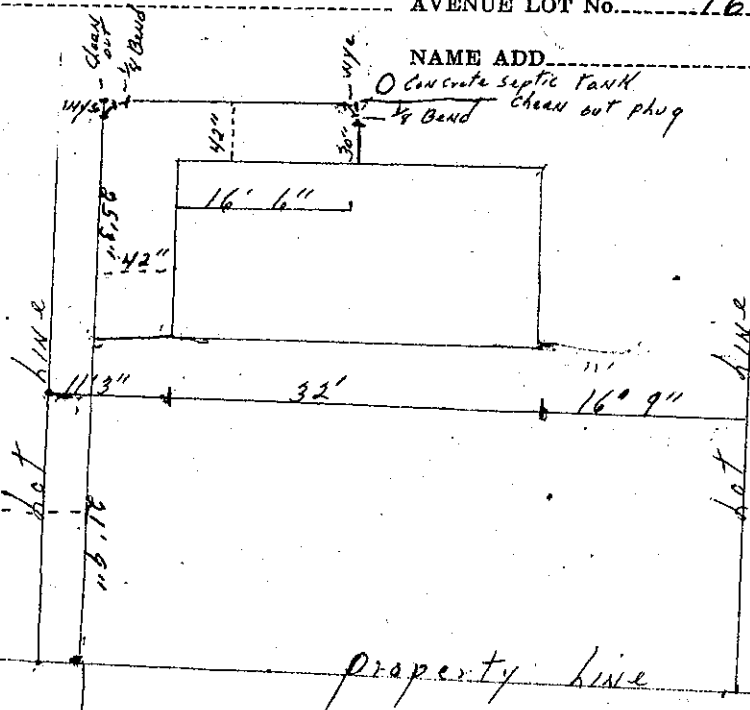

CITY OF  
MOUNTLAKE TERRACE

MAY 16 1960

Plan Approved S. M. Ahee

BACKFILL WORK ORDER ISSUED \_\_\_\_\_ DEPOSIT, \$10.00 5/12/60  
SEWER WORK ORDER ISSUED \_\_\_\_\_ 1436 DATE 5-16-60 BY S. M. Holton / NS & CON