

TIMBERLINE PARK
DEAN ECHELBARGER ~ DEVELOPER

The City of Mountlake Terrace

APPLICATION

for

SIDE SEWER PERMIT

OUTSIDE ☒ INSIDE ☐ REPAIRS ☐

CARD No. _____

EASEMENT No. _____

OWNER 3605 CONTRACTOR UNIVERSAL UTIL. CONT. EDMONDS, WASH. PERMIT No. 74-14


HOUSE No. 2605 225 TH PL SW STREET SIDE SEWER TO LOT LINE AVENUE LOT No. 31 BLOCK No. _____

NAME ADD

Side Sewer Permit No U-32-75 issued 4/28/75 to
Lynnwood Septic Tank Co. Installed, inspected,
accepted and asbilt made 4/28/75 F H Smith

32 31

31 30

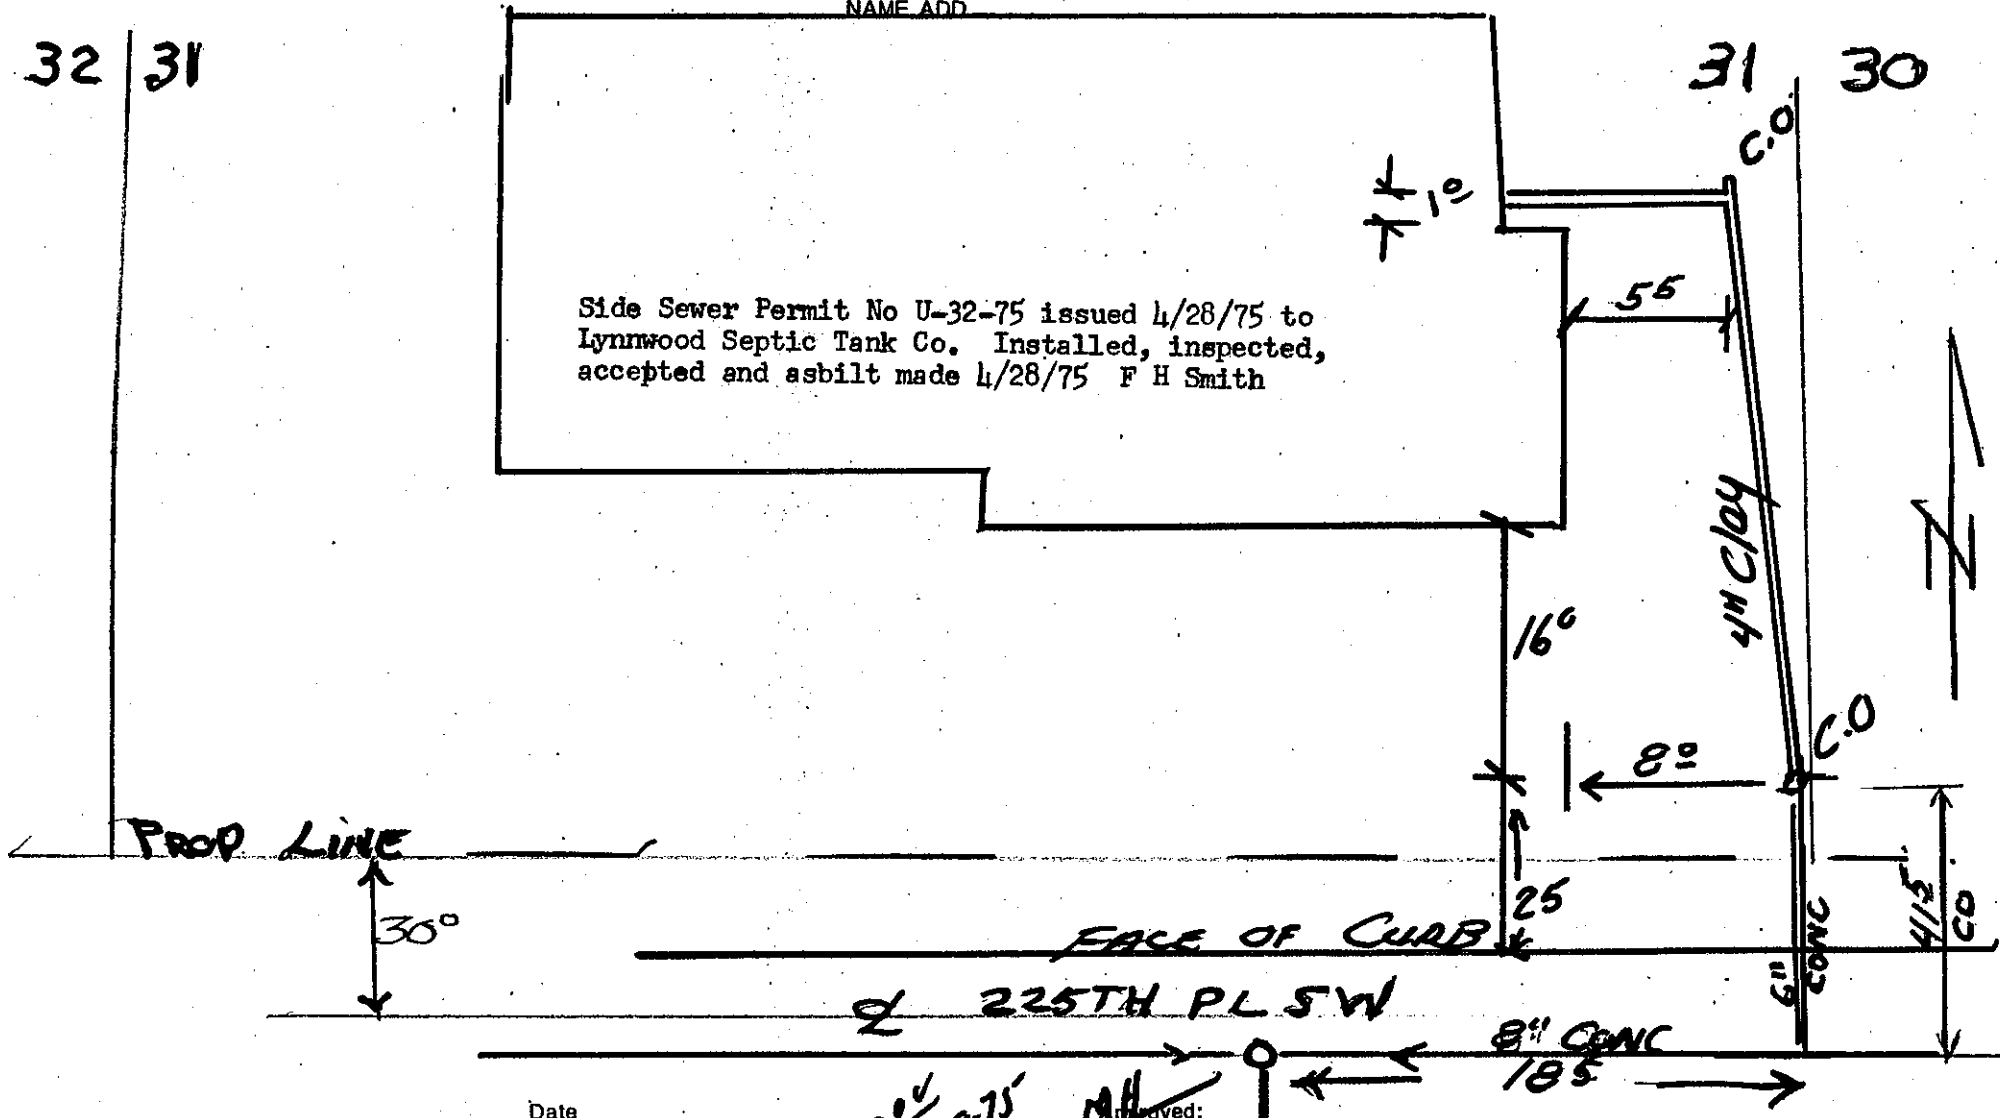

BACKFILL WORK ORDER ISSUED

SEWER WORK ORDER ISSUED

Date

DEPOSIT, \$

DATE

BY

F.H. SMITH