

The City of Mountlake Terrace

APPL TION


SIDE SEWER PERMIT

OUTSIDE ☐ INSIDE ☐ REPAIRS ☐

CARD No. _____

EASEMENT No. _____

OWNER Parkwood Homes Inc. CONTRACTOR Lynnwood Septic Tank PERMIT No. 3971
HOUSE No. 4401 - 219 SW STREET 1
AVENUE LOT No. 1 BLOCK No. _____
NAME ADD. Parkwood Homes (Cedar Park)

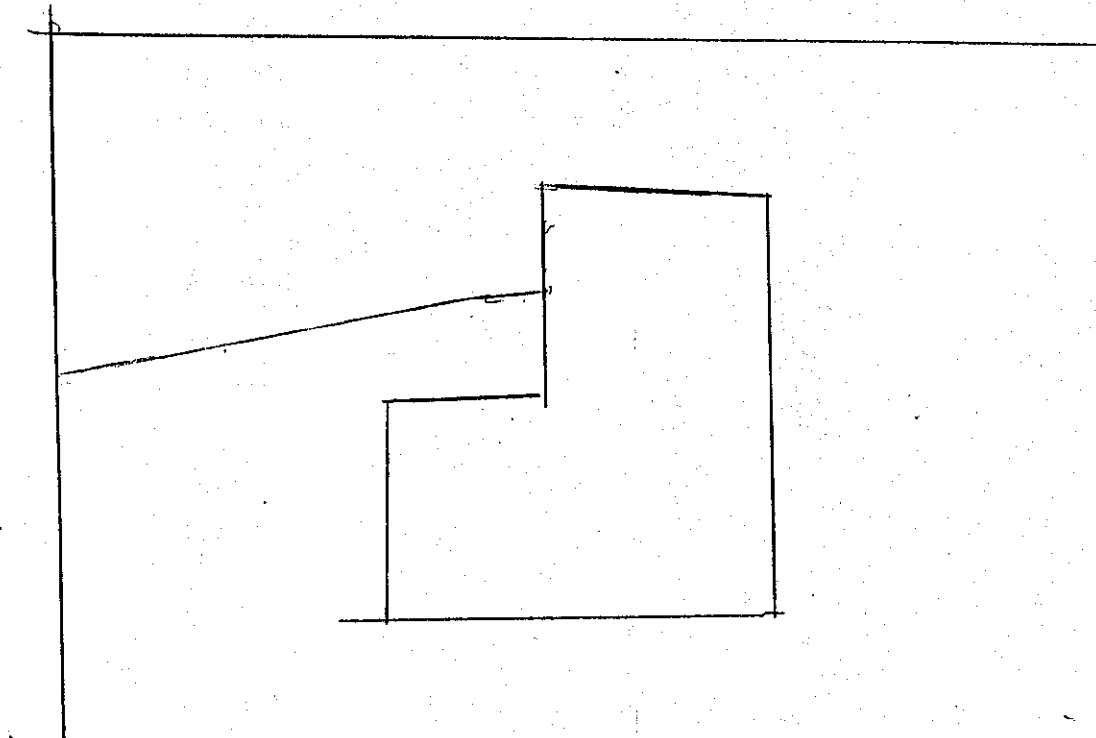

CITY OF
MOUNTLAKE TERRACE

JUL 29

Plan Approved [Signature]

BACKFILL WORK ORDER ISSUED _____ DEPOSIT, \$ _____
SEWER WORK ORDER ISSUED _____

Approved: _____
DATE 7/29/65 BY _____