

APPLICATION

CARD No. _____

The City of Mountlake Terrace

SIDE SEWER PERMIT


OUTSIDE ☐ INSIDE ☒ REPAIRS ☐

EASEMENT No. _____

OWNER Russ Wacker CONTRACTOR Owner PERMIT No. 3766

HOUSE No. 4007- 226 P SW STREET 83 AVENUE LOT No. 83 BLOCK No. _____

NAME ADD. _____

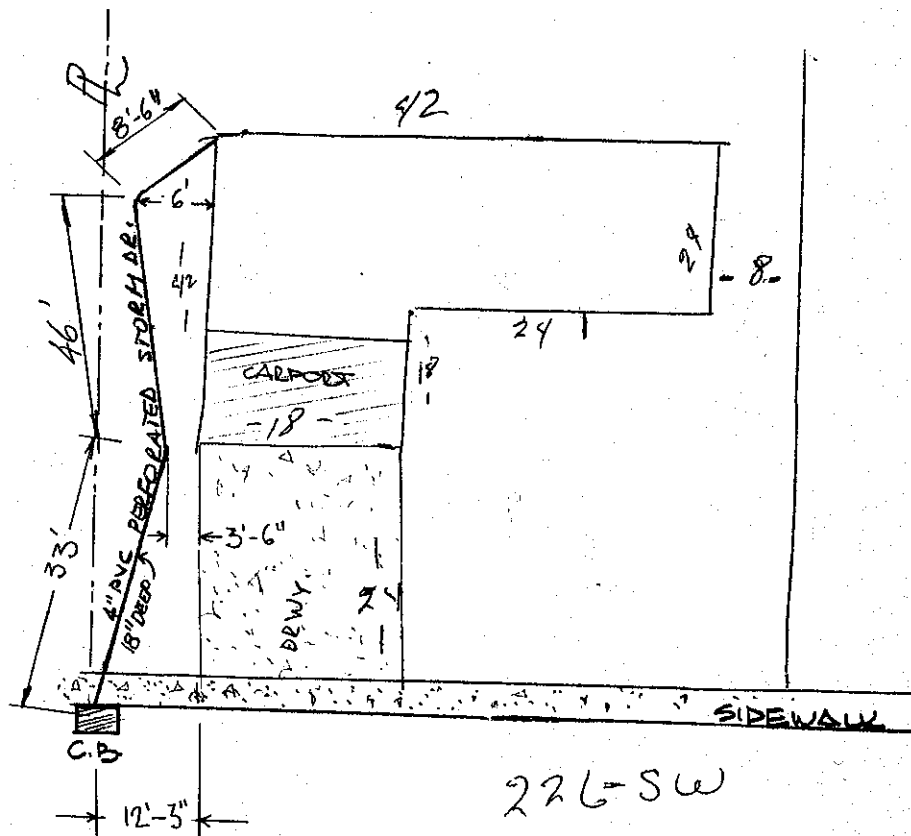

NOTE: STORM DRAIN ADDED 5-18-87

BACKFILL WORK ORDER ISSUED _____ DEPOSIT, \$ _____
SEWER WORK ORDER ISSUED _____

Approved: _____
DATE 5-6-64 BY R. Behn