

APPLICATION

for

SIDE SEWER PERMIT

2185


CARD No. _____

The City of Mountlake Terrace

OUTSIDE ☐ INSIDE ☒ REPAIRS ☐

EASEMENT No. _____

OWNER Elmer Most. CONTRACTOR Lynnwood Septic PERMIT No. 3124
 HOUSE No. 4505 STREET 37- BLOCK No. 243rd pl SW
 AVENUE LOT No. 37-
 NAME ADD. Terrace Ridge

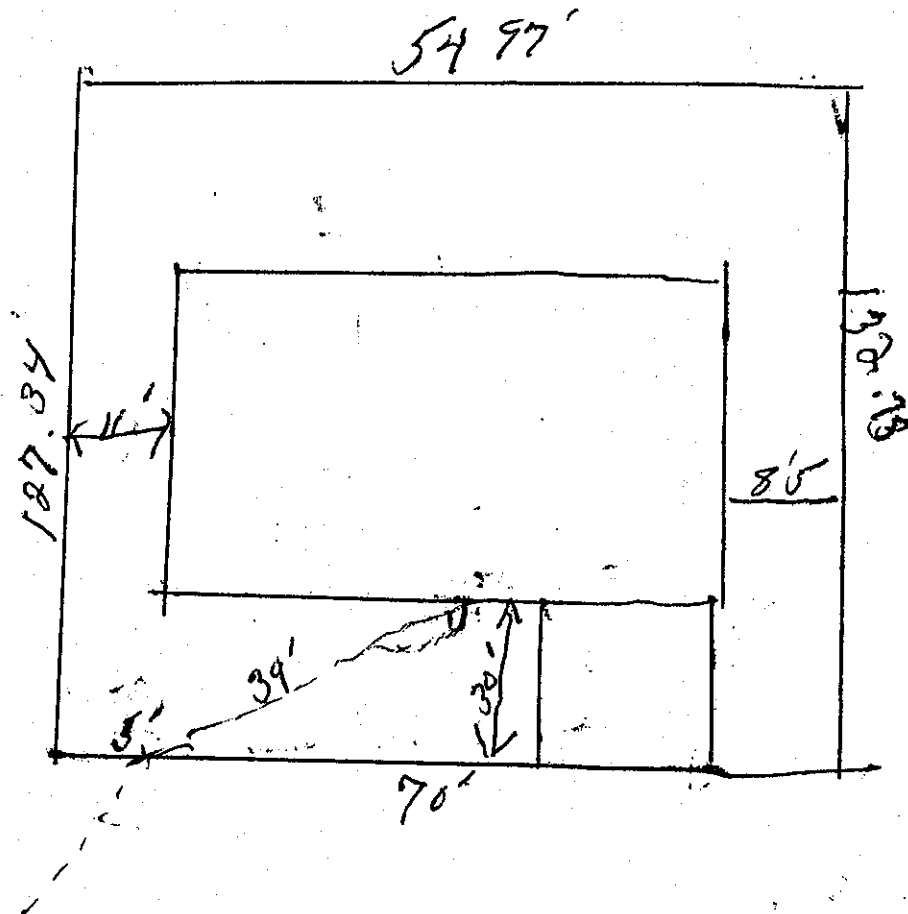

BACKFILL WORK ORDER ISSUED _____ DEPOSIT, \$ _____
 SEWER WORK ORDER ISSUED _____
 Date _____ Approved: _____
 DATE 4/25/62 BY JMB