

APPLICATION

CARD No.

The City of Mountlake Terrace

SIDE SEWER PERMIT

OUTSIDE ☒ INSIDE ☐ REPAIRS ☐

EASEMENT No.

H & H Homes P O Box 644 Lynnwood, Wash 98036

Universal Utility Contractors Inc.

OWNER

CONTRACTOR 11411 203rd St N E Woodenville

PERMIT No. 74-18

HOUSE No. 22212

67TH PL W


STREET

AVENUE LOT No.

12

BLOCK No.

NAME ADD Greenridge

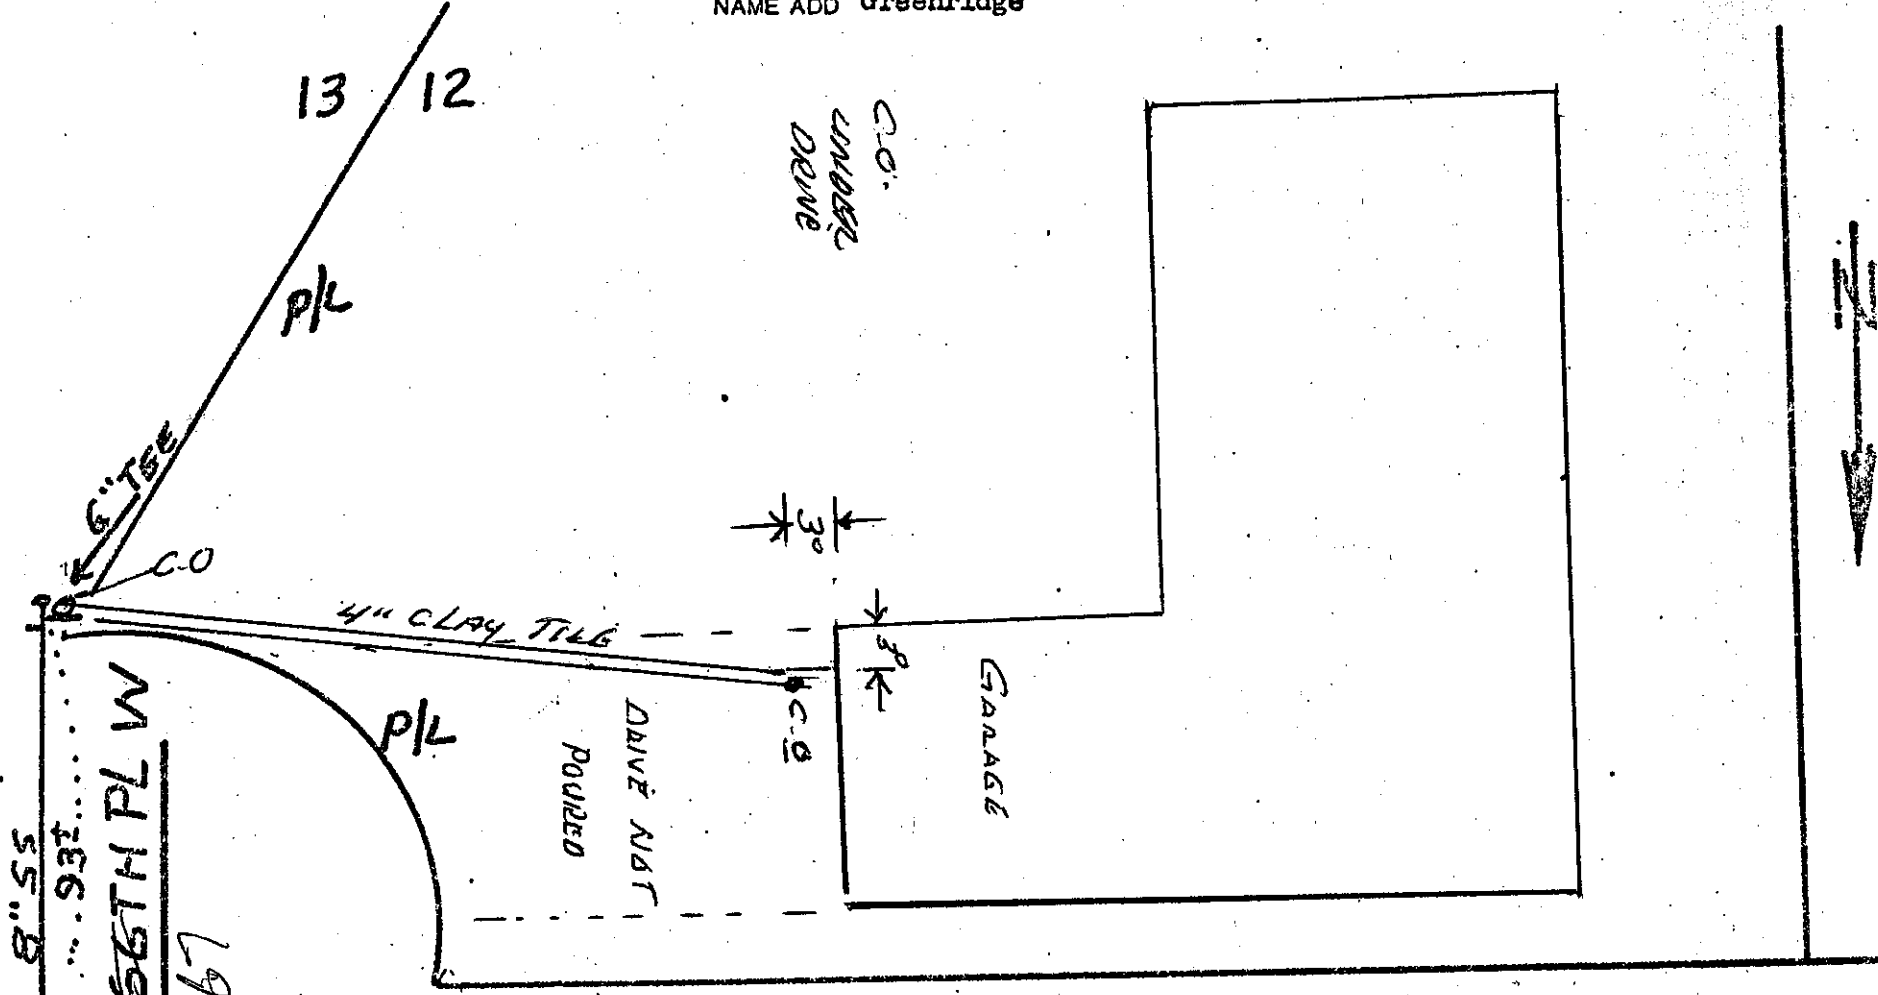

Side Sewer Permit No U-6-75 issued 2-26-75 to Lynnwood Septic Tank Co. by Fred H Smith

JACKFILL WORK ORDER ISSUED. June 11, 1974 DEPOSIT, \$
SEWER WORK ORDER ISSUED May 16, 1974

Approved: June 20, 1974
DATE BY Fred H. Smith