



DATE		BY		DATE		BY	
11/17/72		JH		11/17/72		JH	
PLAN				PROFILE			
NOTED				NOTED			
CHECKED				CHECKED			
DESIGNED				DESIGNED			
DRAWN				DRAWN			
DATE				DATE			
11/17/72				11/17/72			
BY				BY			
JH				JH			
DATE				DATE			
11/17/72				11/17/72			
BY				BY			
JH				JH			

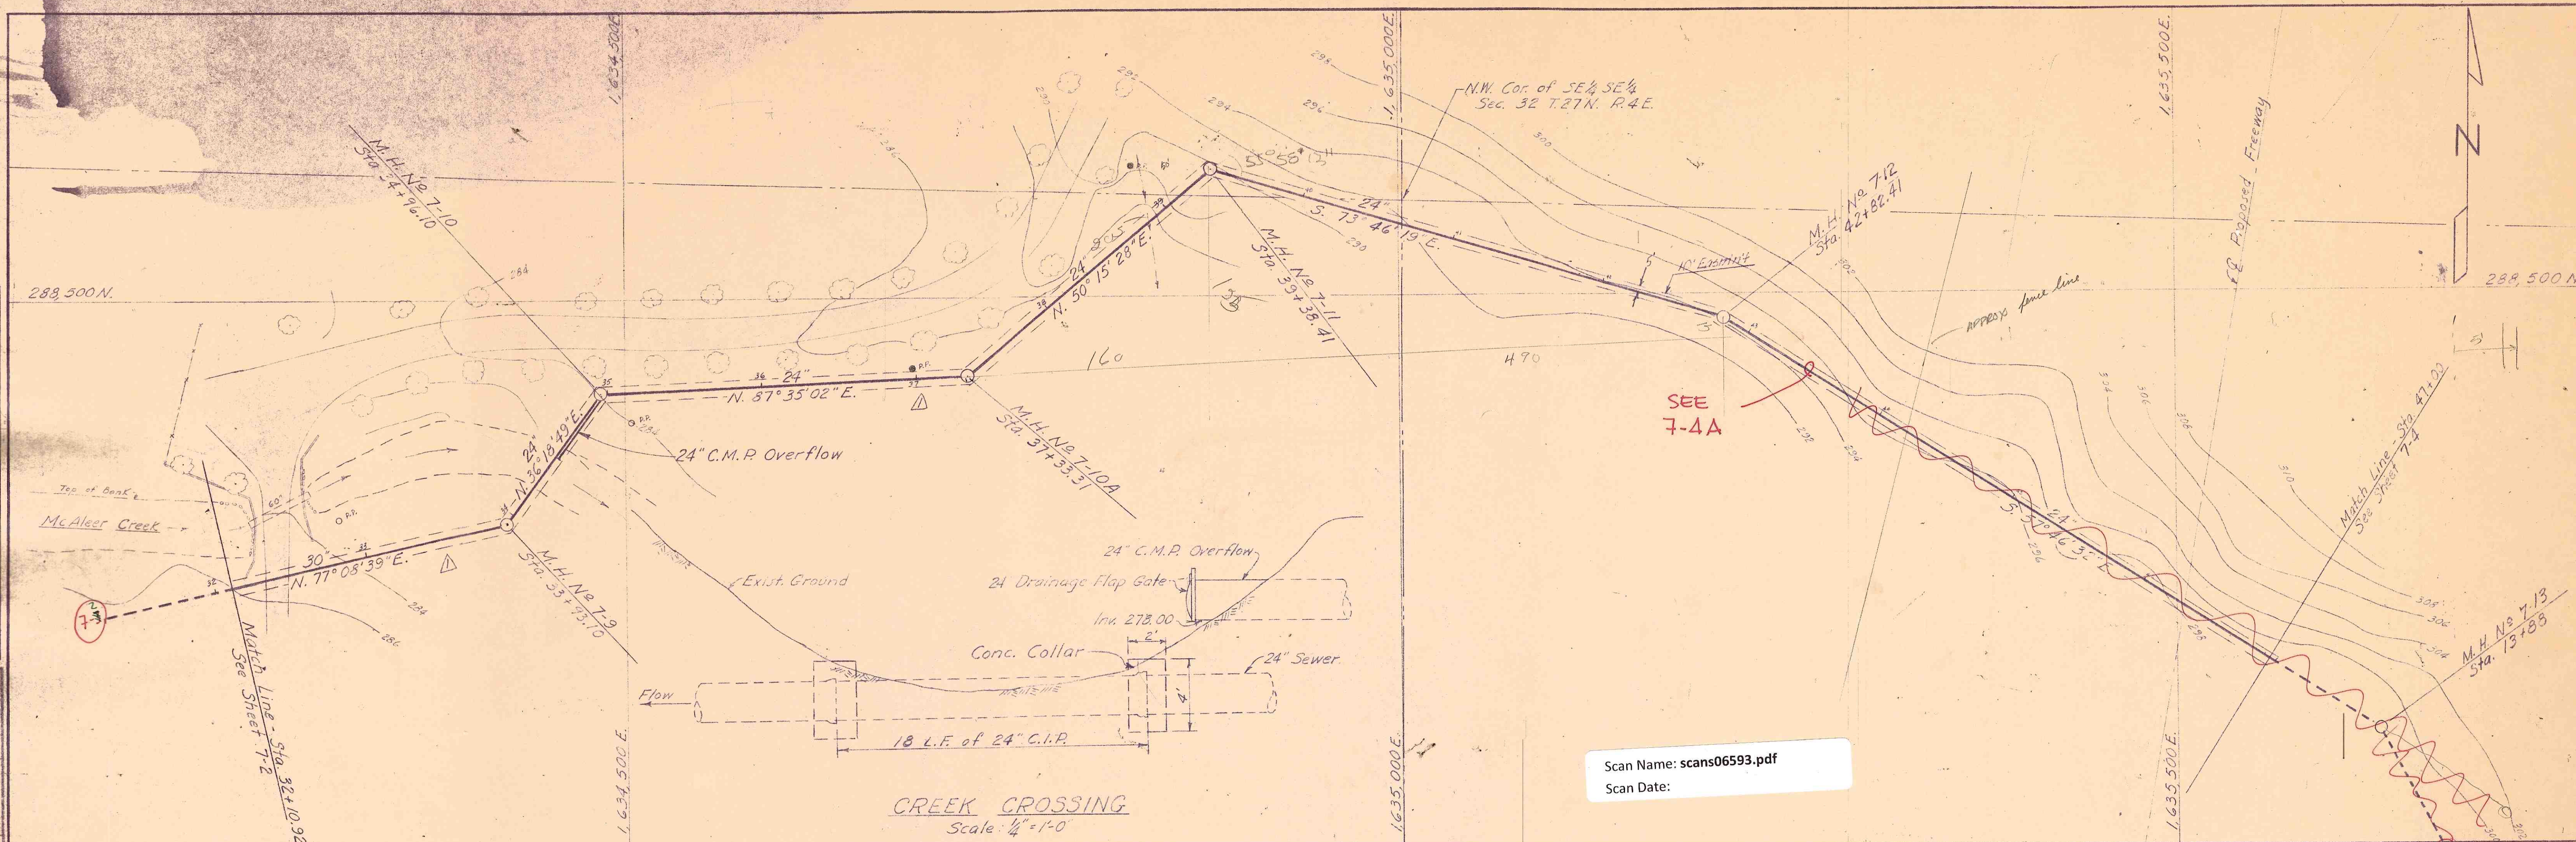

CREEK CROSSING
Scale: 1/4" = 1'-0"

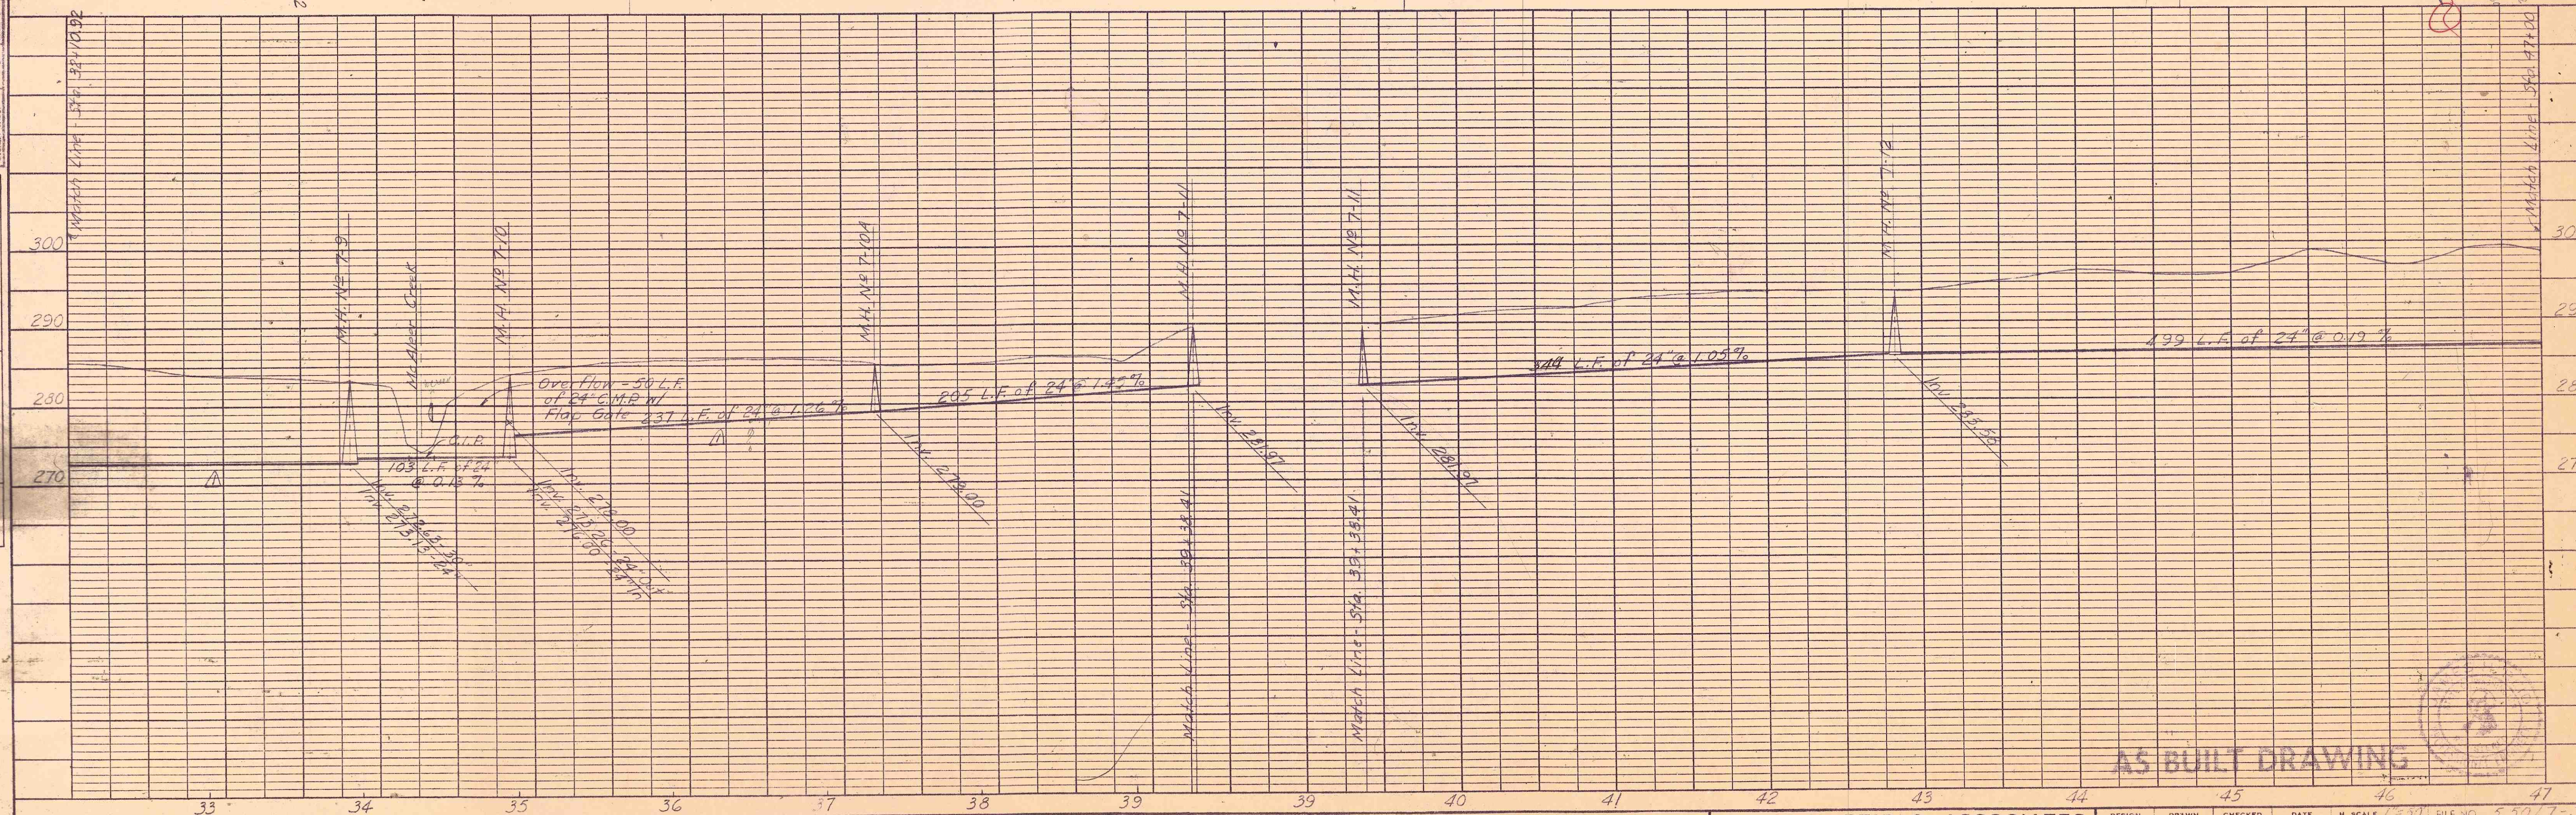

Scan Name: scans06593.pdf
Scan Date:

AS BUILT DRAWING

PLATE 1-PLAN-PROFILE-P.A.S.
CLEARPRINT PAPER CO. S.F. CAL.
No. 100011

JAMES H. REID & ASSOCIATES
CONSULTING ENGINEERS, 324 MAIN ST., EDMONDS, WASH.

DESIGN	DRAWN	CHECKED	DATE	H. SCALE	FILE NO.
LHN	LHN	LHN	3/30/59	1"=10'	530/1-3

CITY OF MOUNTLAKE TERRACE
SEWERAGE SYSTEM
UNIT 7