


A = spot repair on sidewalk
2' off E wall

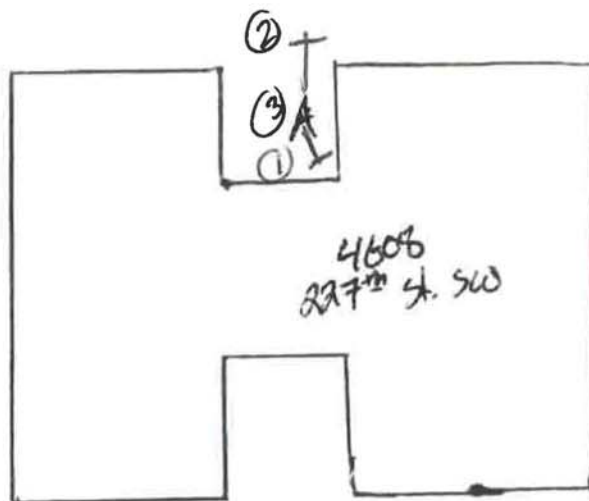

5' Repair

NW = 3ft

SW = 4' 9"

Depth 2' 3"

1 Franco (clay-pvc)

2 Franco (cast-pvc)

3 Clean out (Down)

OWNER: Anderson Guy A

ADDRESS: 4608 227th St

DATE: 06/12/20

PERMIT #: U-20-0025

Inspector's Signature:

James A. Mochly

SIDE SEWER DRAWING

1. Drawing must be clearly labeled (streets, north arrow).
2. Indicate location of all piping, cleanouts, manholes or other fixed features.
3. Dimension pipe length and distance from other features.
4. Label diameter, bends, material type of pipe and depth at cleanouts.



Call before you dig:

1-800-424-5555 (or 811)