



MADE IN U.S.A.  
LOGEYBROS BROS CO.  
ENGINEERING, DESIGN, PLANS, SPECIFICATIONS

MADE IN U.S.A.  
LOGEYBROS BROS CO.  
ENGINEERING, DESIGN, PLANS, SPECIFICATIONS

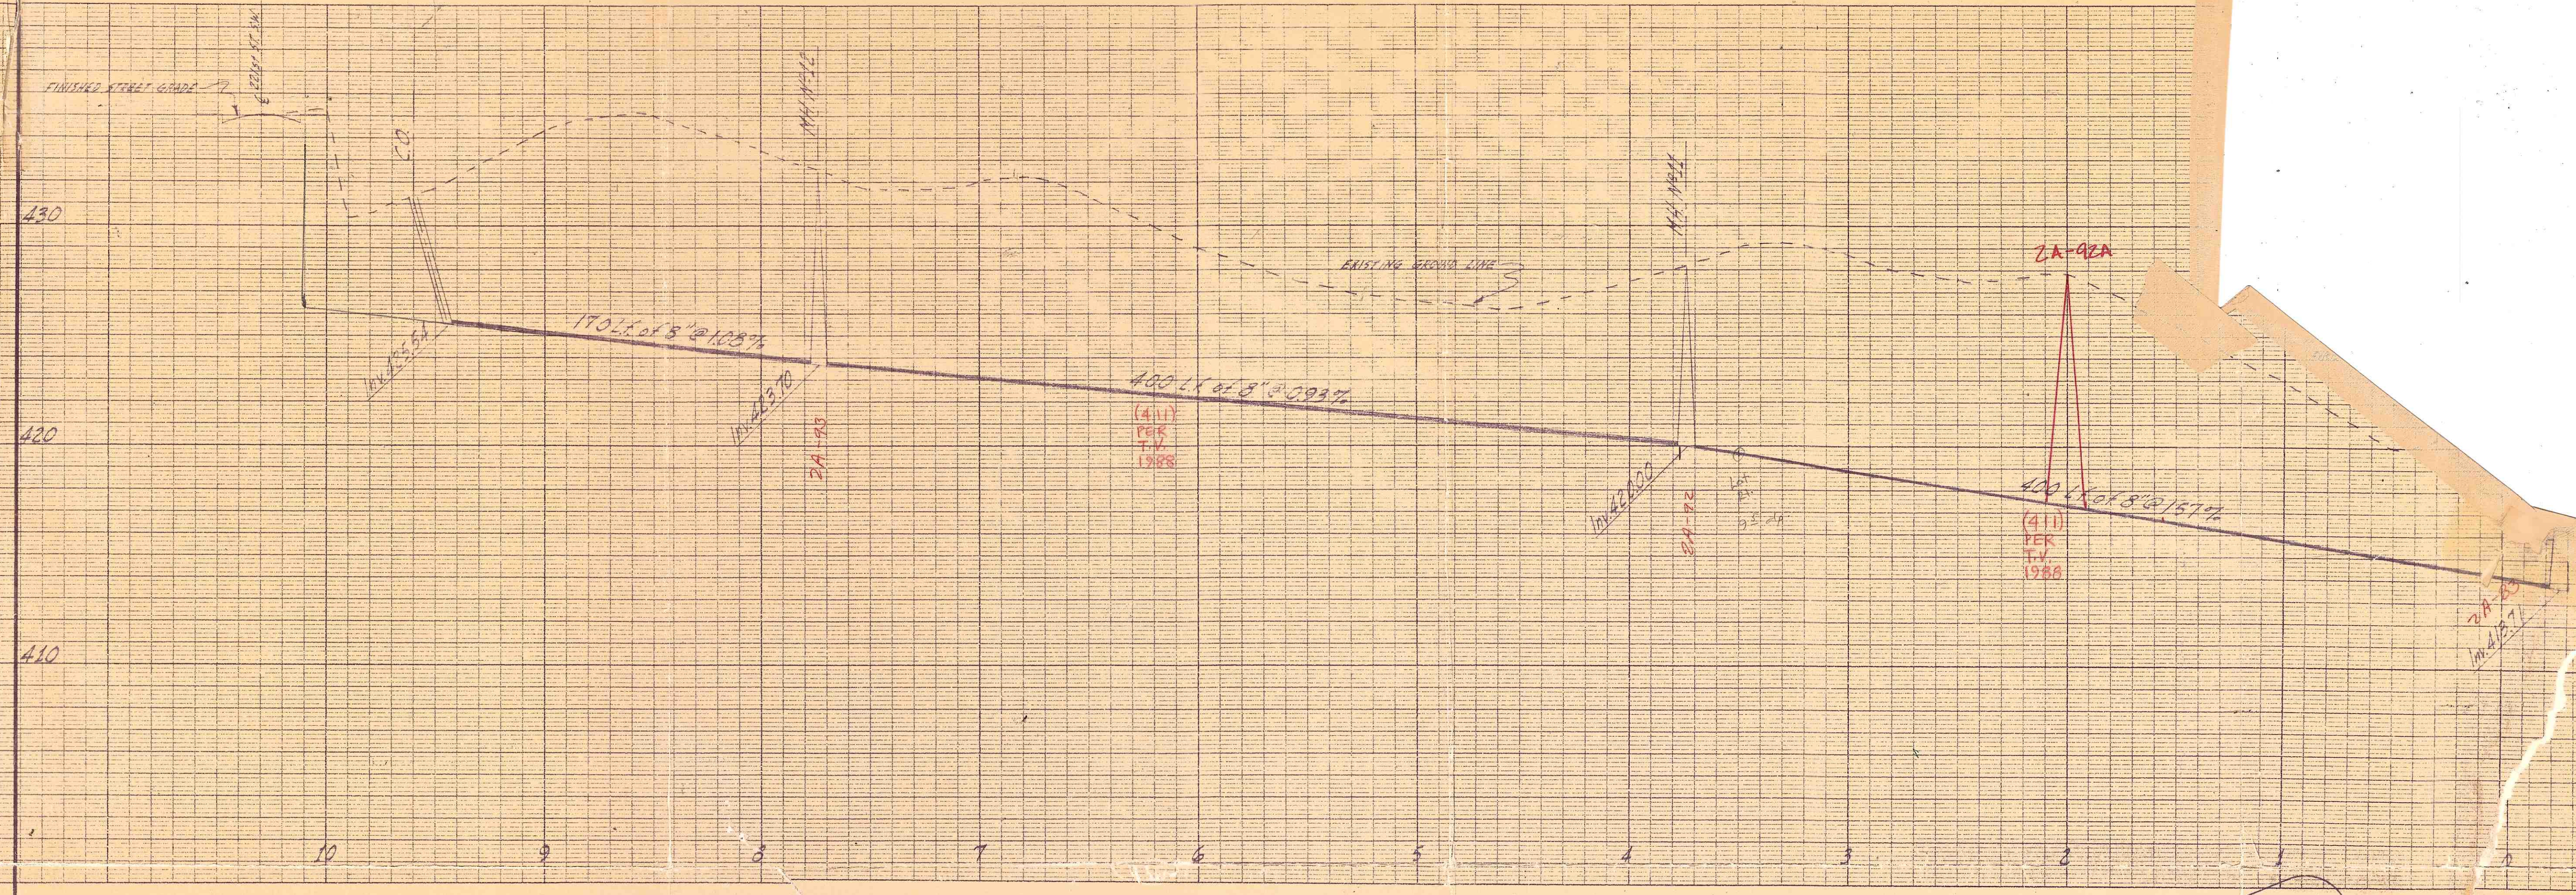

Scan Name: scans06384.pdf  
Scan Date:

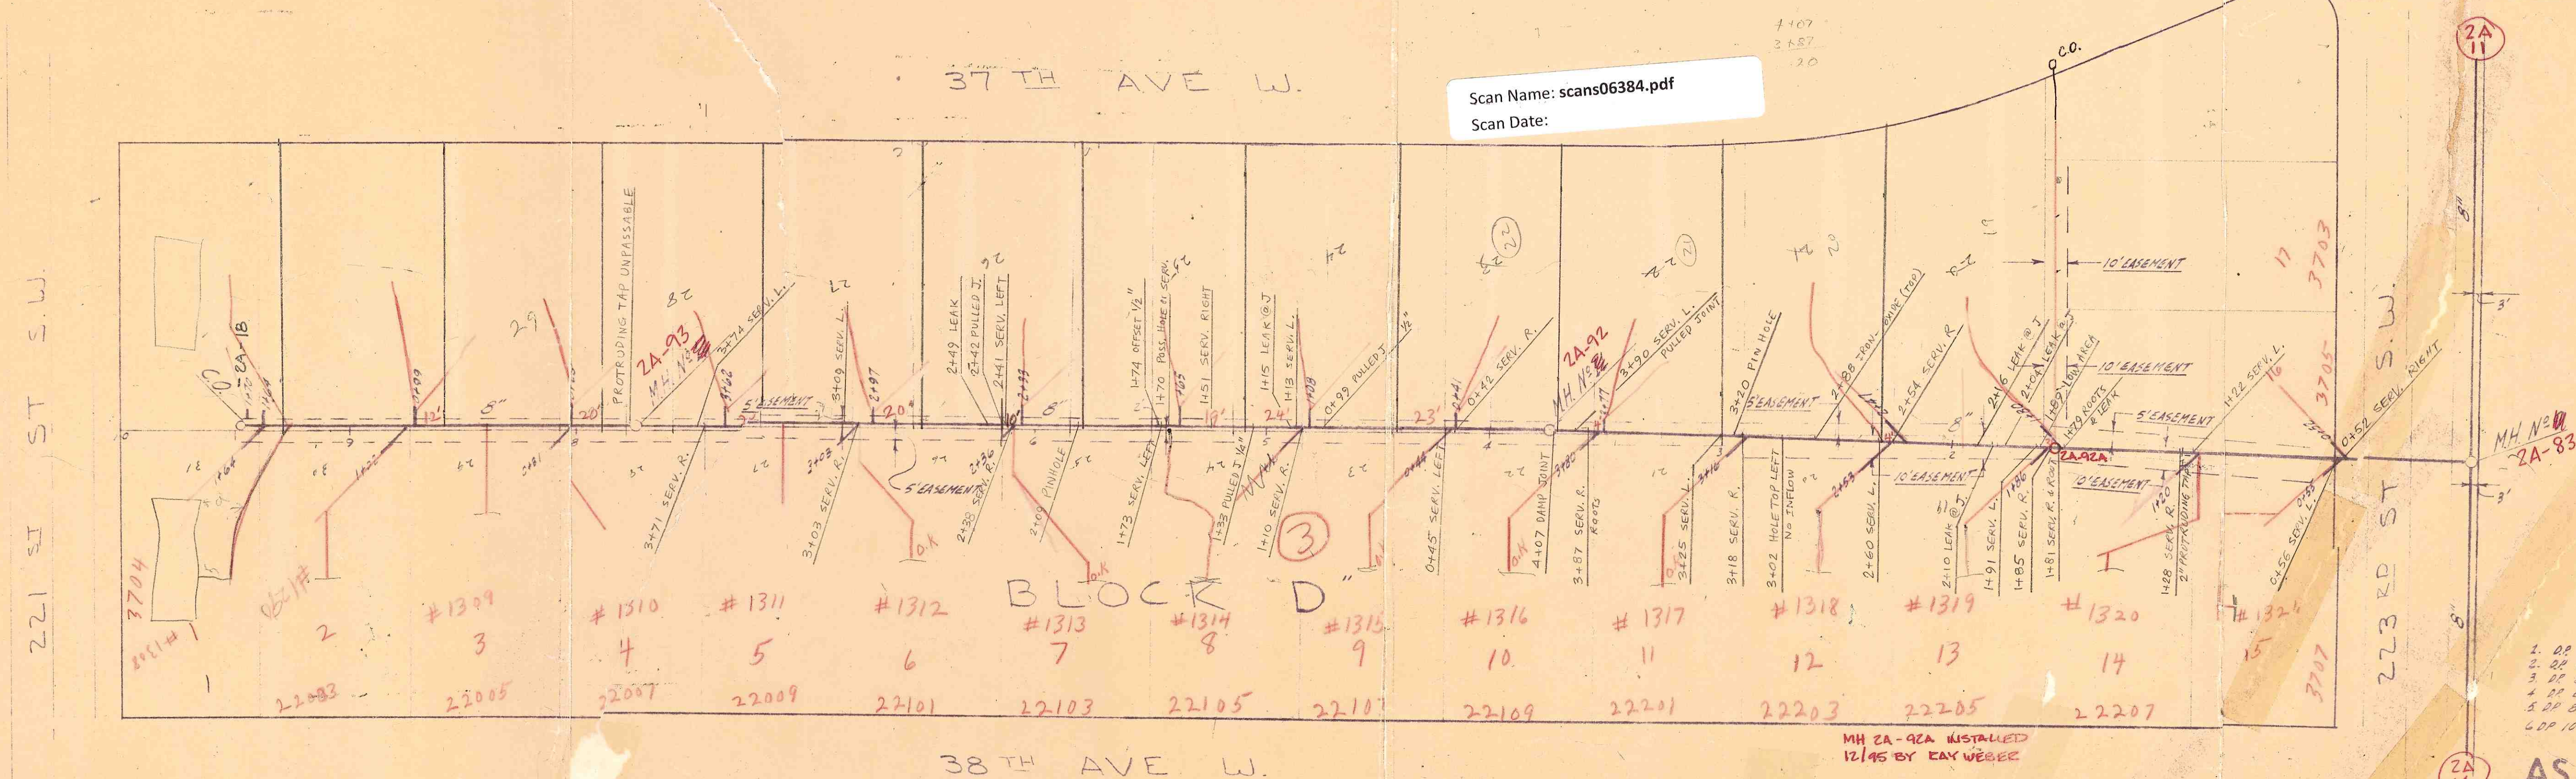

- REVISIONS
- 1. DP 8-12-60 REVISED PROFILE TO MSL DATUM
  - 2. DP 8-12-60 RE-DESIGNED SANITARY LINES
  - 3. DP 8-12-60 RELOCATED M.H. 2A-4 WEST OF ORIGINAL LOCATION
  - 4. DP 8-17-60 CHANGED LOT BOUNDARY LINES
  - 5. DP 8-17-60 EXTENDED CO. 17" NORTH
  - 6. DP 10-11-60 ADDED 'AS BUILT' TIE LOCATIONS

AS BUILT DRAWING

BALCH & COGLAS' PLAT OF 'CEDARGROVE'

SANITARY SEWER 2A-15  
BLOCK 'D'

JAMES H. REID & ASSOCIATES  
CONSULTING ENGINEERS  
EDMONDS, WASHINGTON

SCALE 1" = 40'  
DATE June 1958  
DESIGN [Signature]  
DRAWN [Signature]