

SIDE SEWER ASBILT

OUTSIDE ☒ INSIDE ☐ REPAIRS ☐

OWNER Seabrook Development

CONTRACTOR Lynnwood Septic



PERMIT No. 4-91-13

HOUSE No. 23902 44 Ave. W.

STREET
AVENUE LOT No. 44th Ave W

BLOCK No. _____

NAME ADD. Summer Crest

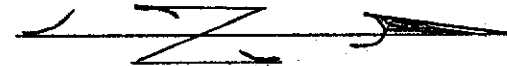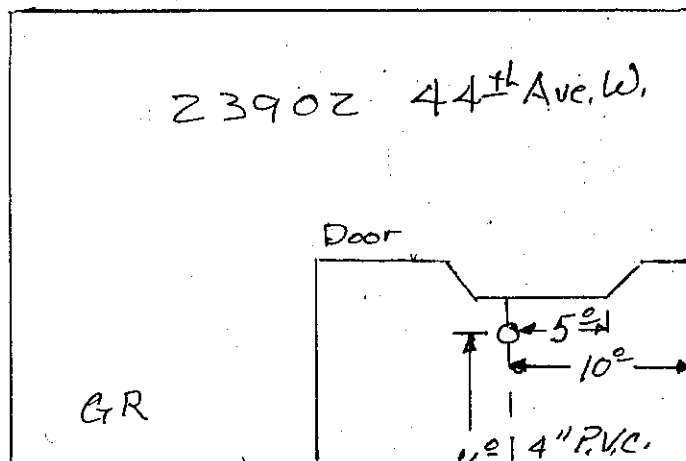

8" sewer

44th Ave. W.

SEWER WORK ORDER ISSUED April 30, 91

BY Betty Williams

FEE 30⁰⁰

C.I. FEE _____

BACKFILL APPROVED

May 2, 1991

BY Ben Van Deren

ASBILT May 3, 1991

BY Ben