

## APPLICATION

for

## SIDE SEWER PERMIT

OUTSIDE ☐ INSIDE ☐ REPAIRS ☐ALBERT ~~PAUER~~

CARD No. 6519CR

EASEMENT No. 1380822

The City of Mountlake Terrace

OWNER ALBERT S. GIEGER

CONTRACTOR DUARZIT CONSTRUCTION

PERMIT No. 1879

HOUSE No. 22310 58 WEST

STREET A PORTION OF THE S 1/2 OF THE N 1/2 OF THE SW 1/4

AVENUE LOT No.

BLOCK No.

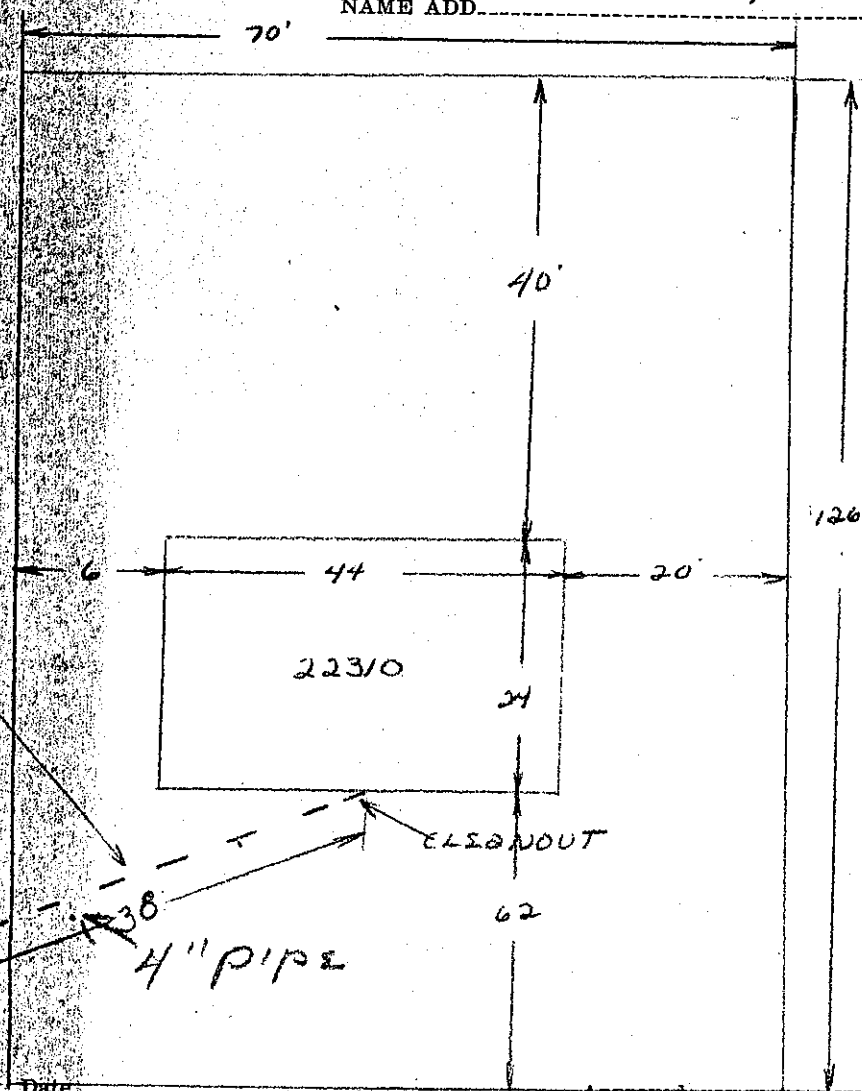
NAME ADD.

OF THE NW 1/4 OF THE SW 1/4 OF SECTION 28.

CITY OF  
MOUNTLAKE TERRACE

MAR 7 1960

Plan Approved

PROPOSED  
SEWER LINEEASEMENT  
WITH 22312

Date

58 WEST

Approved:

BACKFILL WORK ORDER ISSUED

DEPOSIT, \$10 3-7-60

SEWER WORK ORDER ISSUED

DATE 3-8-60

BY Scott M. Holton INSTEAD

739  
lt