

The City of Mountlake Terrace

APPLICATION

for

SIDE SEWER PERMIT


OUTSIDE ☒ INSIDE ☐ REPAIRS ☐

CARD No. _____

EASEMENT No. _____

OWNER AFFIRMATIVE HOME BLDG CONTRACTOR UNITED CONT. SHIRLEY WICK PERMIT No. U-17-80

HOUSE No. 22905-63 W STREET AVENUE LOT No. _____ BLOCK No. _____

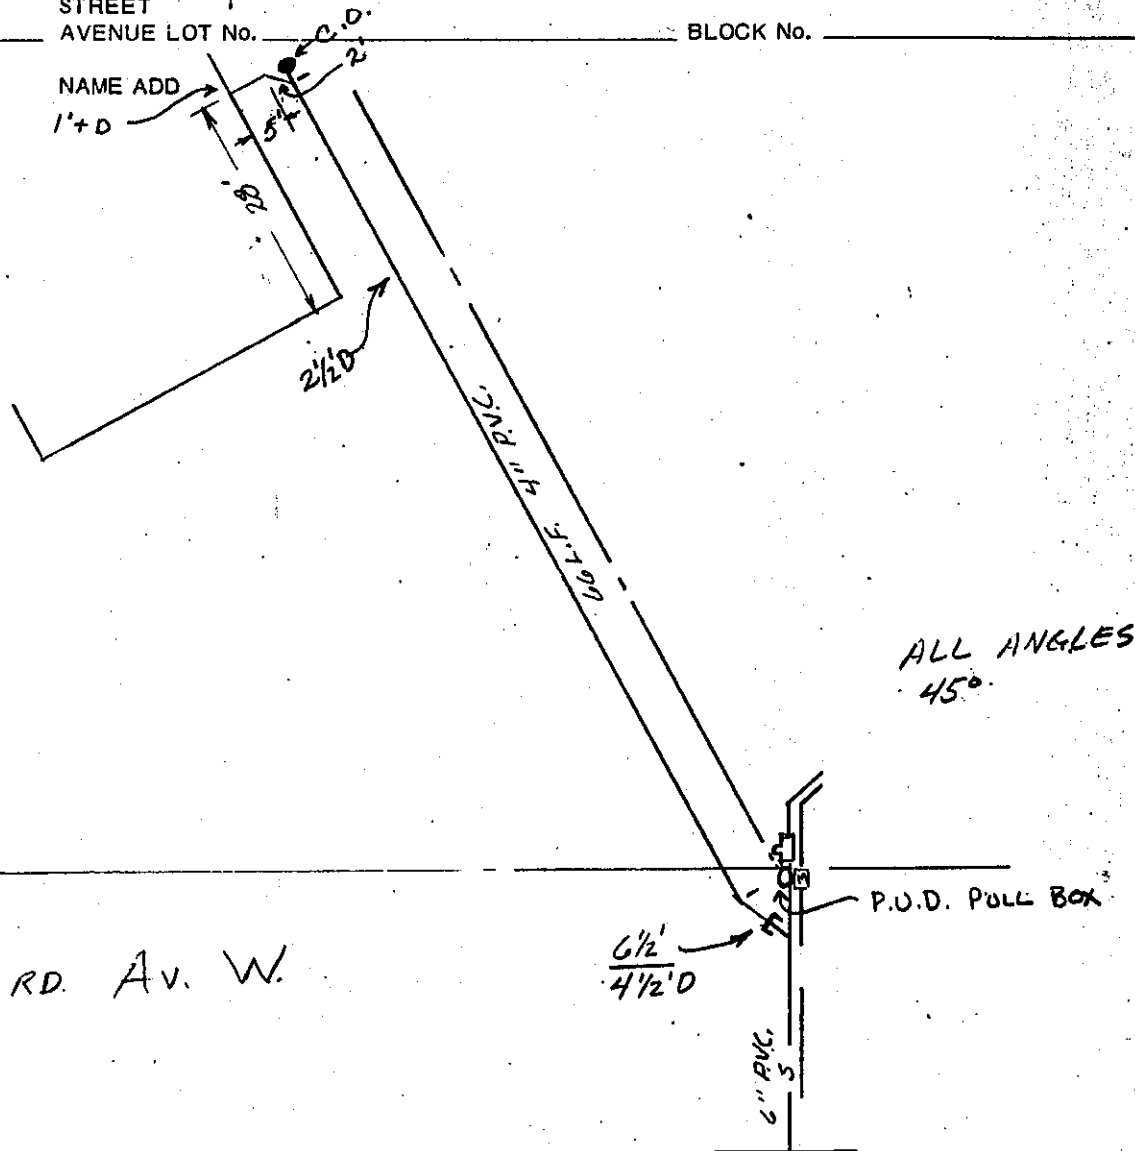

63 RD. AV. W.

ALL ANGLES
45°

P.U.D. PULL BOX

6 1/2'
4 1/2' D

6\"/>

Date

Approved:

BACKFILL WORK ORDER ISSUED _____ DEPOSIT, \$ _____

SEWER WORK ORDER ISSUED _____

DATE 8/22/80 BY R. Gonzales