


| NAME | DATE | TIME | REMARKS |
|--------|---------|------|---------|
| L.H.N. | 2-16-59 | | |
| R.P. | 3-6-59 | | |
| J.E.M. | 2-16-59 | | |
| J.W. | 2-20-59 | | |

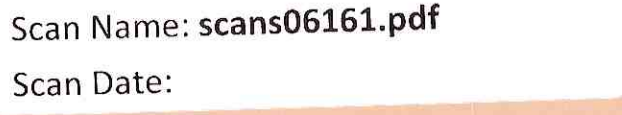

AS BUILT DRAWING

JAMES H. REID & ASSOCIATES
CONSULTING ENGINEERS, 324 MAIN ST., EDMONDS, WASH.

| | | | | | |
|--------|-------|---------|---------|-----------------|-------------------|
| DESIGN | DRAWN | CHECKED | DATE | H. SCALE 1"=50' | FILE NO. 550/1-23 |
| L.N. | H.H. | L.N. | 3-30-59 | V. SCALE 1"=10' | SHEET 23 OF 26 |

CITY OF MOUNTLAKE TERRACE
SEWERAGE SYSTEM UNIT 1