

APPLICATION

The City of Mountlake Terrace

SIDE SEWER PERMIT

OUTSIDE ☐ INSIDE ☐ REPAIRS ☐


CARD No. _____

EASEMENT No. _____

OWNER Nord Horns CONTRACTOR Lynnwood Septic Tank Co PERMIT No. 4085

HOUSE No. 5581 - 214 pl SW STREET _____ AVENUE LOT No. 17 BLOCK No. _____

NAME ADD. _____

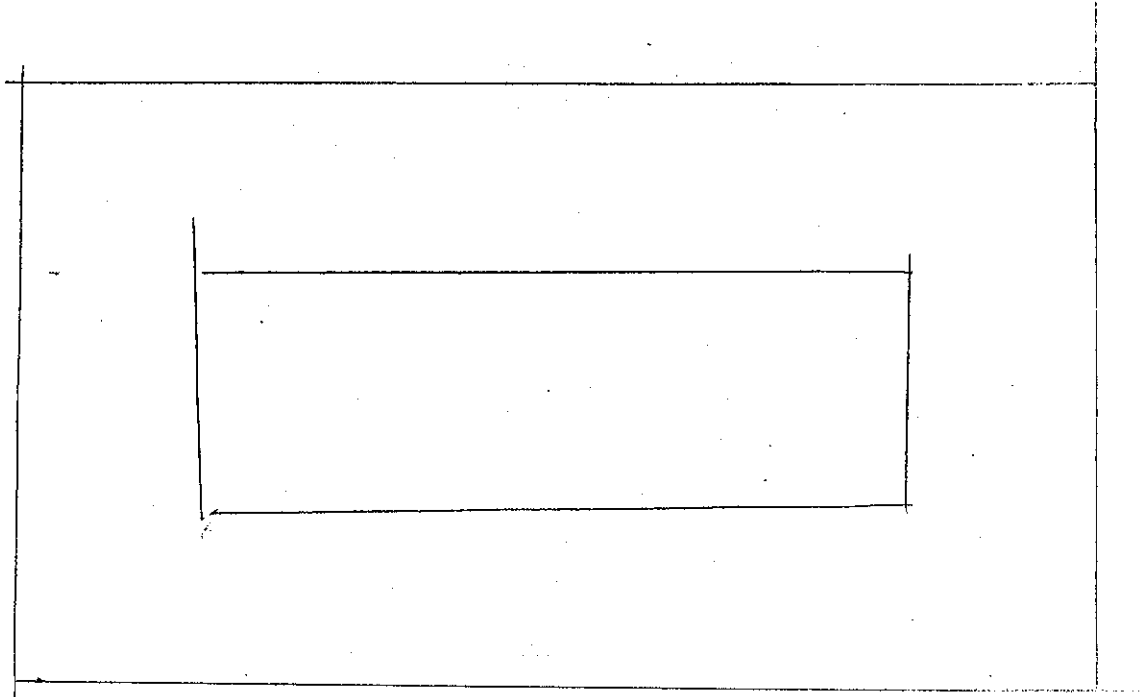

[Handwritten signature]

Date _____

Approved: _____

BACKFILL WORK ORDER ISSUED _____ DEPOSIT, \$ 10 -

SEWER WORK ORDER ISSUED _____

DATE _____ BY _____

[Handwritten signature]