

PLAN	NO.	SURVIVED NOTED PLOTTED CHECKED BY DATE

PROFILE	NO.	SURVIVED NOTED PLOTTED CHECKED BY DATE

PROFILE	NO.	SURVIVED NOTED PLOTTED CHECKED BY DATE

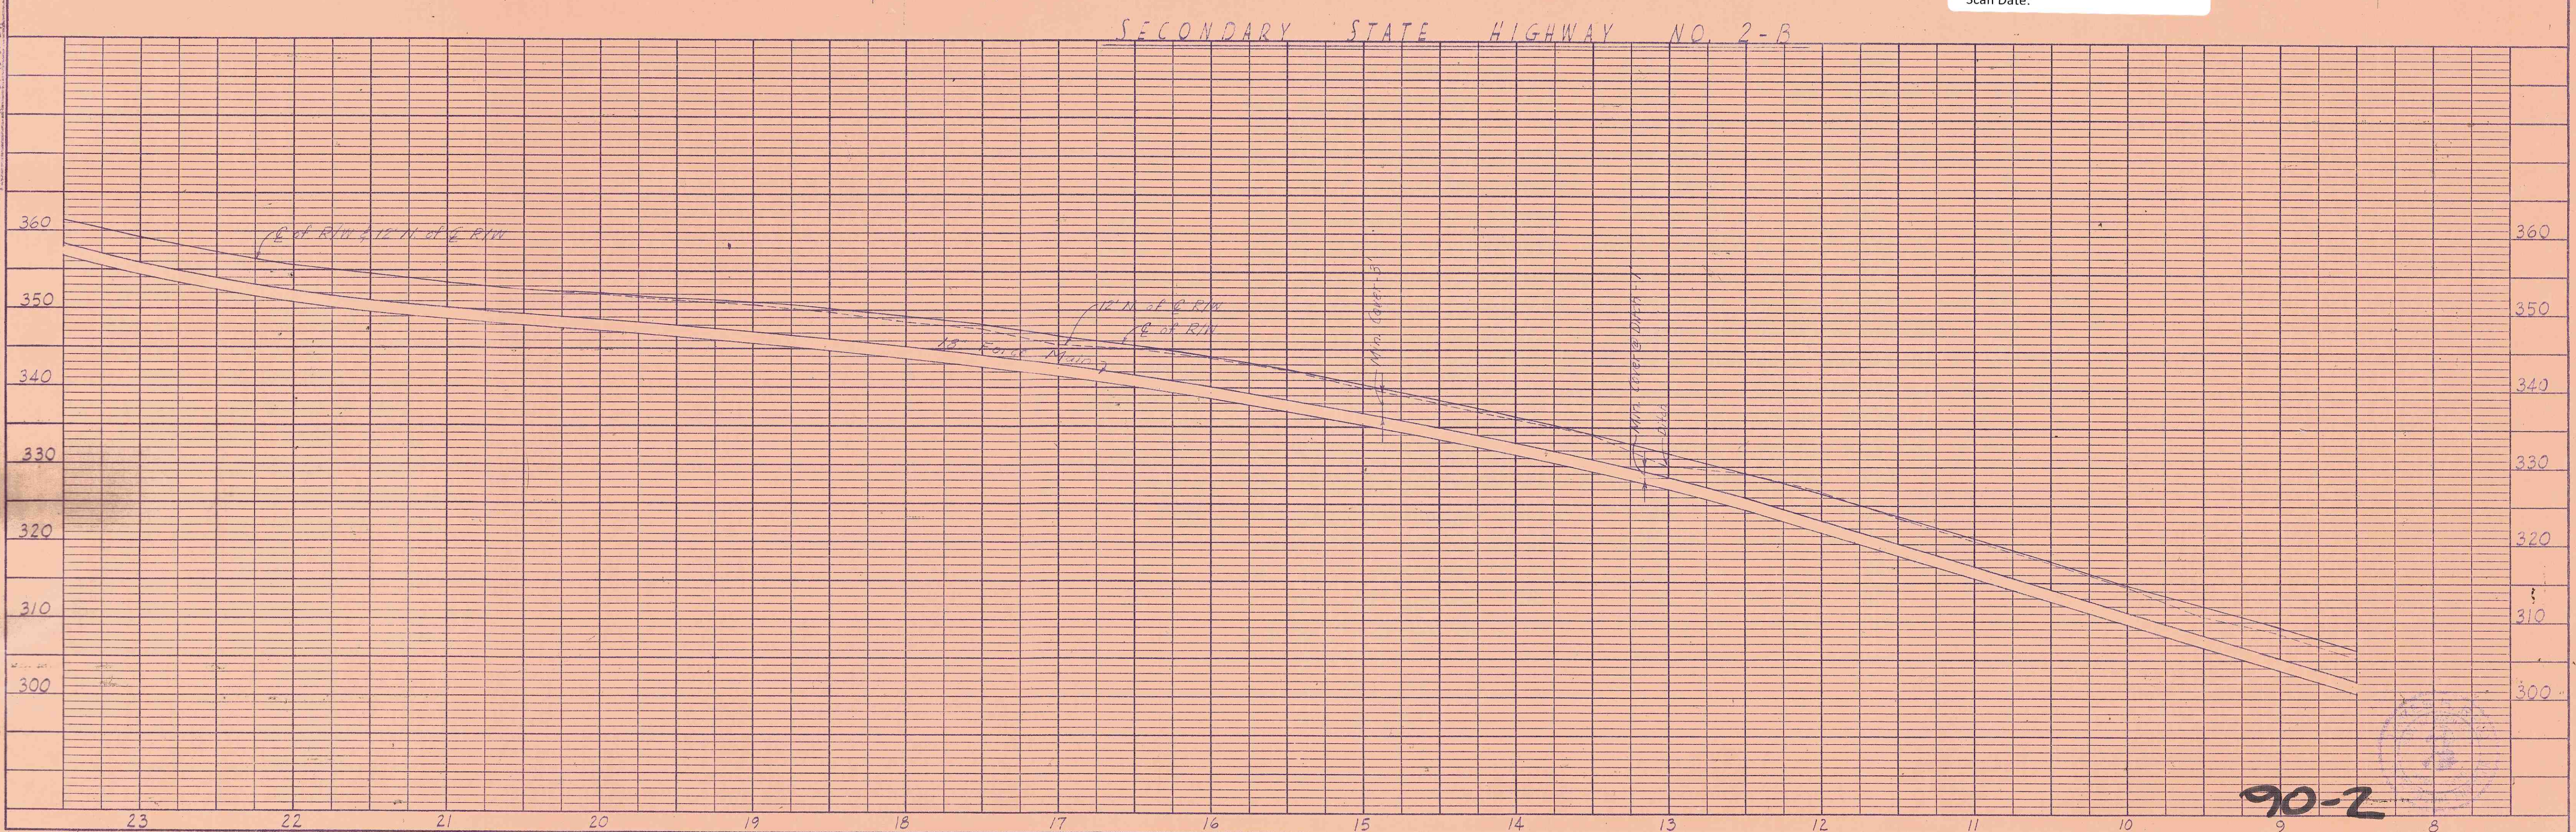
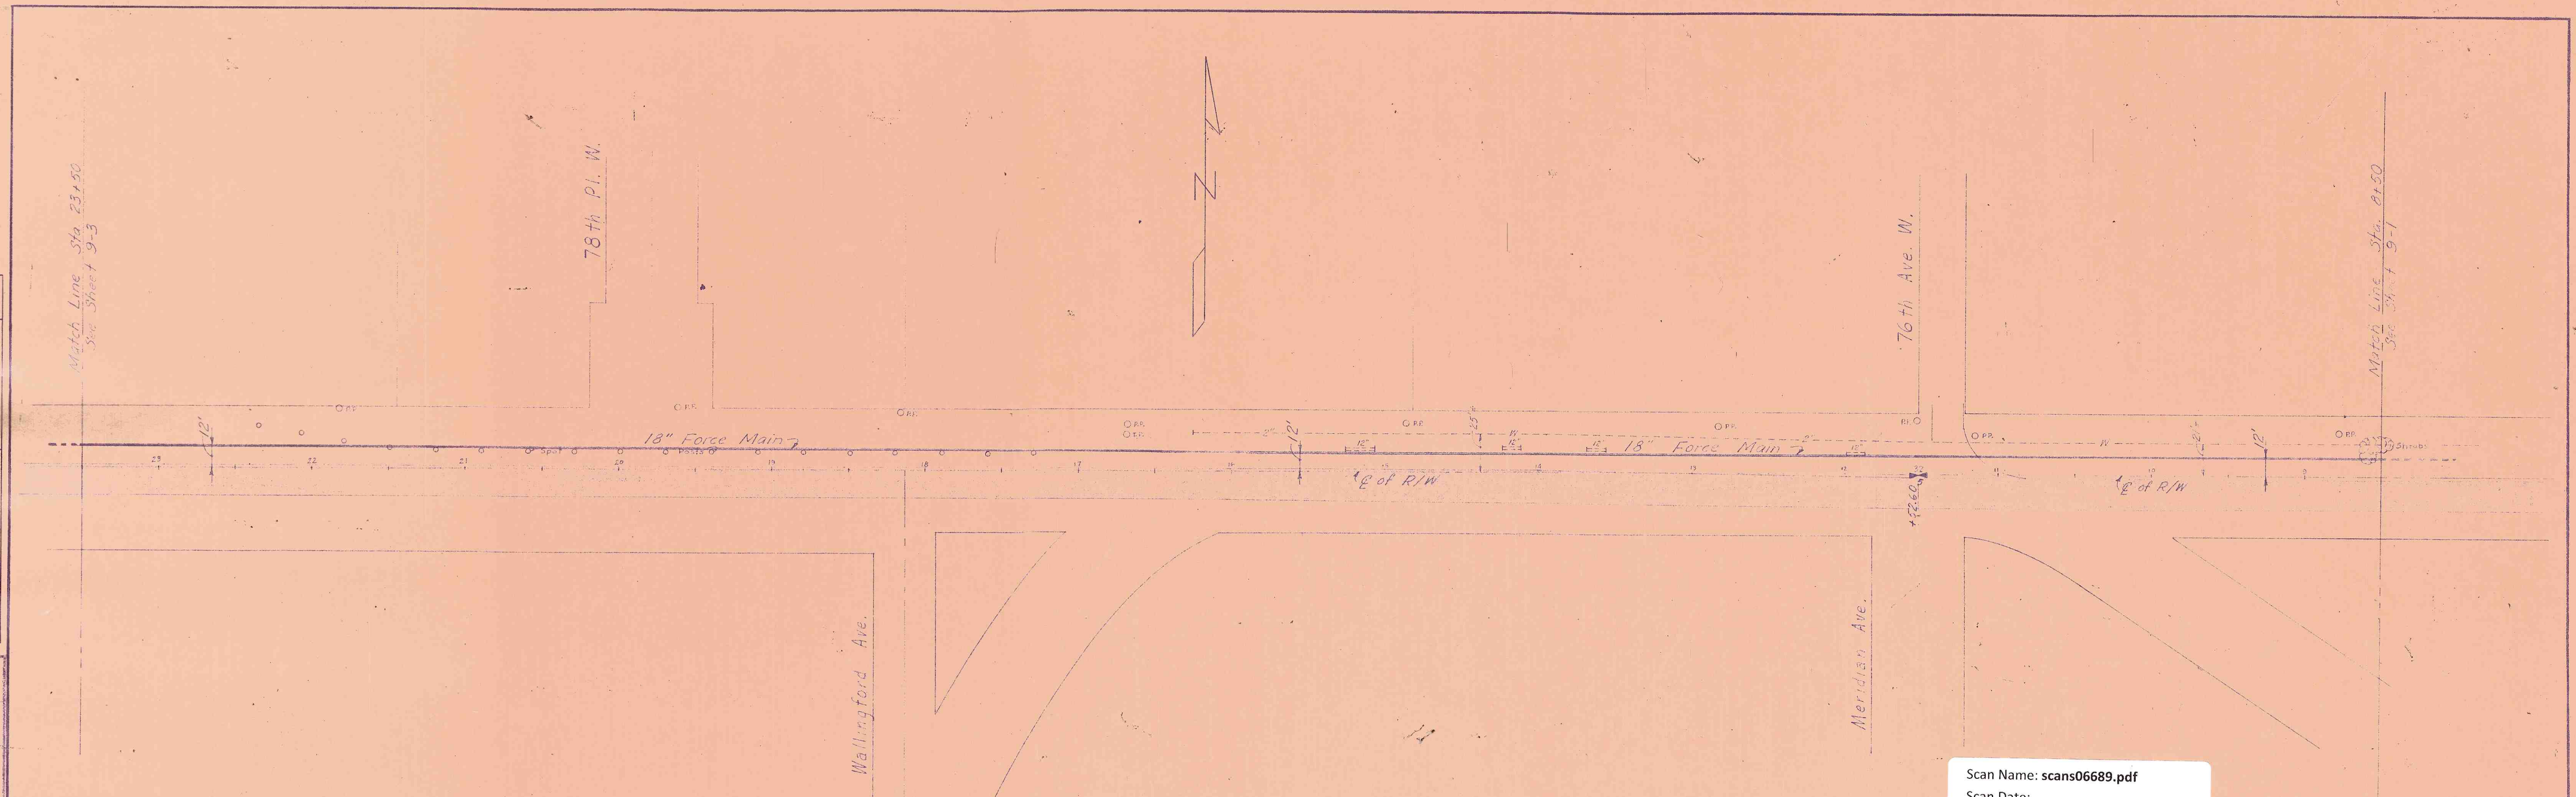


PLATE 1-PLAN-PROFILE-F.A.S.
CLEARPRINT PAPER CO., S.F. CAL.
No. 1000H-2

JAMES H. REID & ASSOCIATES
CONSULTING ENGINEERS, 324 MAIN ST., EDMONDS, WASH.

DESIGN	DRAWN	CHECKED	DATE	H. SCALE	V. SCALE	FILE NO.
L.H.N.	L.H.N.	L.H.N.	3-30-57	1"=50'	1"=10'	550/9-2

SHEET 2 OF 3

AS BUILT DRAWING

CITY OF MOUNTAIN LAKE TERRACE
SEWERAGE SYSTEM UNIT 9