

APPLICATION

CARD No. *COPY*

The City of Mountlake Terrace

SIDE SEWER PERMIT

OUTSIDE ☒ INSIDE ☐ REPAIRS ☐

EASEMENT No. _____

H & H Homes P O Box 644 Lynnwood, Wash 98036

Universal Utility Contractors Inc.

OWNER _____ CONTRACTOR 11/11/11 203rd St N E Woodenville PERMIT No. 7470

HOUSE No. 6603 ~~224TH ST SW~~ W STREET AVENUE LOT No. 6 BLOCK No. _____


224TH ST SW

NAME ADD Greenridge

Septic Feb 75

Permit No U 9 75 Q

Side Sewer Contractor Lynwood Septic

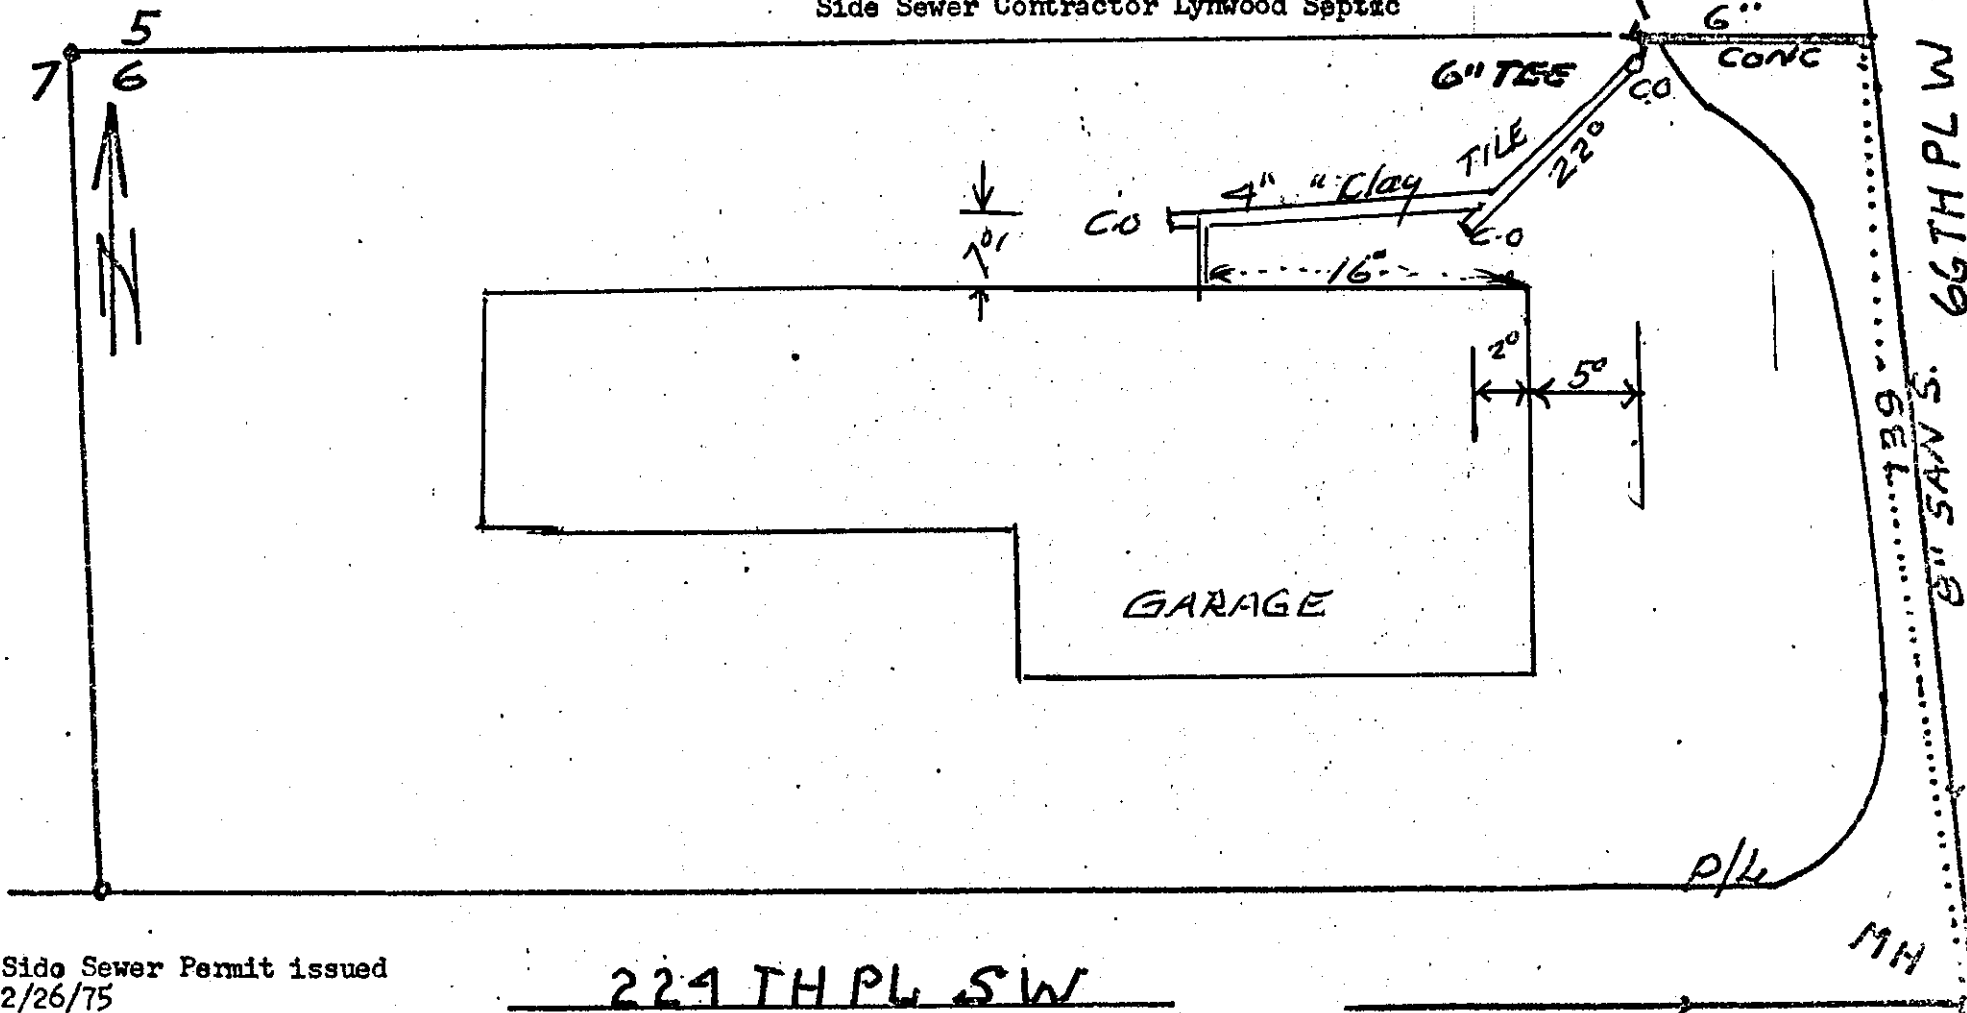

Side Sewer Permit issued
2/26/75

224TH PL SW

Side Sewer Installation approved 2-26-75 lpm F H Smith

JACKFILL WORK ORDER ISSUED. June 11, 1974 DEPOSIT, \$ 2000.55
SEWER WORK ORDER ISSUED May 16 1974

Approved:

June 20, 1974

DATE

BY

Fred H. Smith