

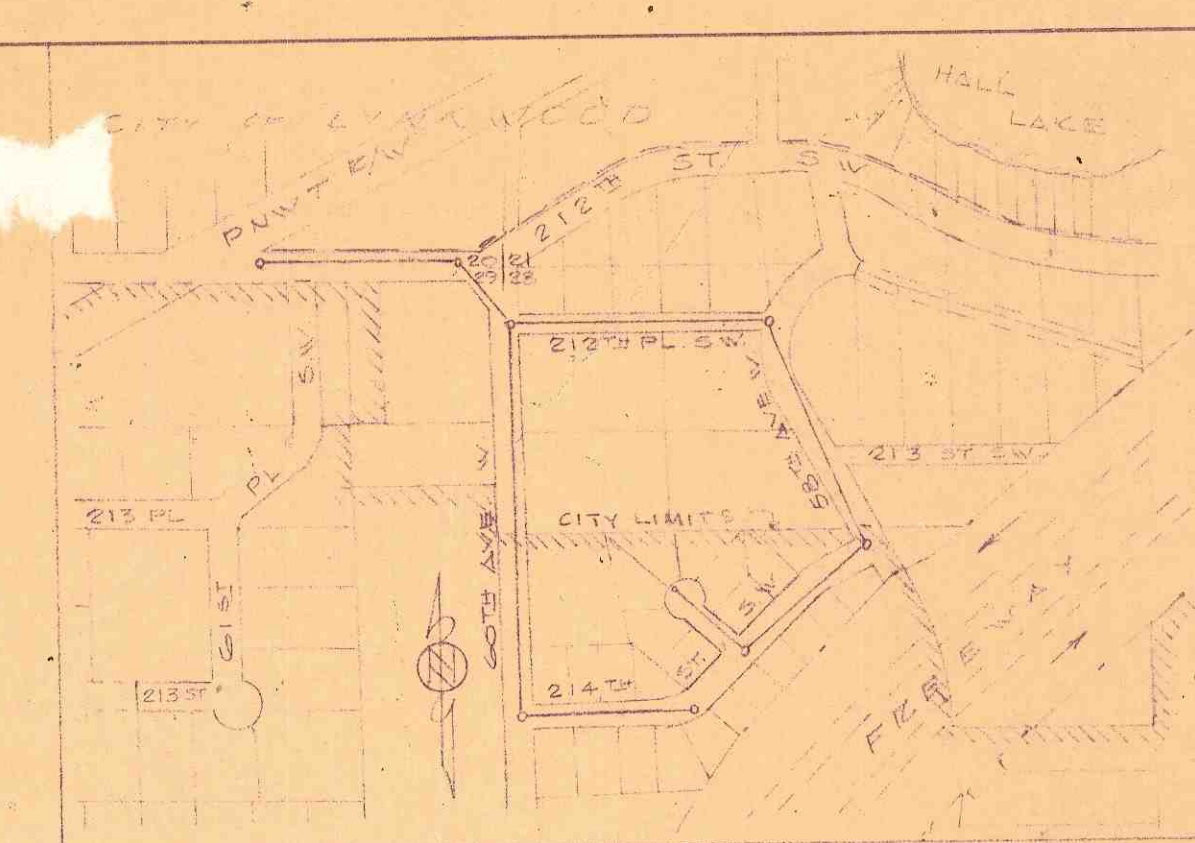
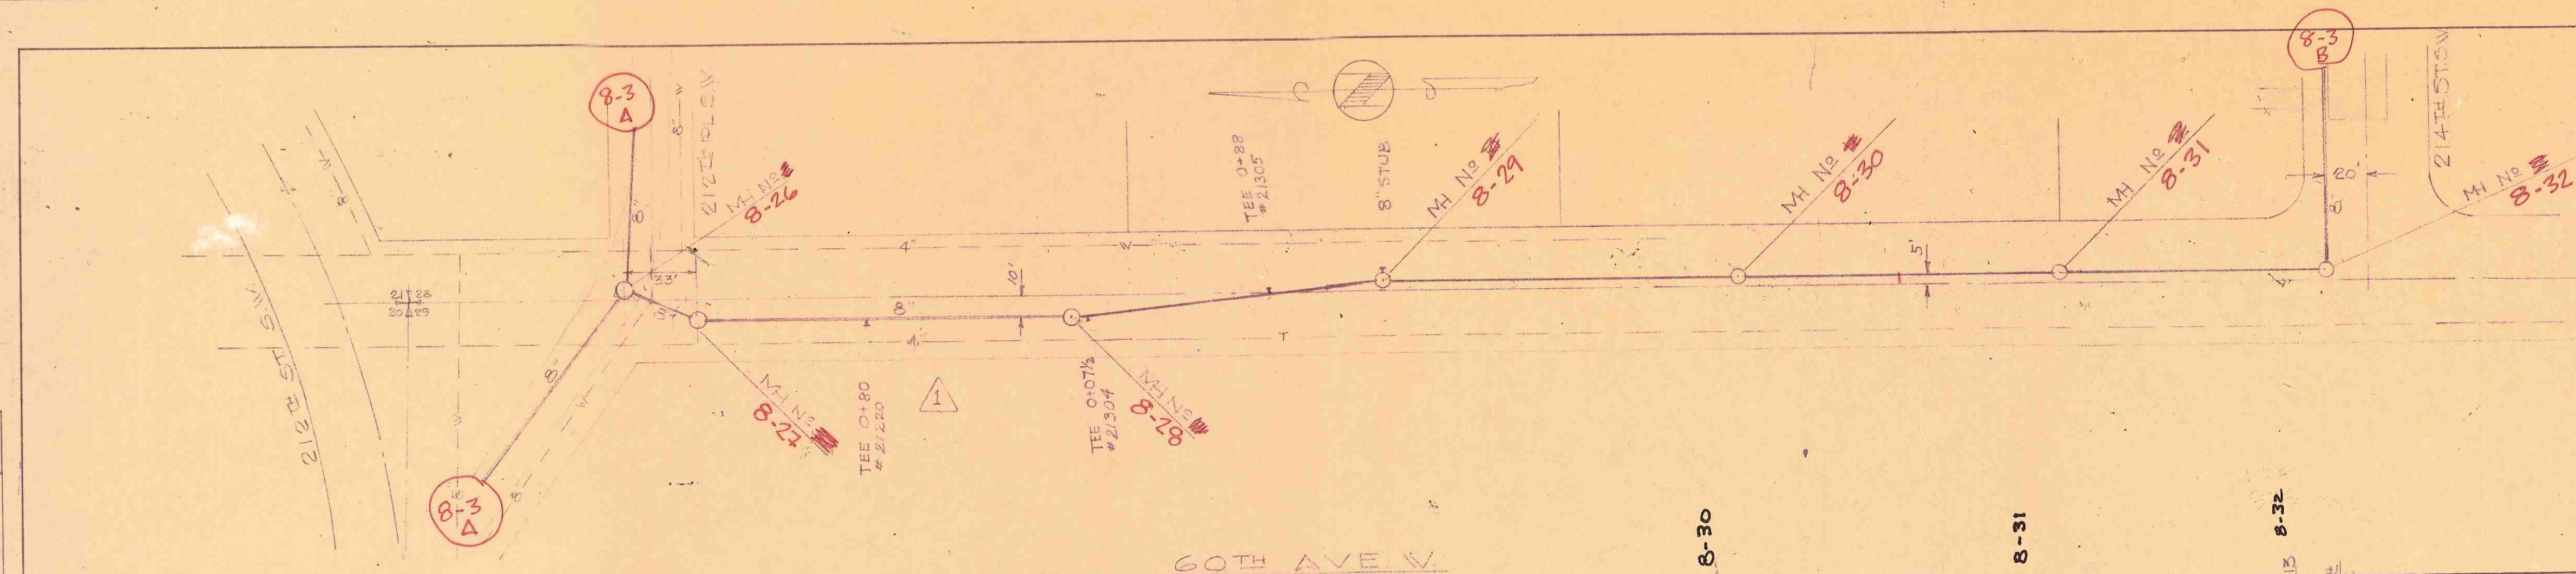


PROFILE	SURVEYED	BY	DATE
NOTE BOOK	PLOTTED	ED	
		DP	
	GRADER CHECKED		
	BY		

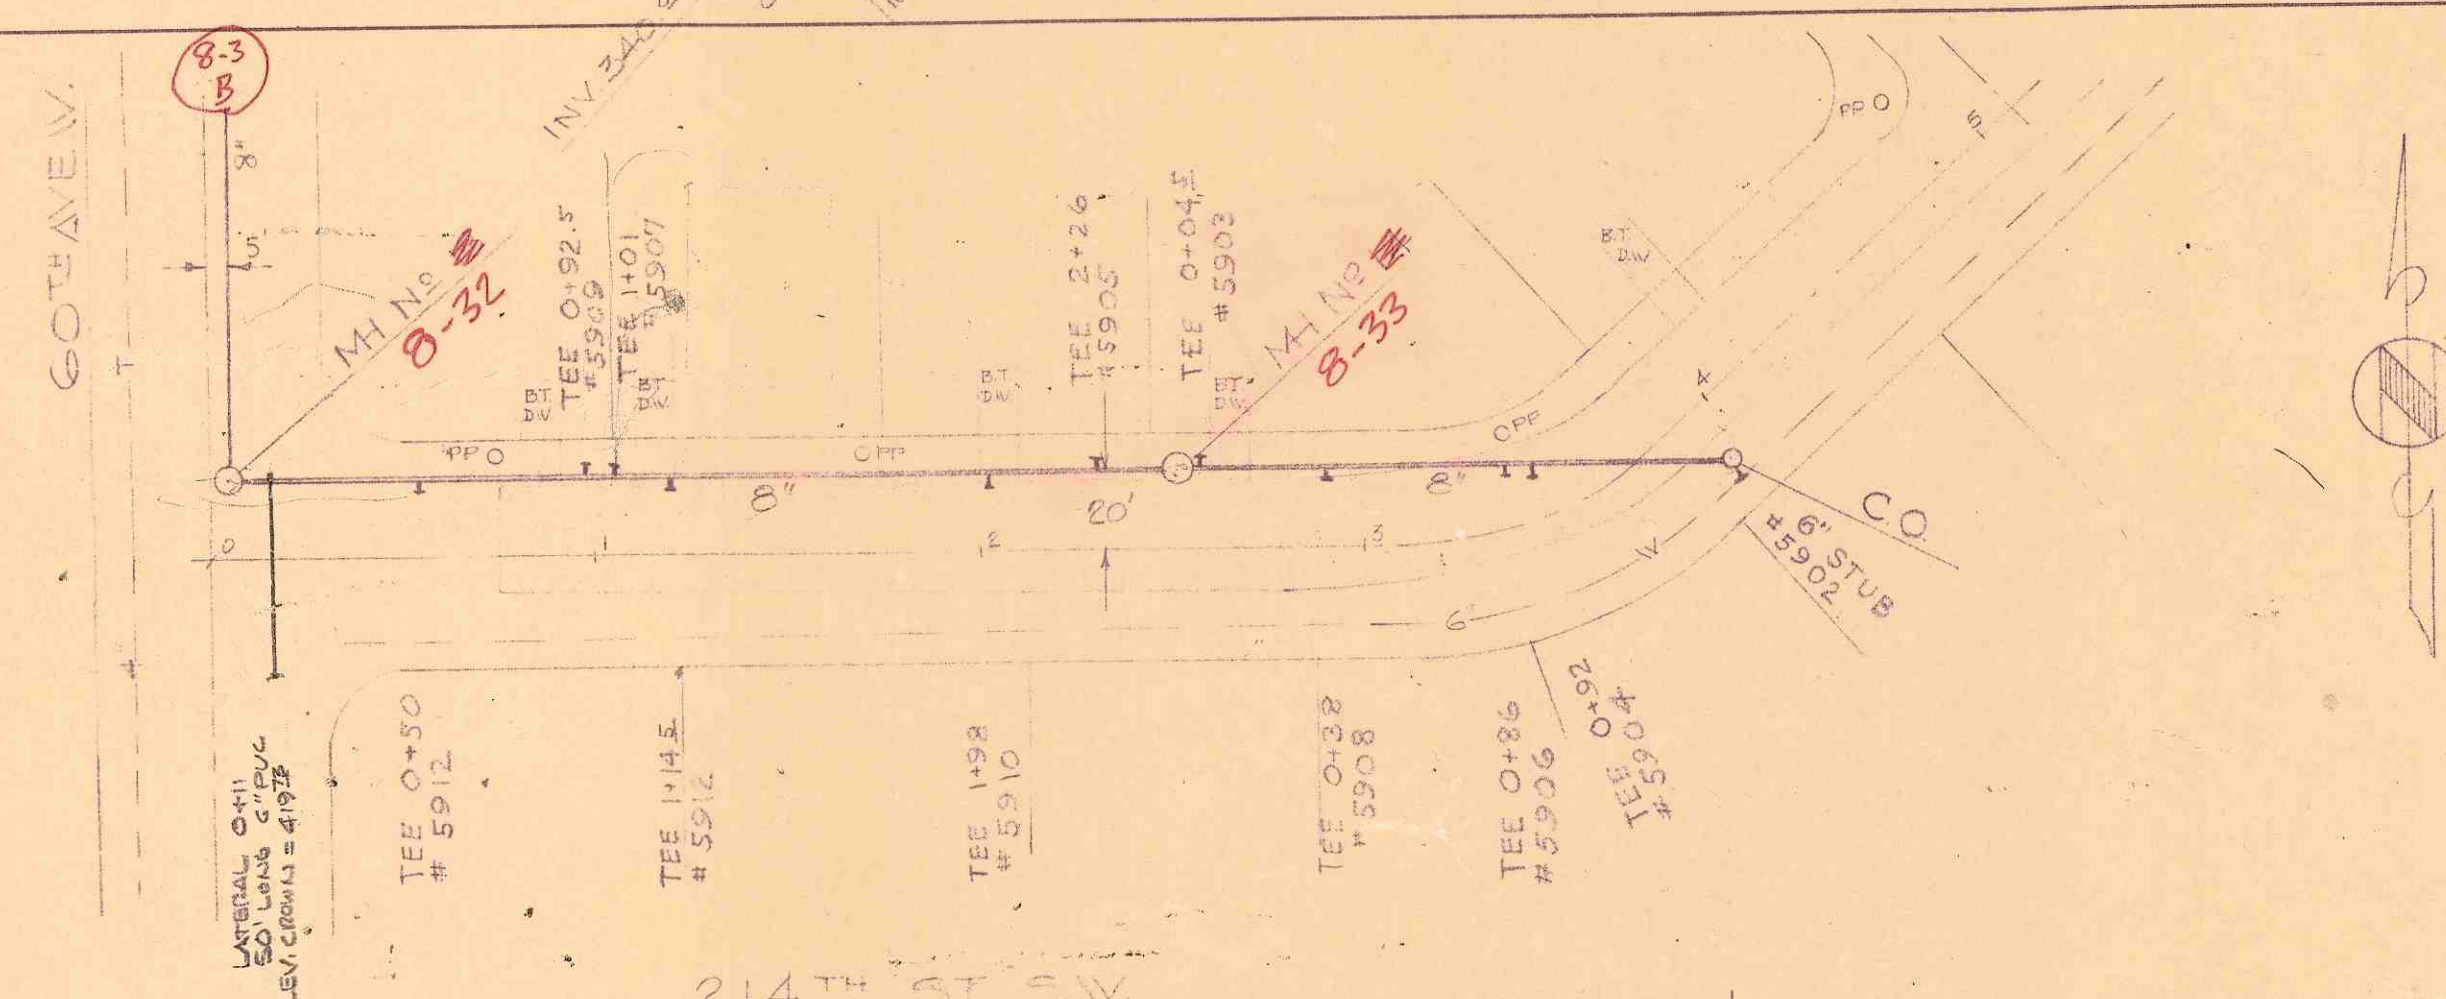

SITE PLAN
SCALE - 1" = 400'

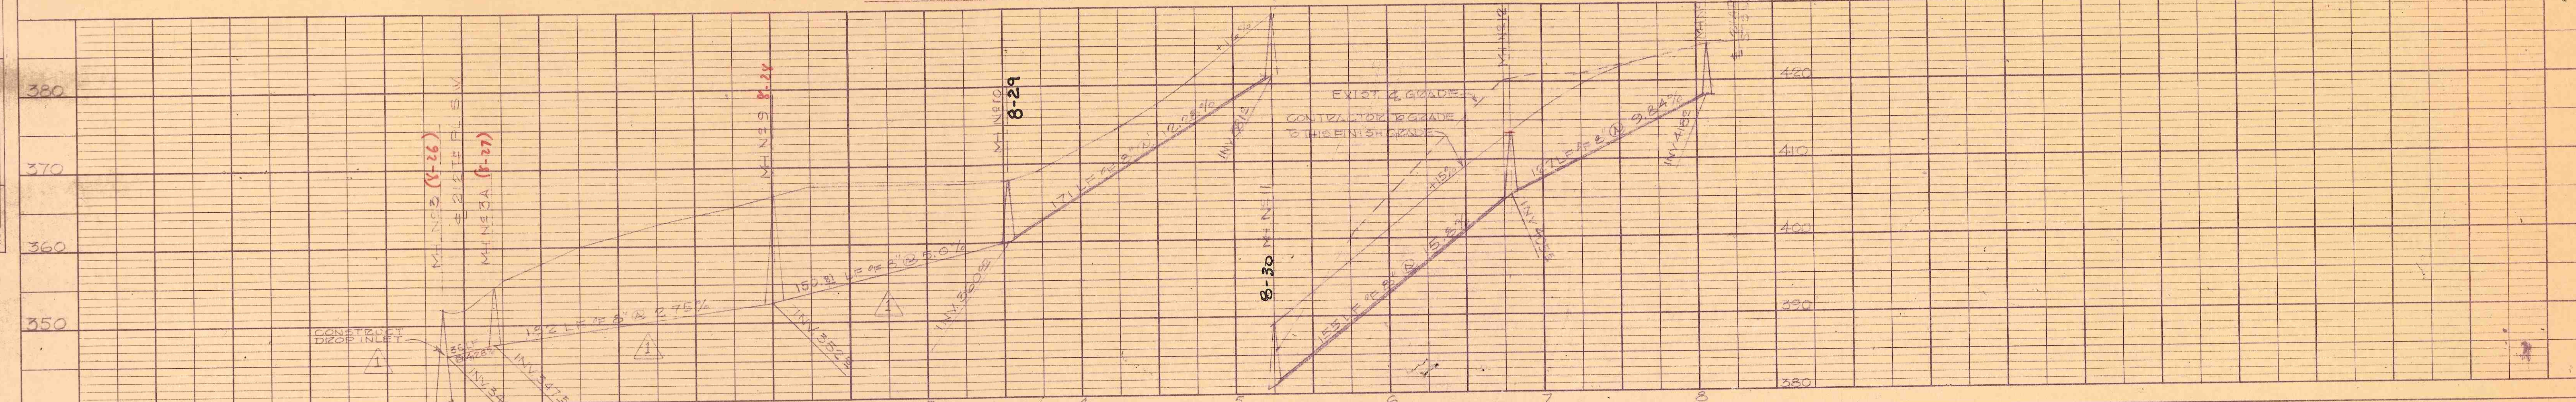

ASPH CONC SURFACED STREETS

ASPHALT SURFACED STREETS & GRAVEL SHOULDER
SHALL BE RESTORED IN ACCORDANCE WITH THE
APPLICABLE SECTIONS OF THE SPECIFICATIONS

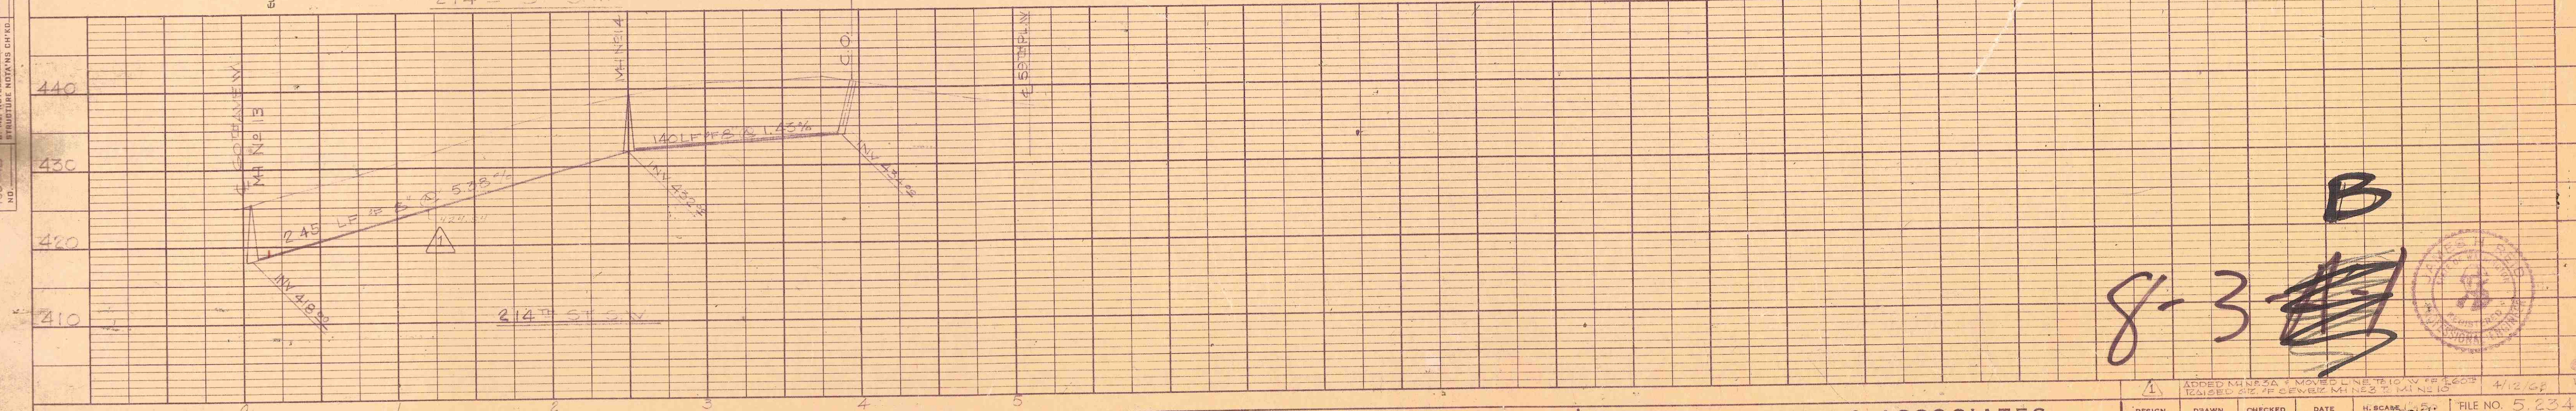


PLATE 2-PLAN-PROFILE O.P.R. & R.E. STANDARD
100% AGEPROOF VELLUM—MADE AND PRINTED IN U. S. A.
EUGENE DIETZEN CO.

REID, MIDDLETON & ASSOCIATES, INC
CONSULTING ENGINEERS & LAND SURVEYORS, 324 MAIN ST., EDMONDS, WASH

1 ADDED MIN 53A & MOVED LINE 1610 W F 1600 RAISED SIZE OF SEVER MIN 32 MIN 10					4/12/68	
DESIGN	DRAWN	CHECKED	DATE	H. SCALE	FILE NO. 5.234	
LN	2	2	1-21-63	V. SCALE 1:10	SHEET 2 OF 2	

"AS BUILT"

SEWER EXTENSION, WEST OF FREEWAY
IN VICINITY OF 21400 STS. & 3800 AVE. N.

5A-