


24 HOUR NOTICE
REQUIRED PRIOR TO NEED FOR
INSPECTION. CALL 24 HOUR REQUEST LINE
775-9894

**CITY OF MOUNTLAKE TERRACE
APPROVED PLAN**

DATE: _____
BY: _____

(EXCEPT WHERE NOTED) SUBJECT TO FIELD
INSPECTION AND COMPLIANCE TO ALL
APPLICABLE LAWS, CODES, ORDINANCES,
STANDARDS AND SPECIFICATIONS OF THE
CITY OF MOUNTLAKE TERRACE, WASHINGTON

Penhallegon Associates Consulting Engineers, Inc.
750 SIXTH STREET KIRKLAND, WA 98033
(206) 827-2014

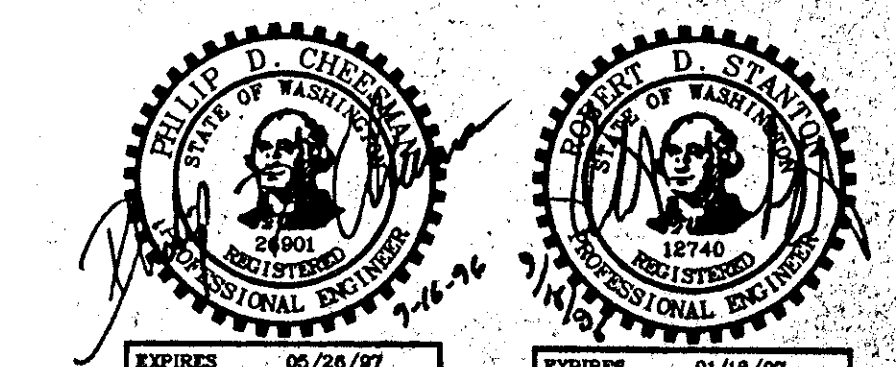

PAGE JOB NO. 95576.00
PROJECT NO.
DESIGN: PDC
DRAWN: JLC
CHECKED: PDC
DATE: 8/28/96
2-5-96

HARADER MEBUST GROUP, INC.
ARCHITECTURE • PLANNING • CONSULTATION
1218 WESTLAKE AVE. N. • SUITE 200
BENTLEY, WASHINGTON 98004 • (206) 294-4101
FAX NO. (206) 294-4035

CONTENTS
BIOFILTRATION SWALE
RECONSTRUCTION PLAN
SCALE 1" = 20'

PROJECT
EAST TERRACE II
4221 21ST STREET SW MOUNTLAKE TERRACE, WASHINGTON
OWNER: SNOHOMISH COUNTY HOUSING AUTHORITY

SHEET NO.
C3

AS-BUILT 221-76-4