

APPLICATION

The City of Mountlake Terrace

SIDE SEWER PERMIT

OUTSIDE ☐ INSIDE ☐ REPAIRS ☐

CARD No. _____


EASEMENT No. _____

H & H Homes

OWNER _____ CONTRACTOR Lynnwood Septic Tank PERMIT No. U-28-75

HOUSE No. 6609 224th Street S W STREET _____ AVENUE LOT No. Lot 9 BLOCK No. _____

NAME ADD Greenridge

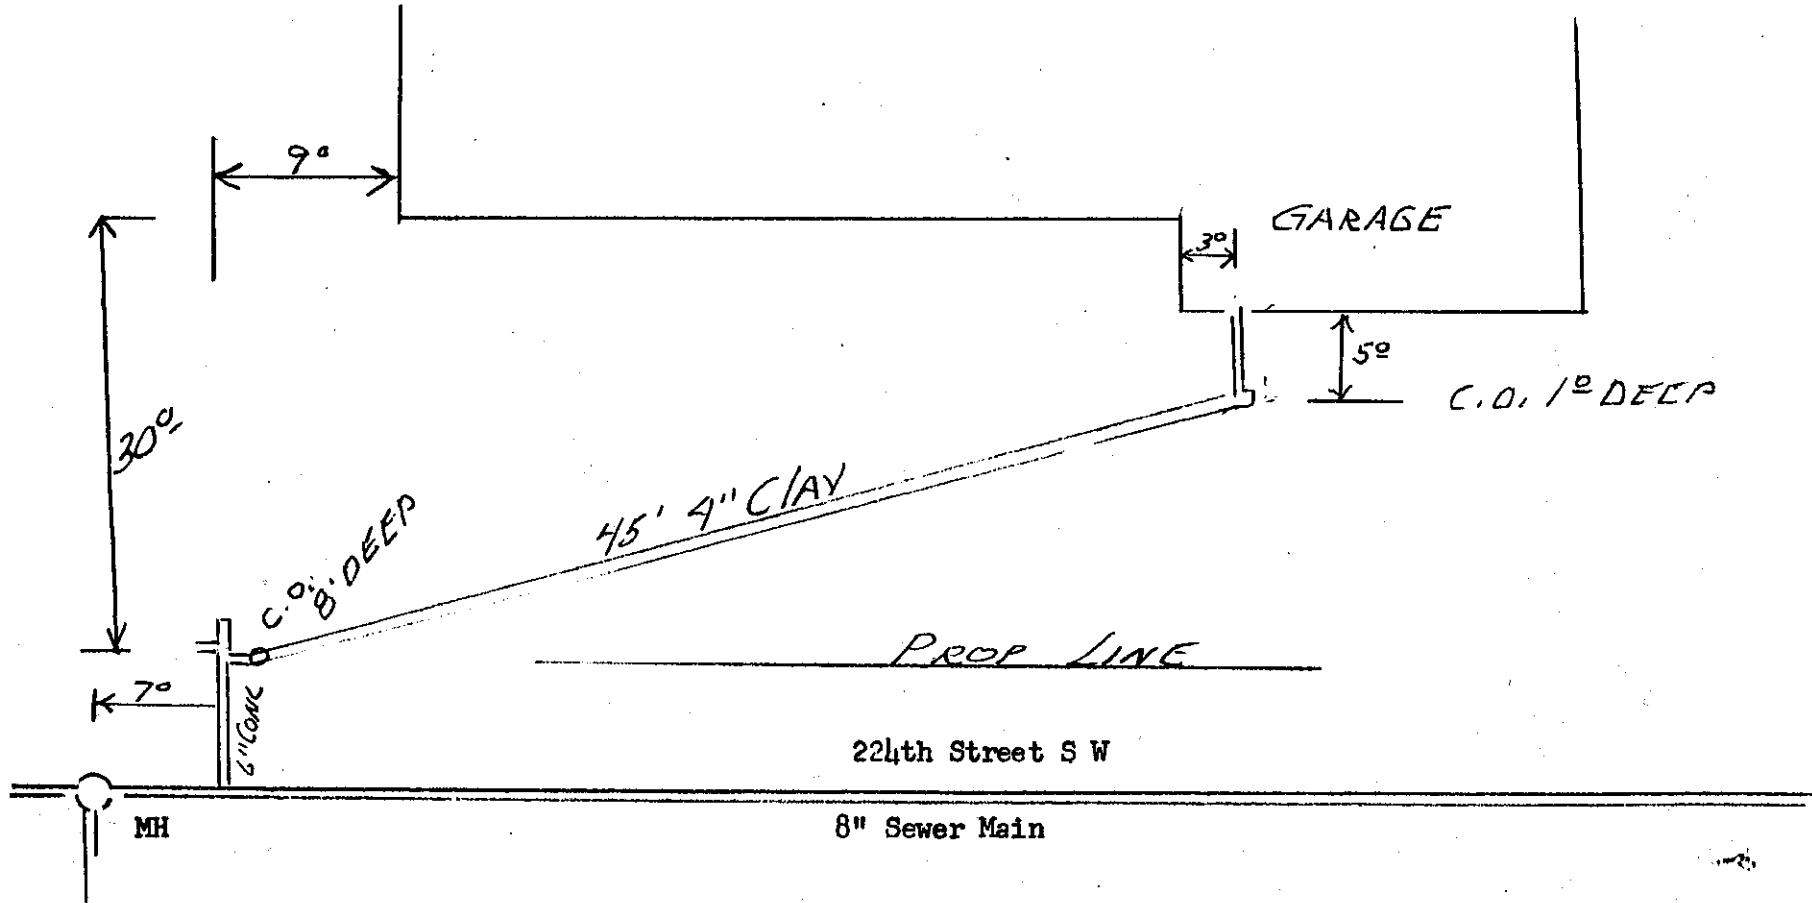

BACKFILL WORK ORDER ISSUED 4/1/75 Date _____ DEPOSIT, \$ 16.00 Approved: _____
 SEWER WORK ORDER ISSUED 4/1/75 DATE 4/1/75 BY F H Smith *[Signature]*