


<b>PROFILE</b>	SURVEYED	BY	DATE
	PLOTTED	<i>R.P.</i>	<i>10-12-58</i>
NOTE BOOK	GRADES CHECKED		
<i>4814-58</i>	B. M. & NOTED		<i>11-23-58</i>
NO. _____	STRUCTURE NOTATIONS CHIT'D		

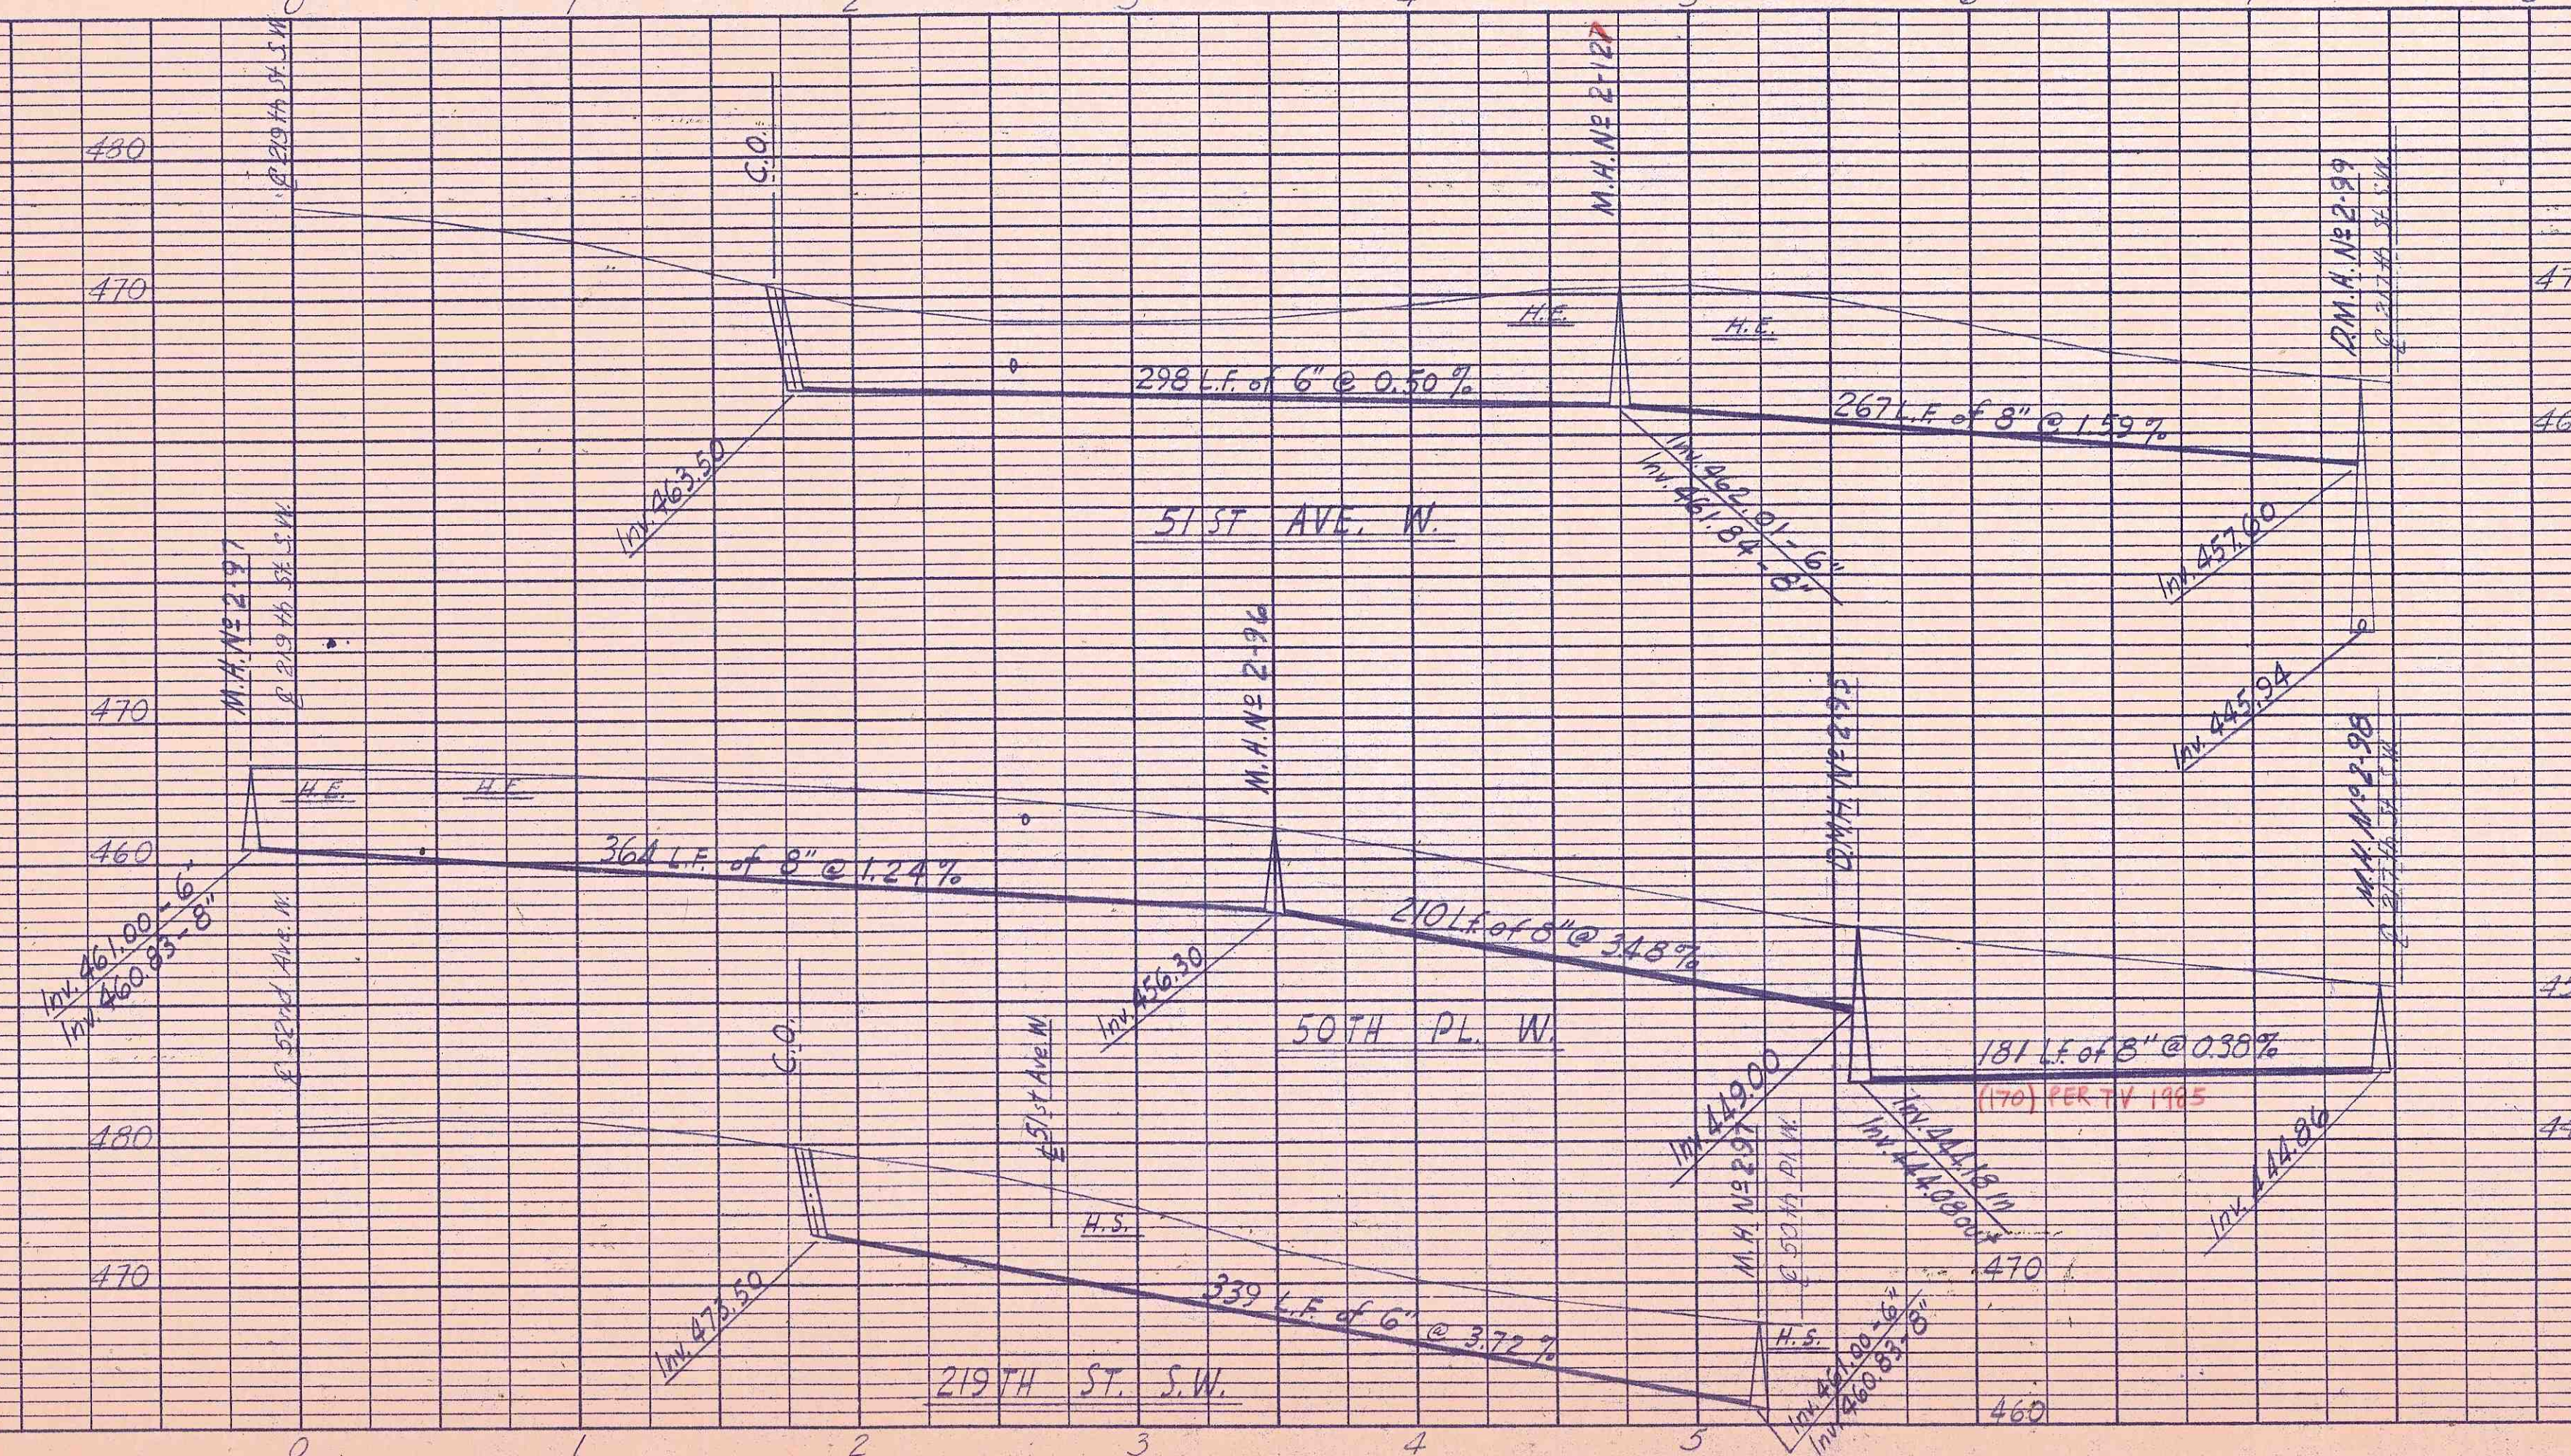

AS BUILT DRAWING