


Scan Name: scans06134.pdf
Scan Date:



SEWERAGE UNIT 1-16C

COMMUNITY
DEVELOPMENT
DEPARTMENT
23204 68th West
Mountlake Terrace WA 98043
(206) 778-1181

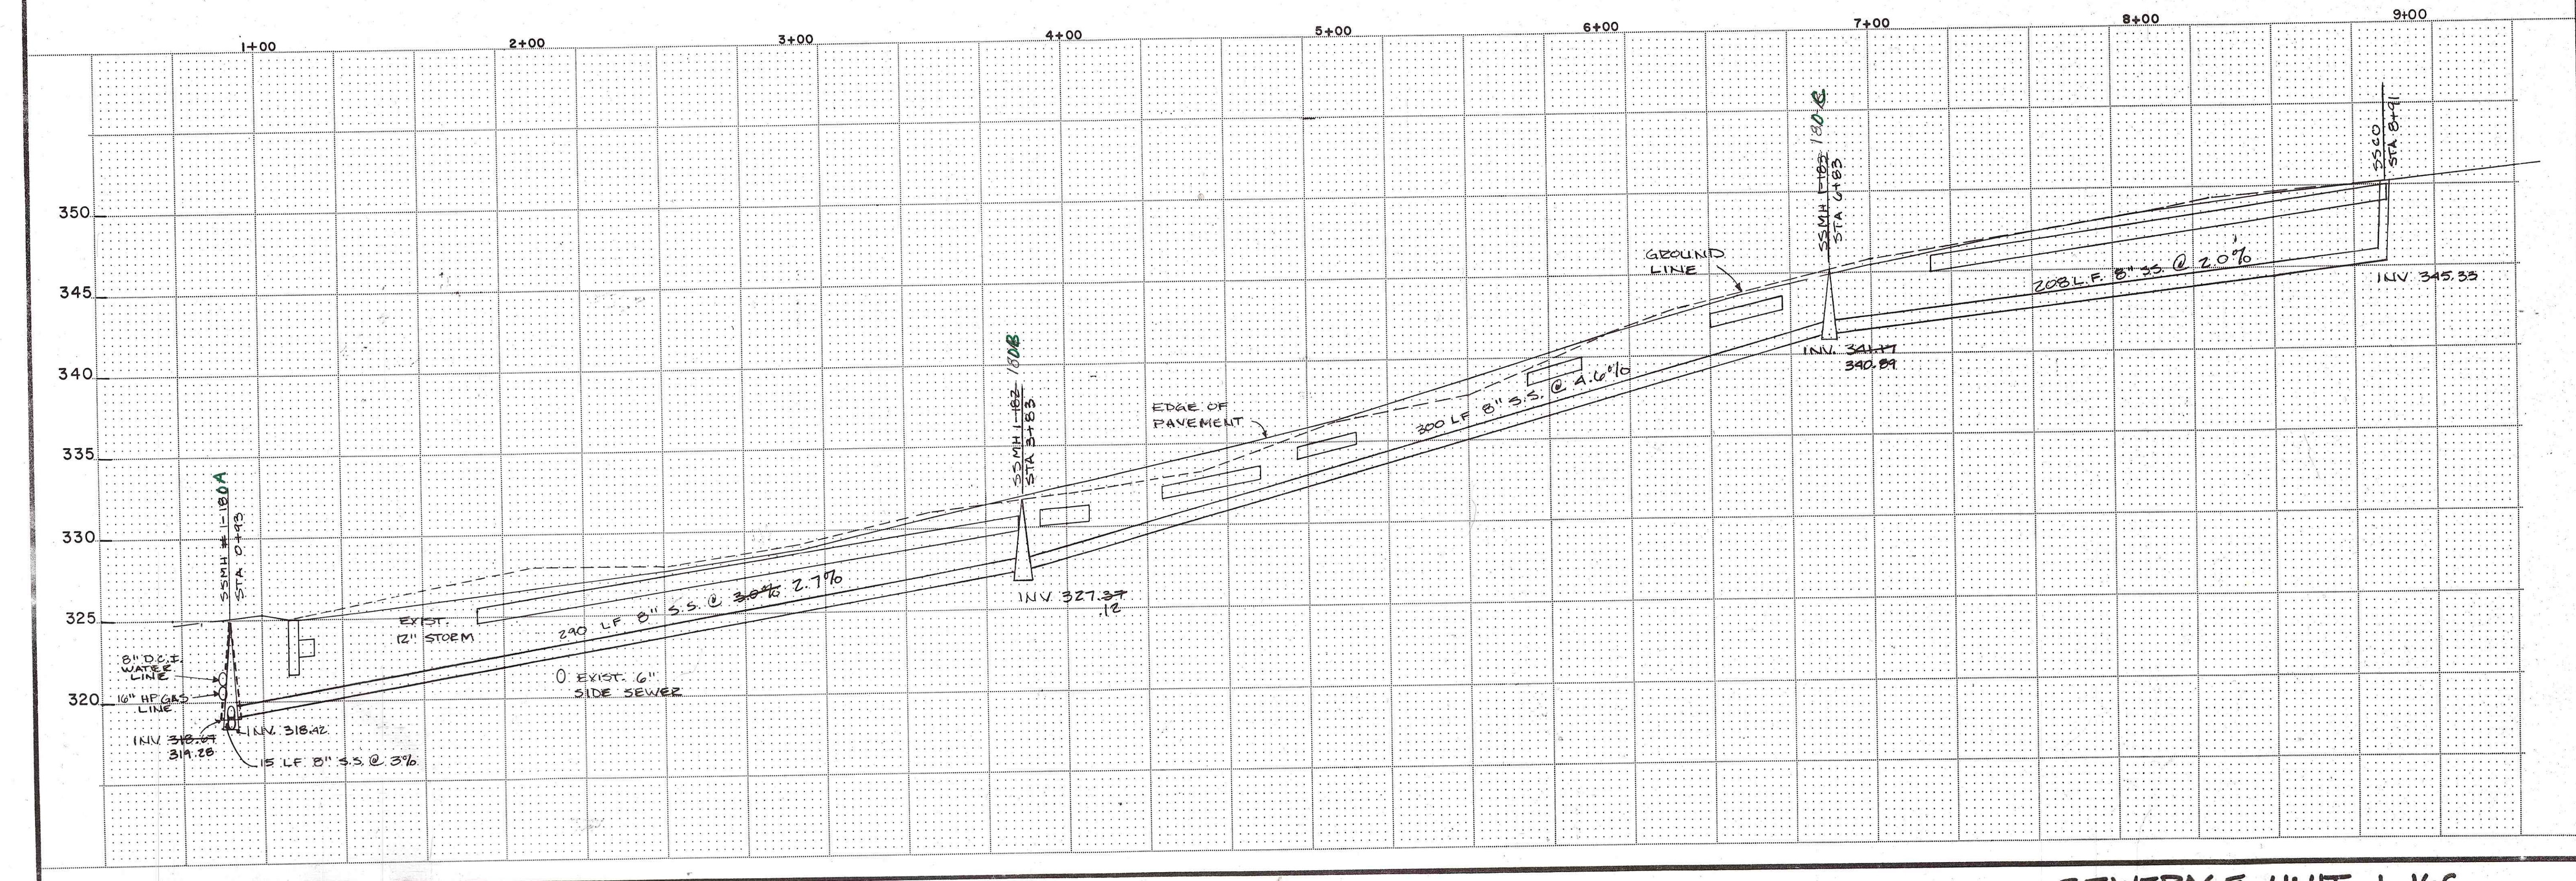

DATE	APPROVED
2/18/93	
DATE	DESCRIPTION
12/16/94	AS BUILT
DATE	REVISION

1 244TH ST. SEWER MAIN EXTENSION

SHEET
1
OF 1
HORIZ. SCALE
1" = 30'
VERT. SCALE
1" = 5'