
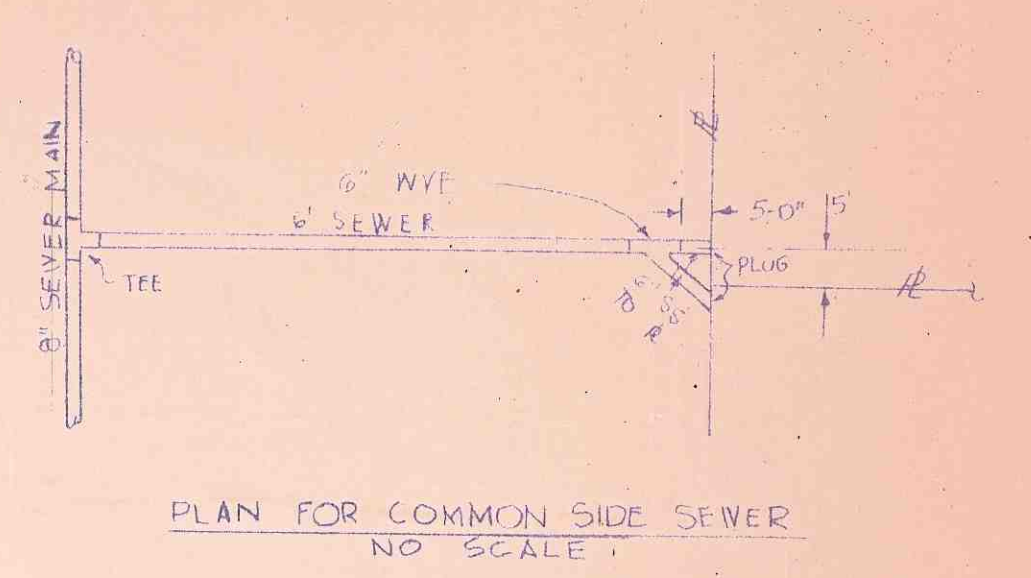



PLAN
 SURVEYED
 PLOTTED
 NOTE BOOK
 ALIGNMENT CHECKED
 NO. 1000000

PROFILE
 SURVEYED
 PLOTTED
 NOTE BOOK
 B.M. NOTED
 STRUCTURE NOTATIONS CHECKED
 NO. 1000000

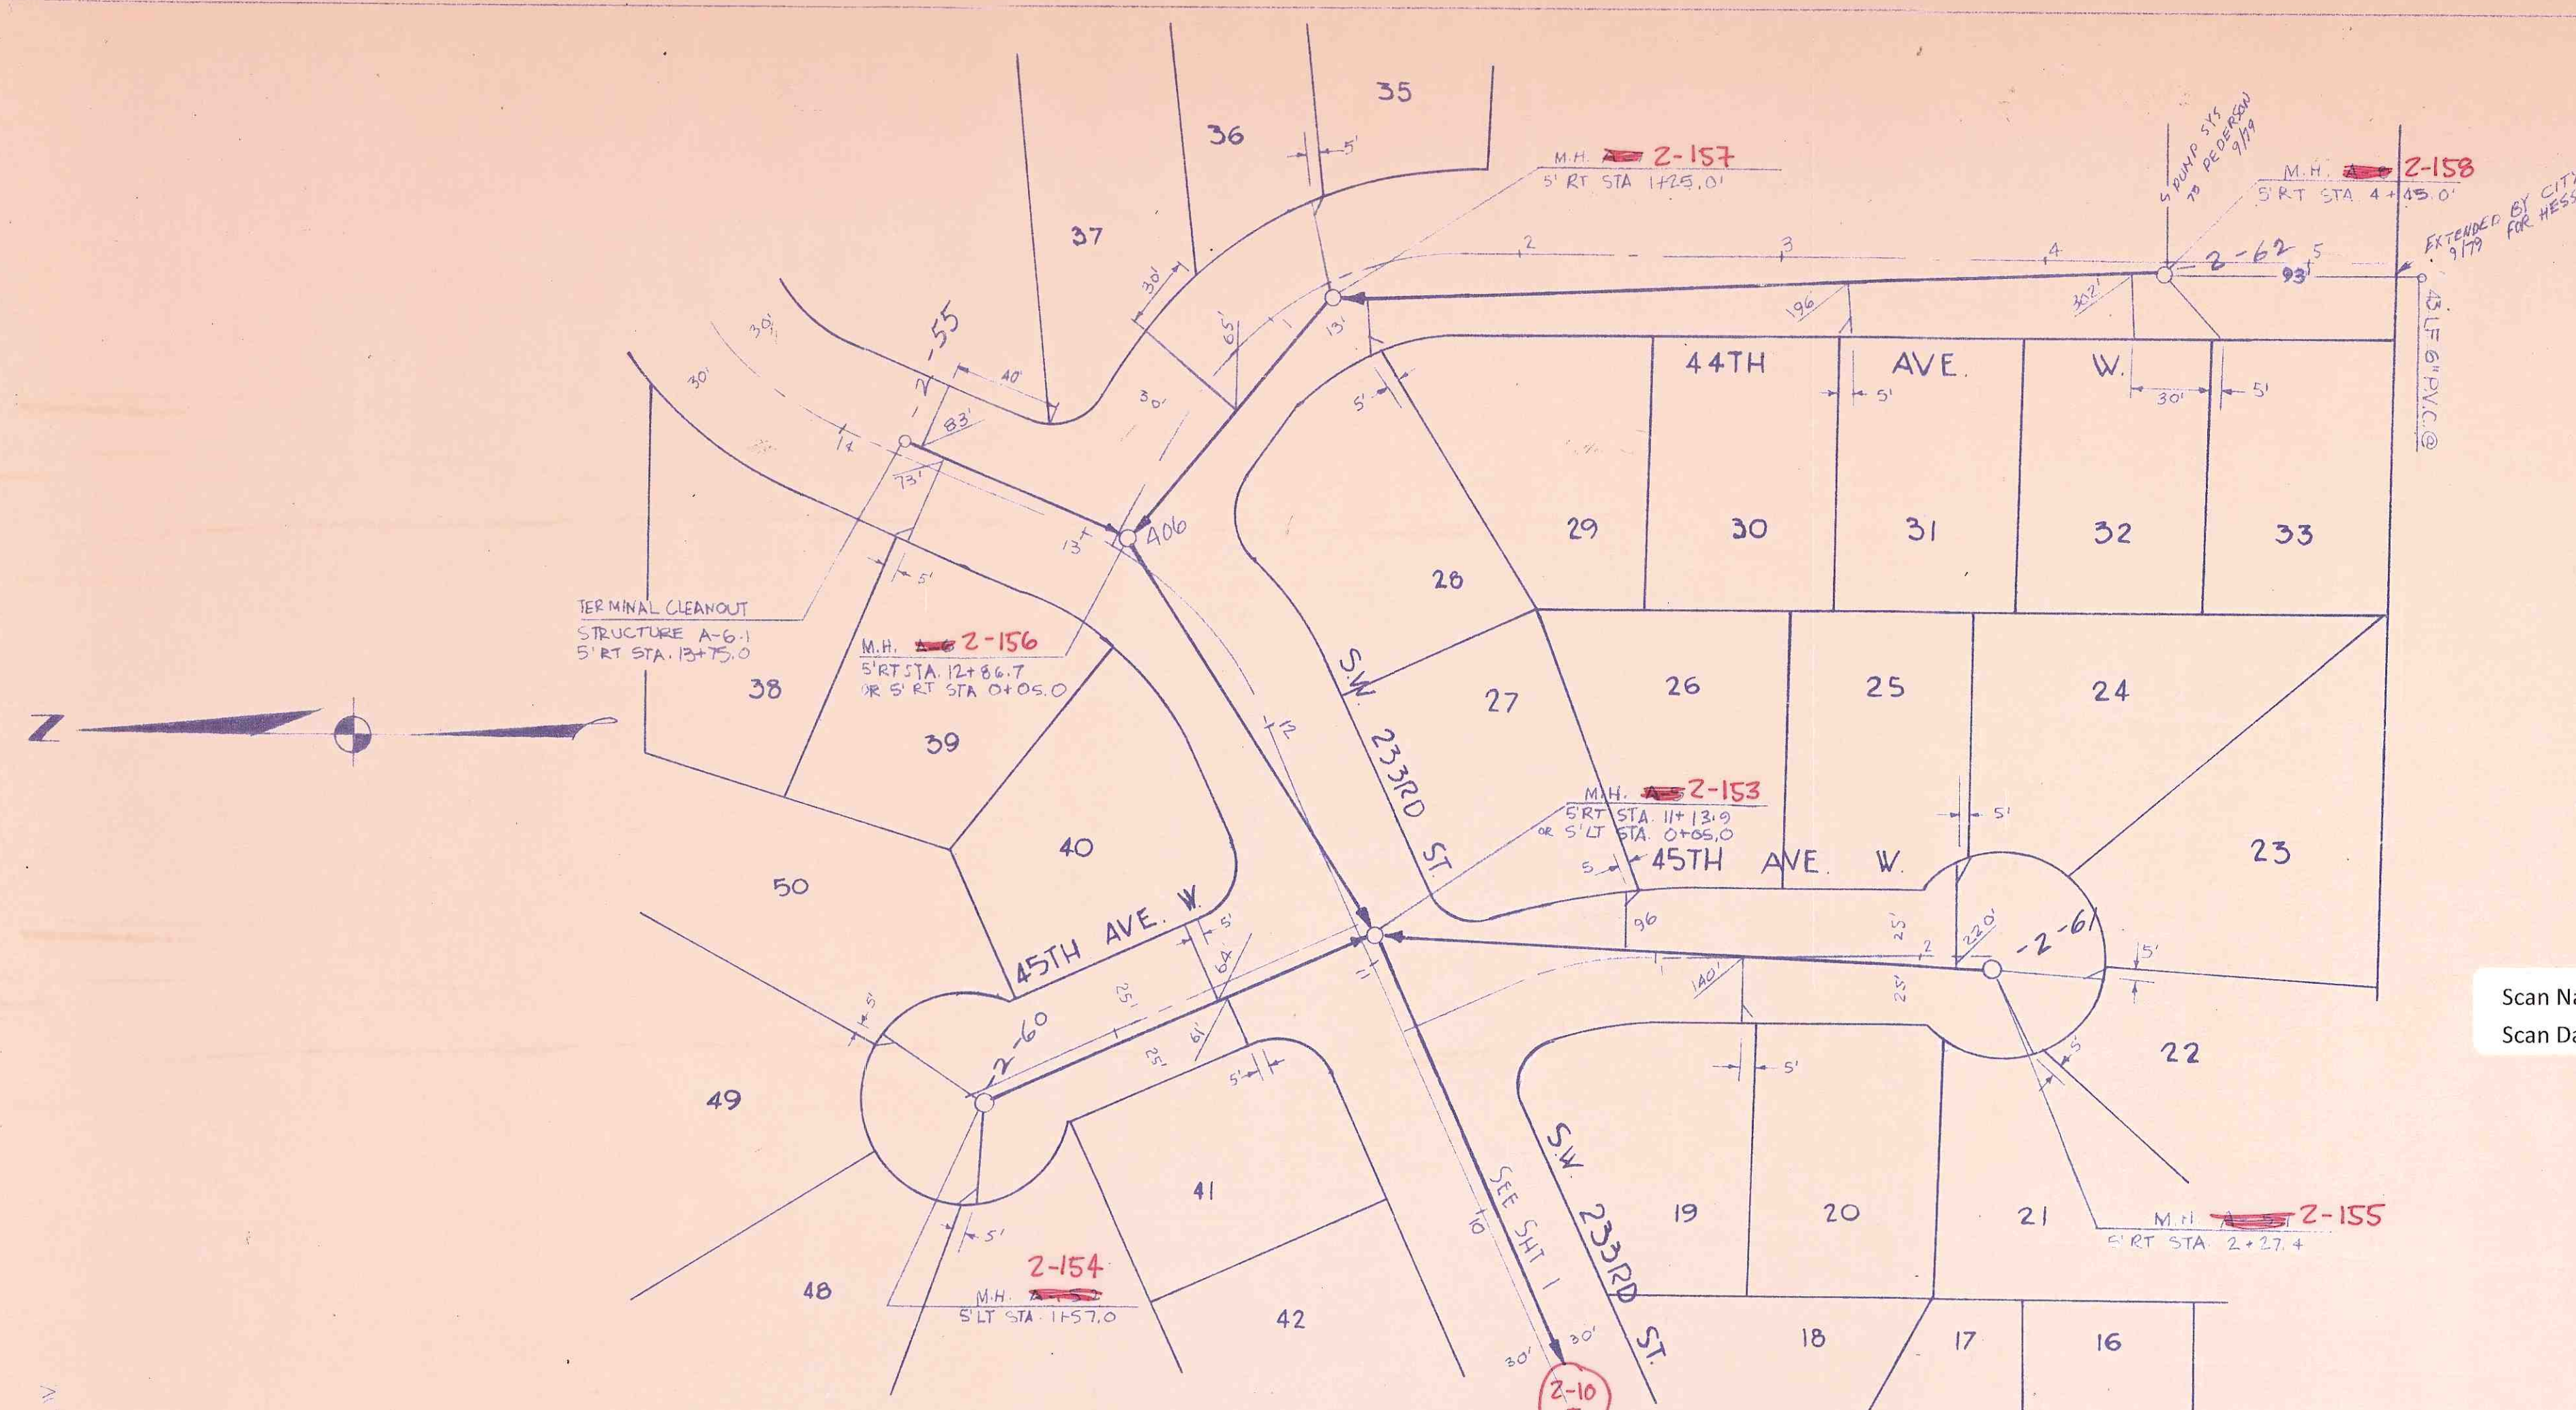

- NOTES:
1. DOUBLE SIDE SEWERS TO BE CONSTRUCTED AS PER DETAIL
 2. SINGLE SIDE SEWERS TO BE 6" DIAMETER TO PROPERTY LINE
 3. MINIMUM SLOPE ON SIDE SEWERS IS 2 PER CENT.
 4. ALL MATERIALS & CONSTRUCTION TO BE IN ACCORDANCE WITH CITY OF MOUNTLAKE TERRACE REQUIREMENTS.

Scan Name: scans06305.pdf
 Scan Date:

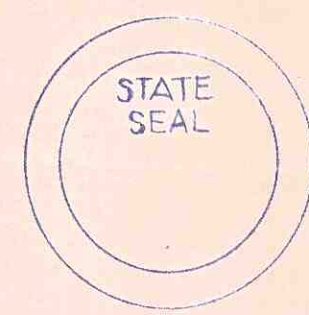

Original copied by Denise Stevens

| | | | |
|-----|-------------------------------|---------|------|
| NO. | REVISION | DATE | D.G. |
| 1 | 93' EXTENSION ON 44TH AVE. W. | 7-19-83 | D.G. |

RUSKIN FISHER & ASSOCIATES
 CIVIL ENGINEERS LAND SURVEYORS
 SEATTLE, WASH.

CEDAR TERRACE
 MONTLAKE TERRACE WASH.

SANITARY SEWERS

DRAWN BY: (LE) PARK RYKER
 CHECKED BY: PARK RYKER
 APPROVED BY: 62603
 JOB NO. 62603

SCALE: V. 1" = 5' H. 1" = 50'
 DATE: 8-2-62
 SHEET: 3 OF 3

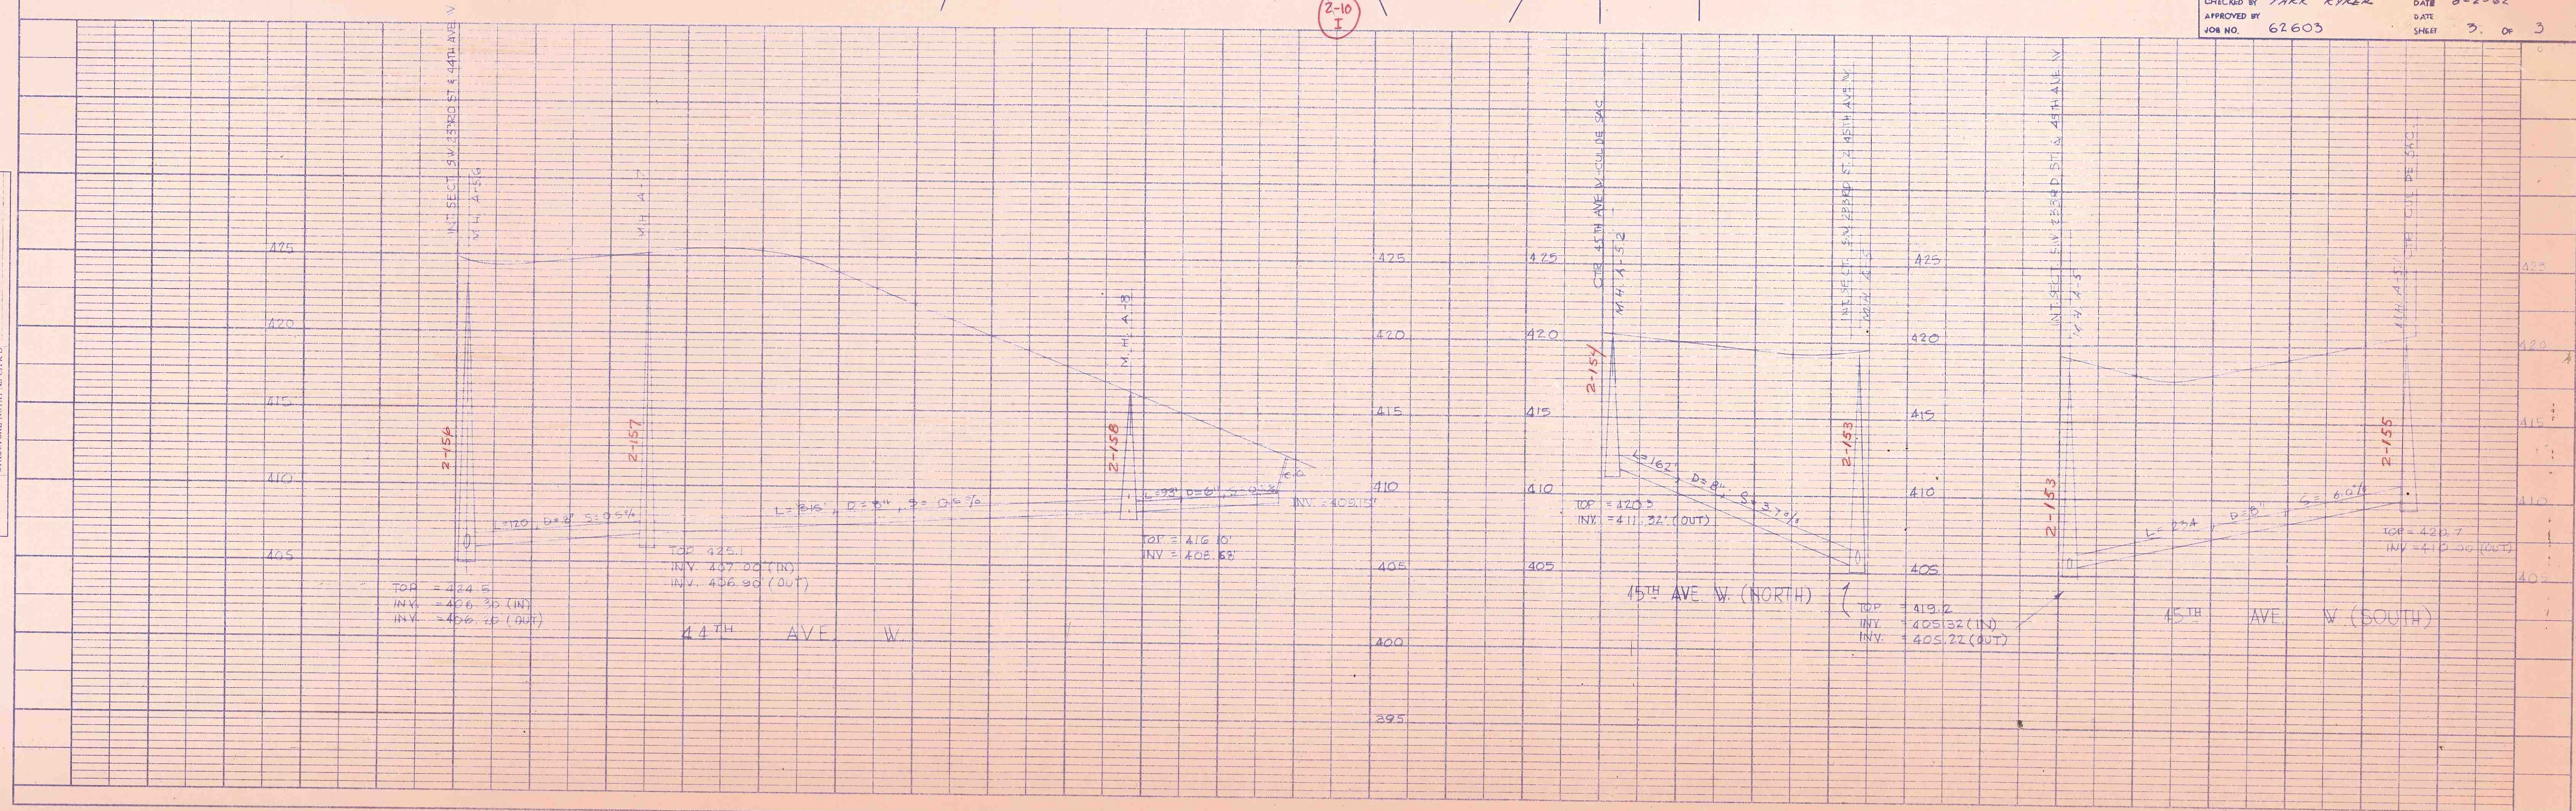


PLATE 3 - PLAN - PROFILE E.A.S.
 CLEARPRINT PAPER CO. S.F. CAL.
 NO. 1000000

Sewerage unit 2-10-K