

APPLICATION

SIDE SEWER PERMIT

OUTSIDE ☐ INSIDE ☒ REPAIRS ☐

CARD No.

EASEMENT No. 1375623

The City of Mountlake Terrace

OWNER RUSSELL L. TUTTLE

CONTRACTOR SELF


PERMIT No. 1559

HOUSE No. 57002- 56 & W.

STREET LOT 2 + NORTH 19' LOT 3

BLOCK No. DIV 30

NAME ADD.

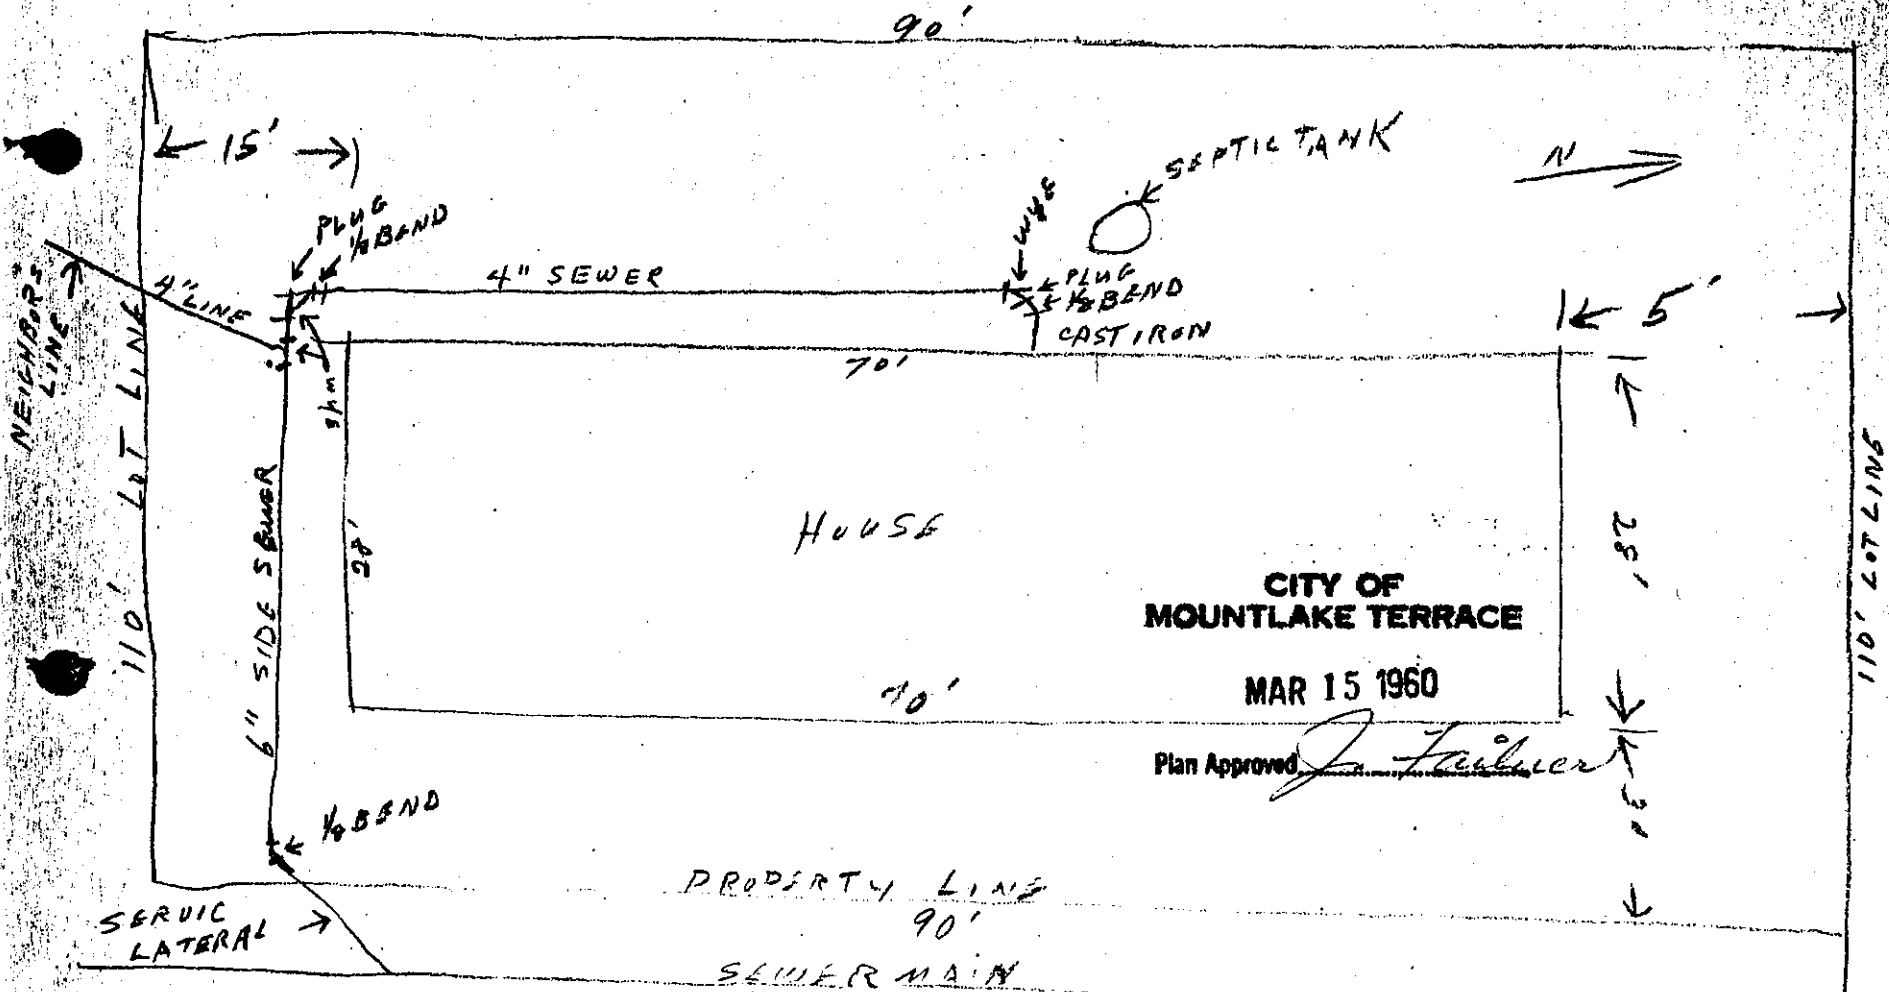

CITY OF MOUNTLAKE TERRACE

MAR 15 1960

Plan Approved J. Fairer

PROPERTY LINE

SEWER MAIN

Date

Approved:

BACKFILL WORK ORDER ISSUED

DEPOSIT, \$ 10.00

123-60

SEWER WORK ORDER ISSUED

5837

DATE

3-21-60

BY

Scott M. Holton/NS&CON