
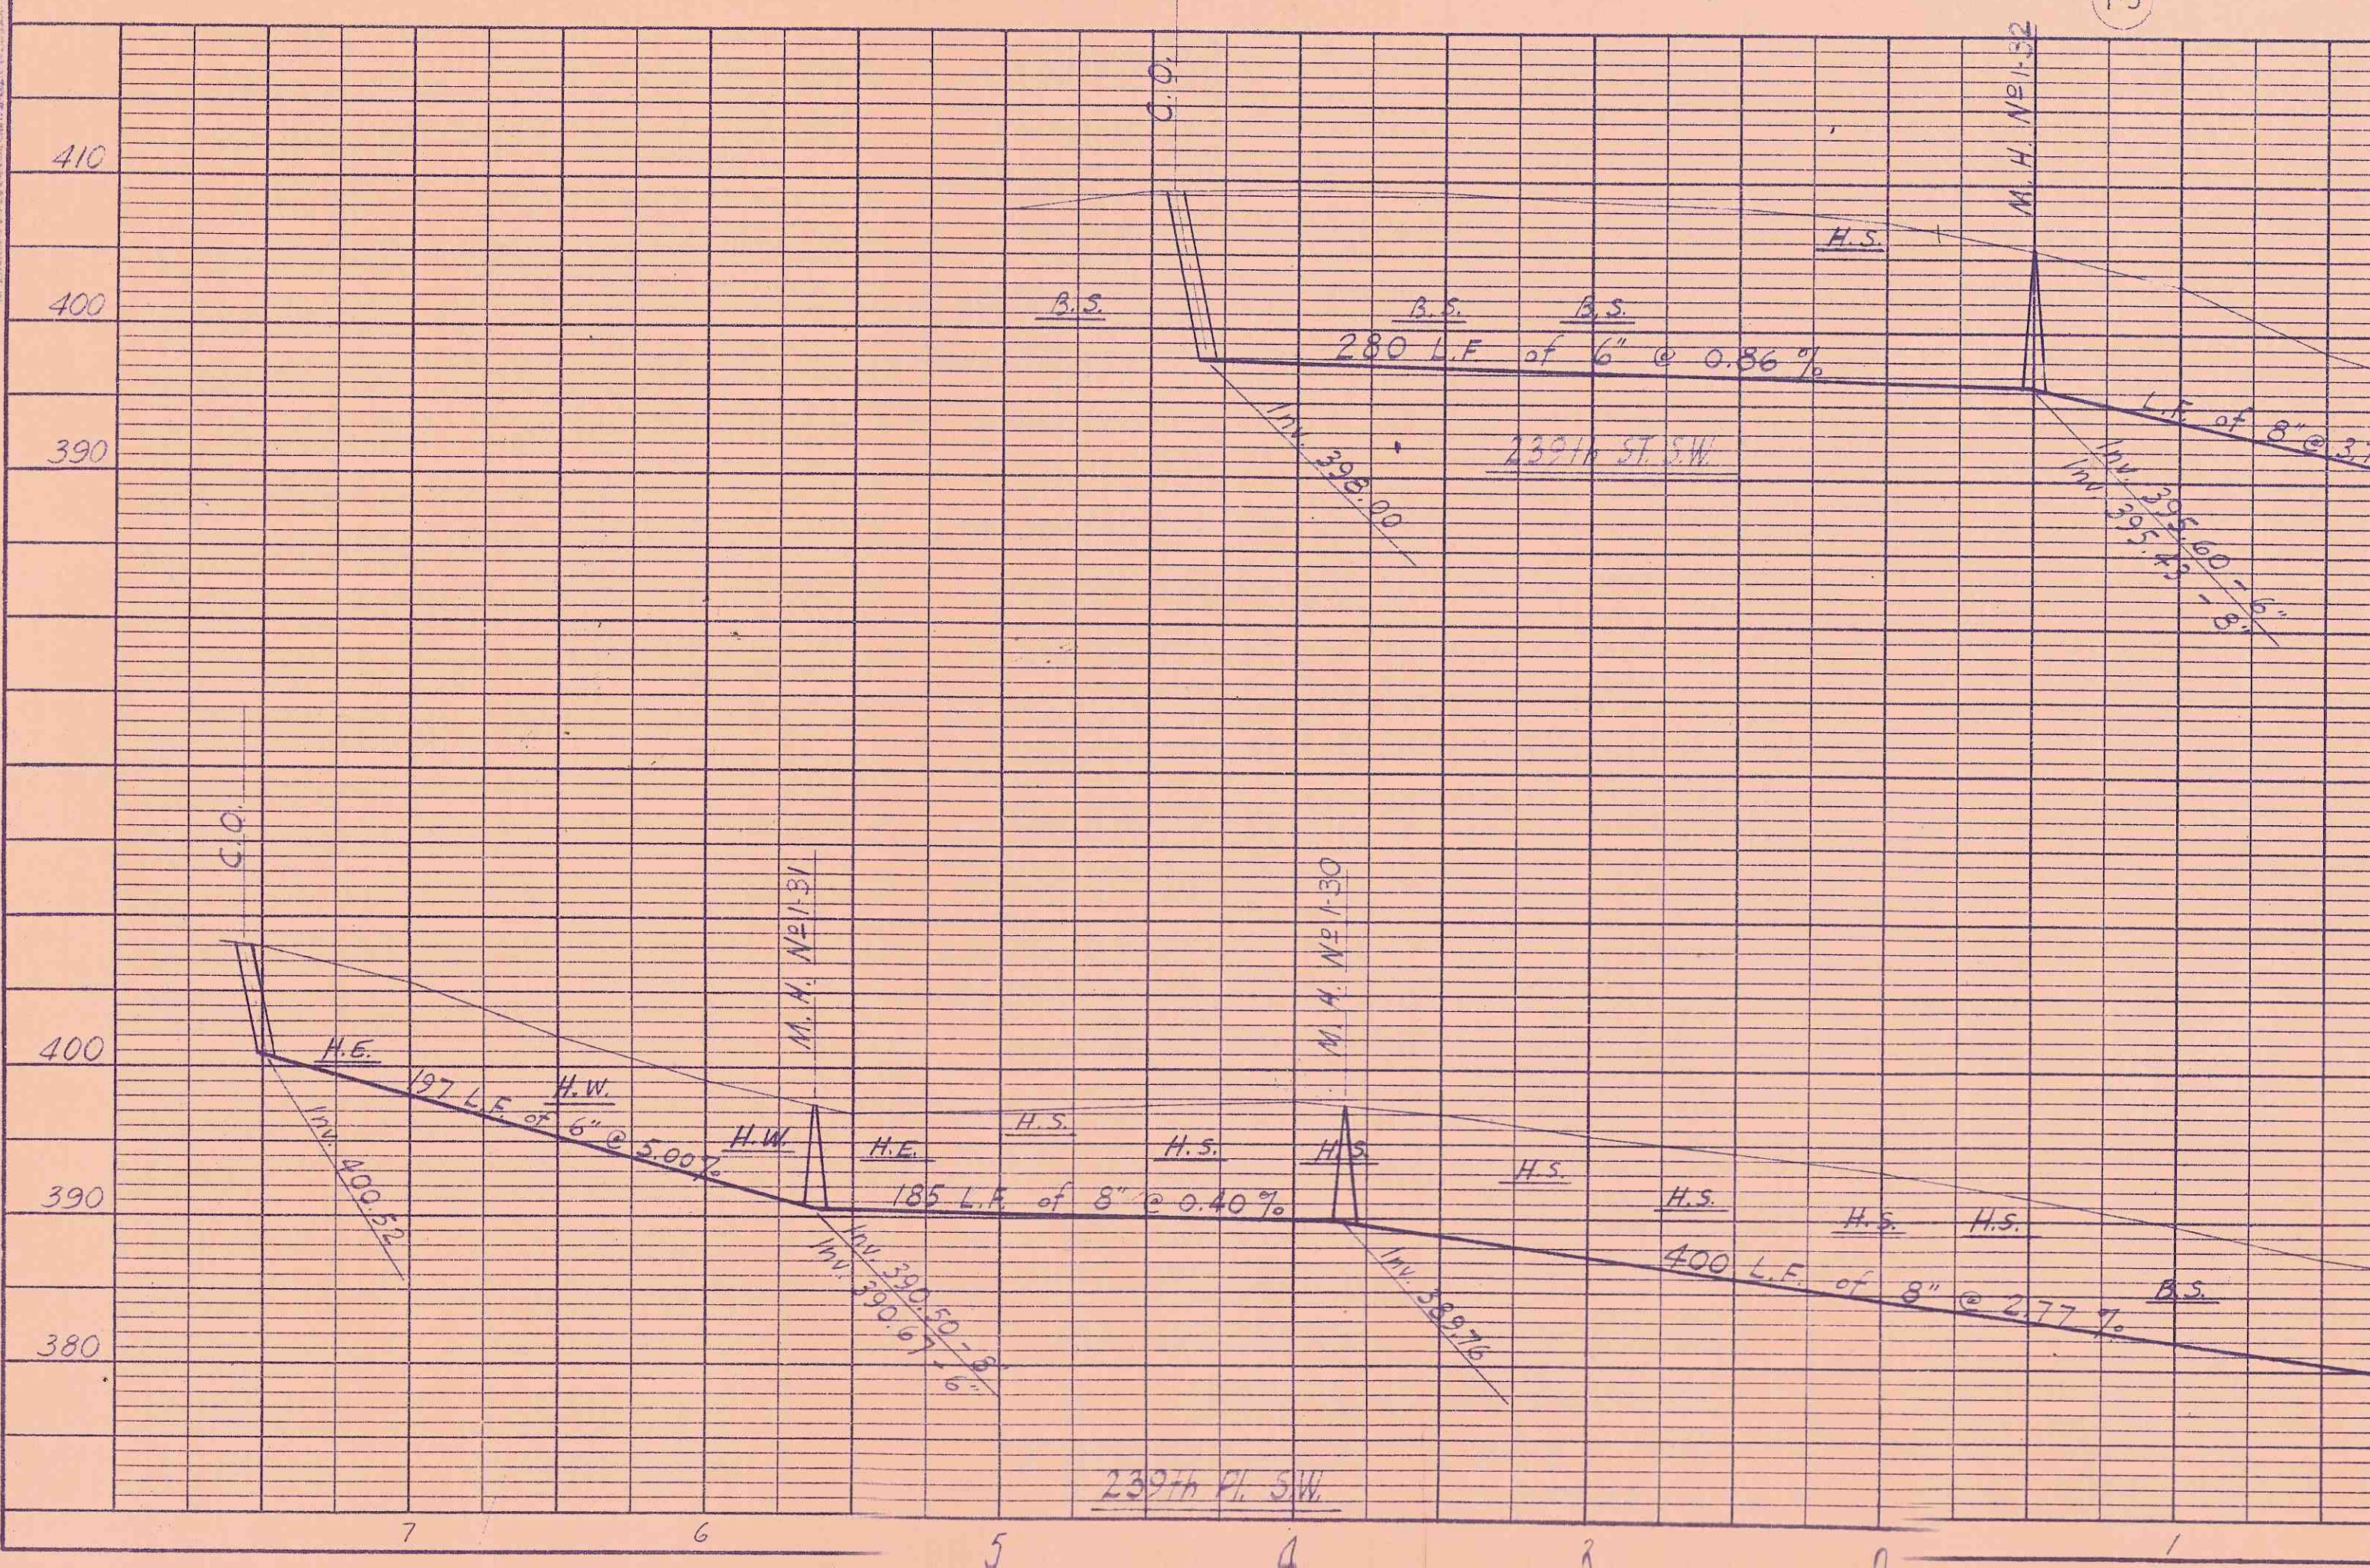




PLAN	
DATE	BY
2-28-59	E.H.
SURVEYED	
NOTE BOOK	PLOTTED
NO. 52-36	ALIGNMENT CHECKED
	BY
	DATE

PROFILE	
DATE	BY
2-28-59	E.H.
SURVEYED	
NOTE BOOK	PLOTTED
NO. 52-36	ALIGNMENT CHECKED
	BY
	DATE

PROFILE	
DATE	BY
2-28-59	E.H.
SURVEYED	
NOTE BOOK	PLOTTED
NO. 52-36	ALIGNMENT CHECKED
	BY
	DATE

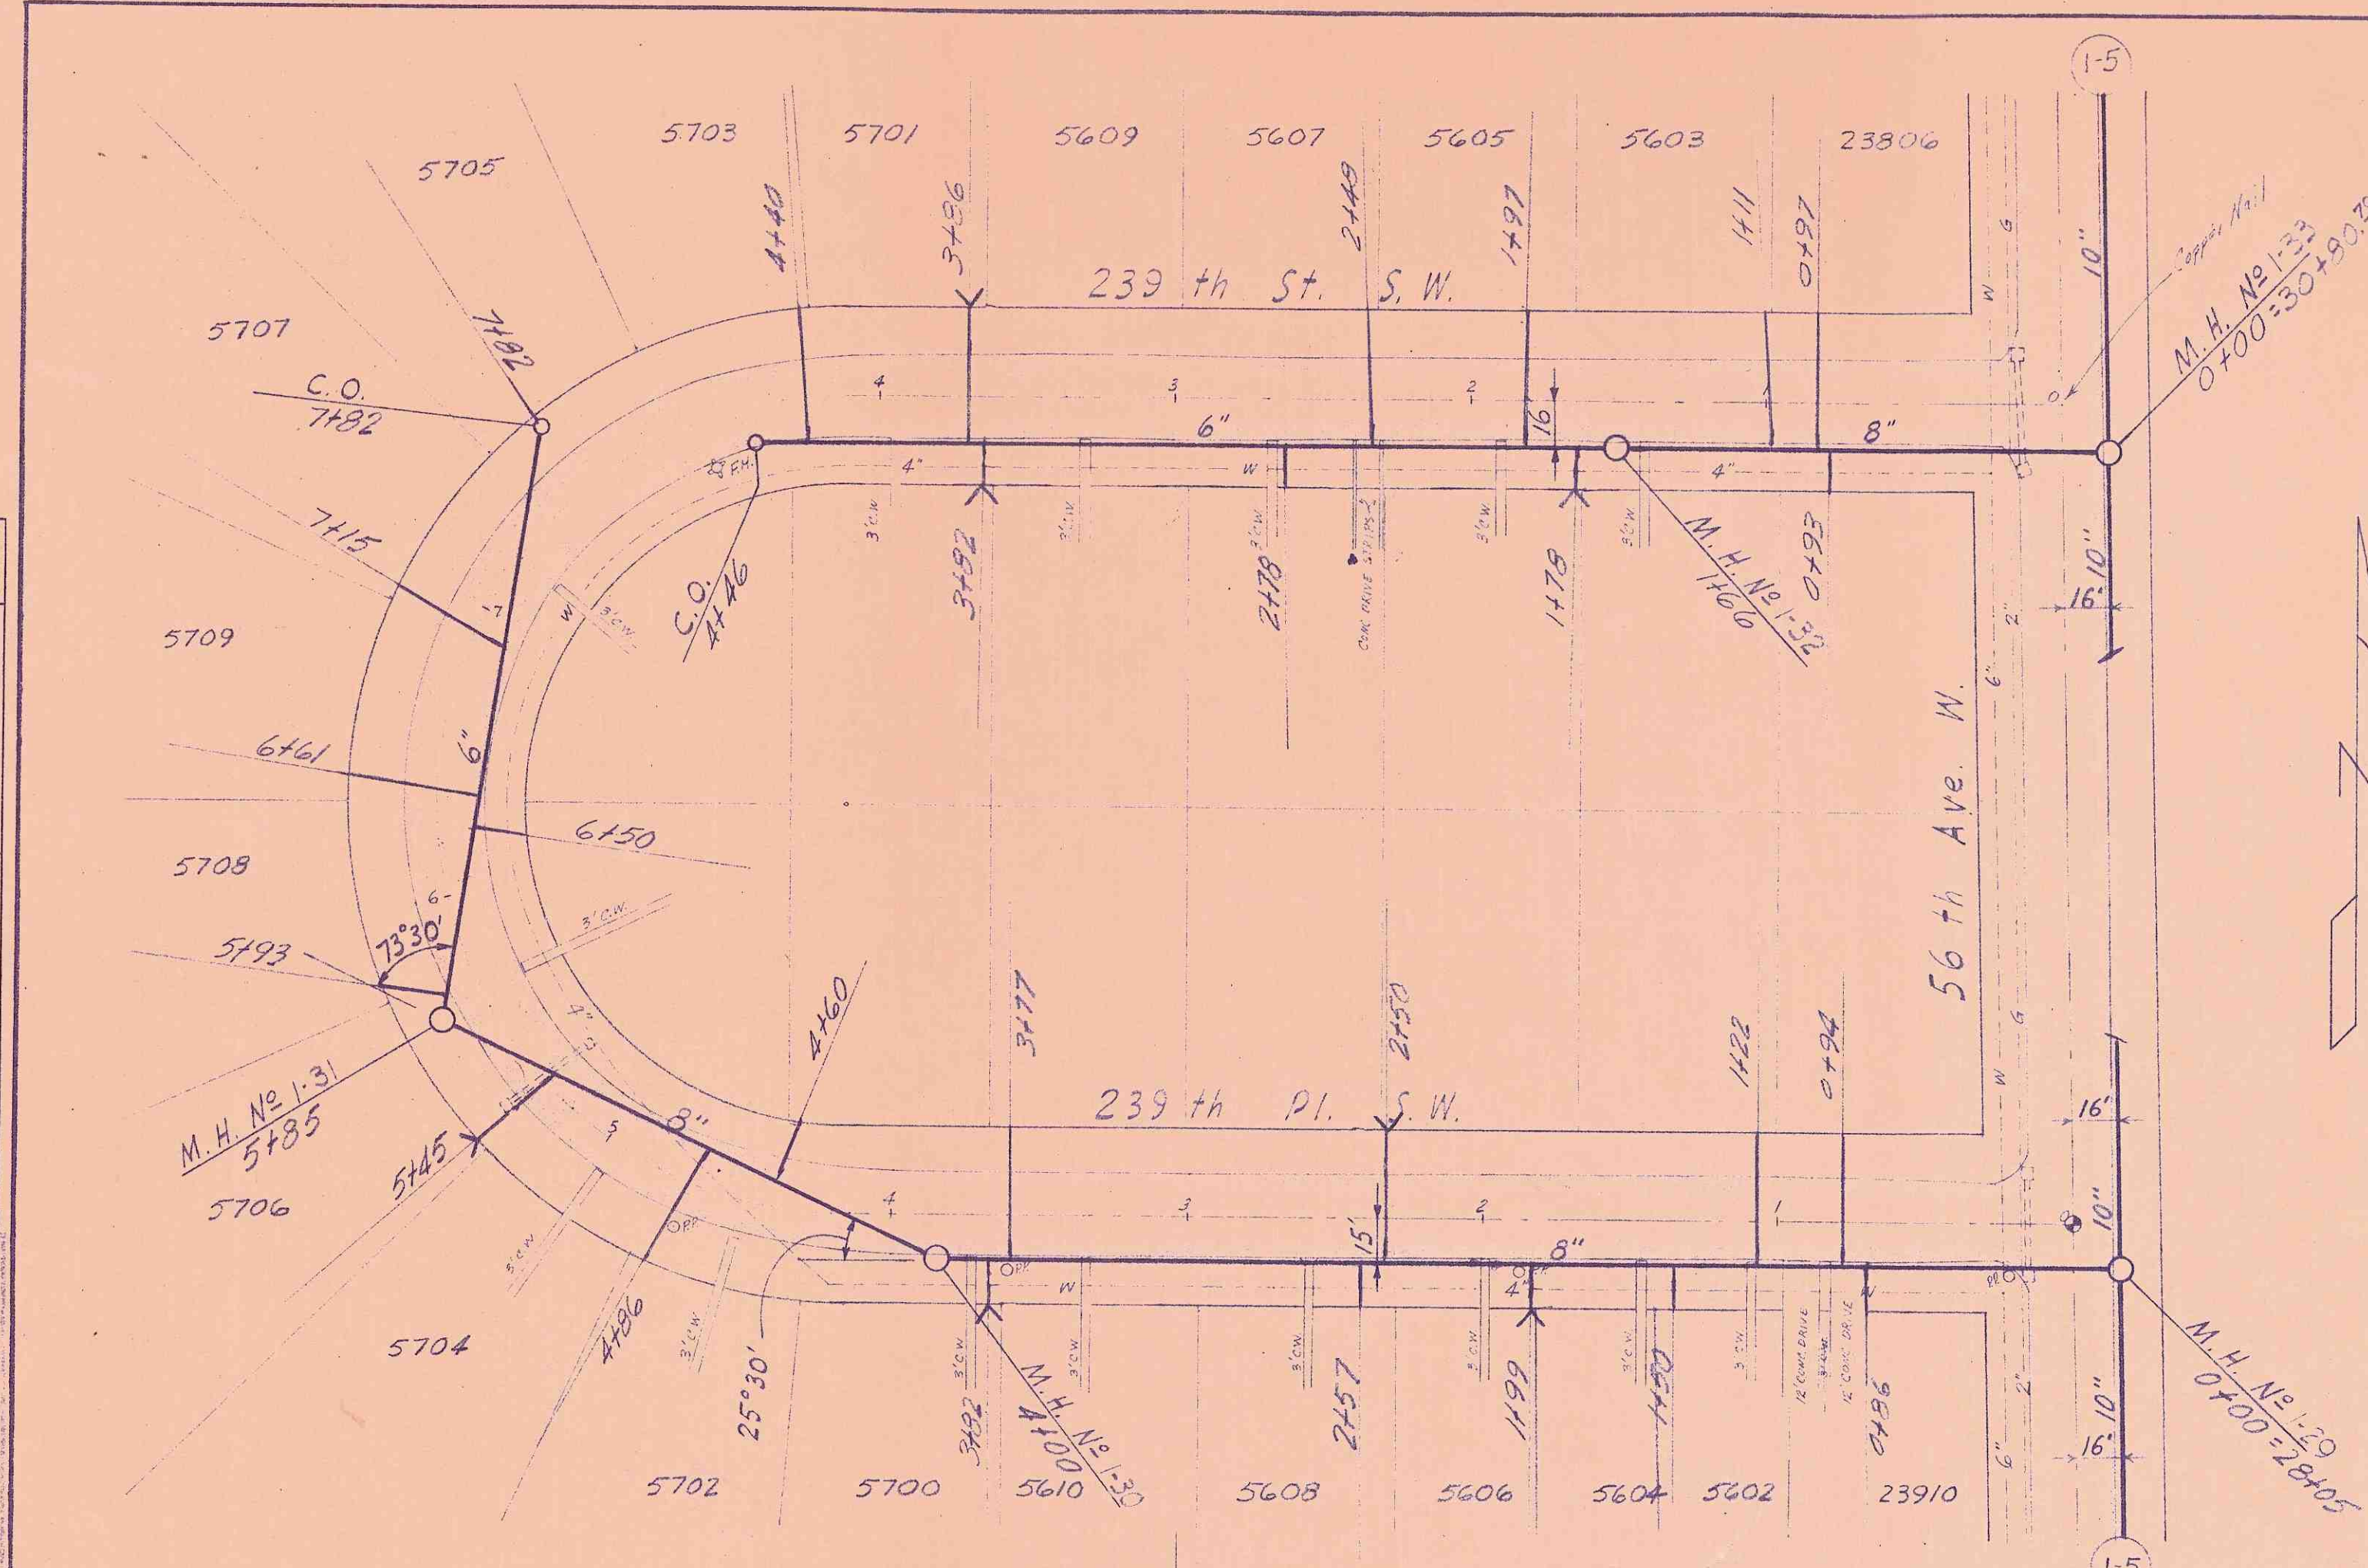

Scan Name: scans06120.pdf
Scan Date:

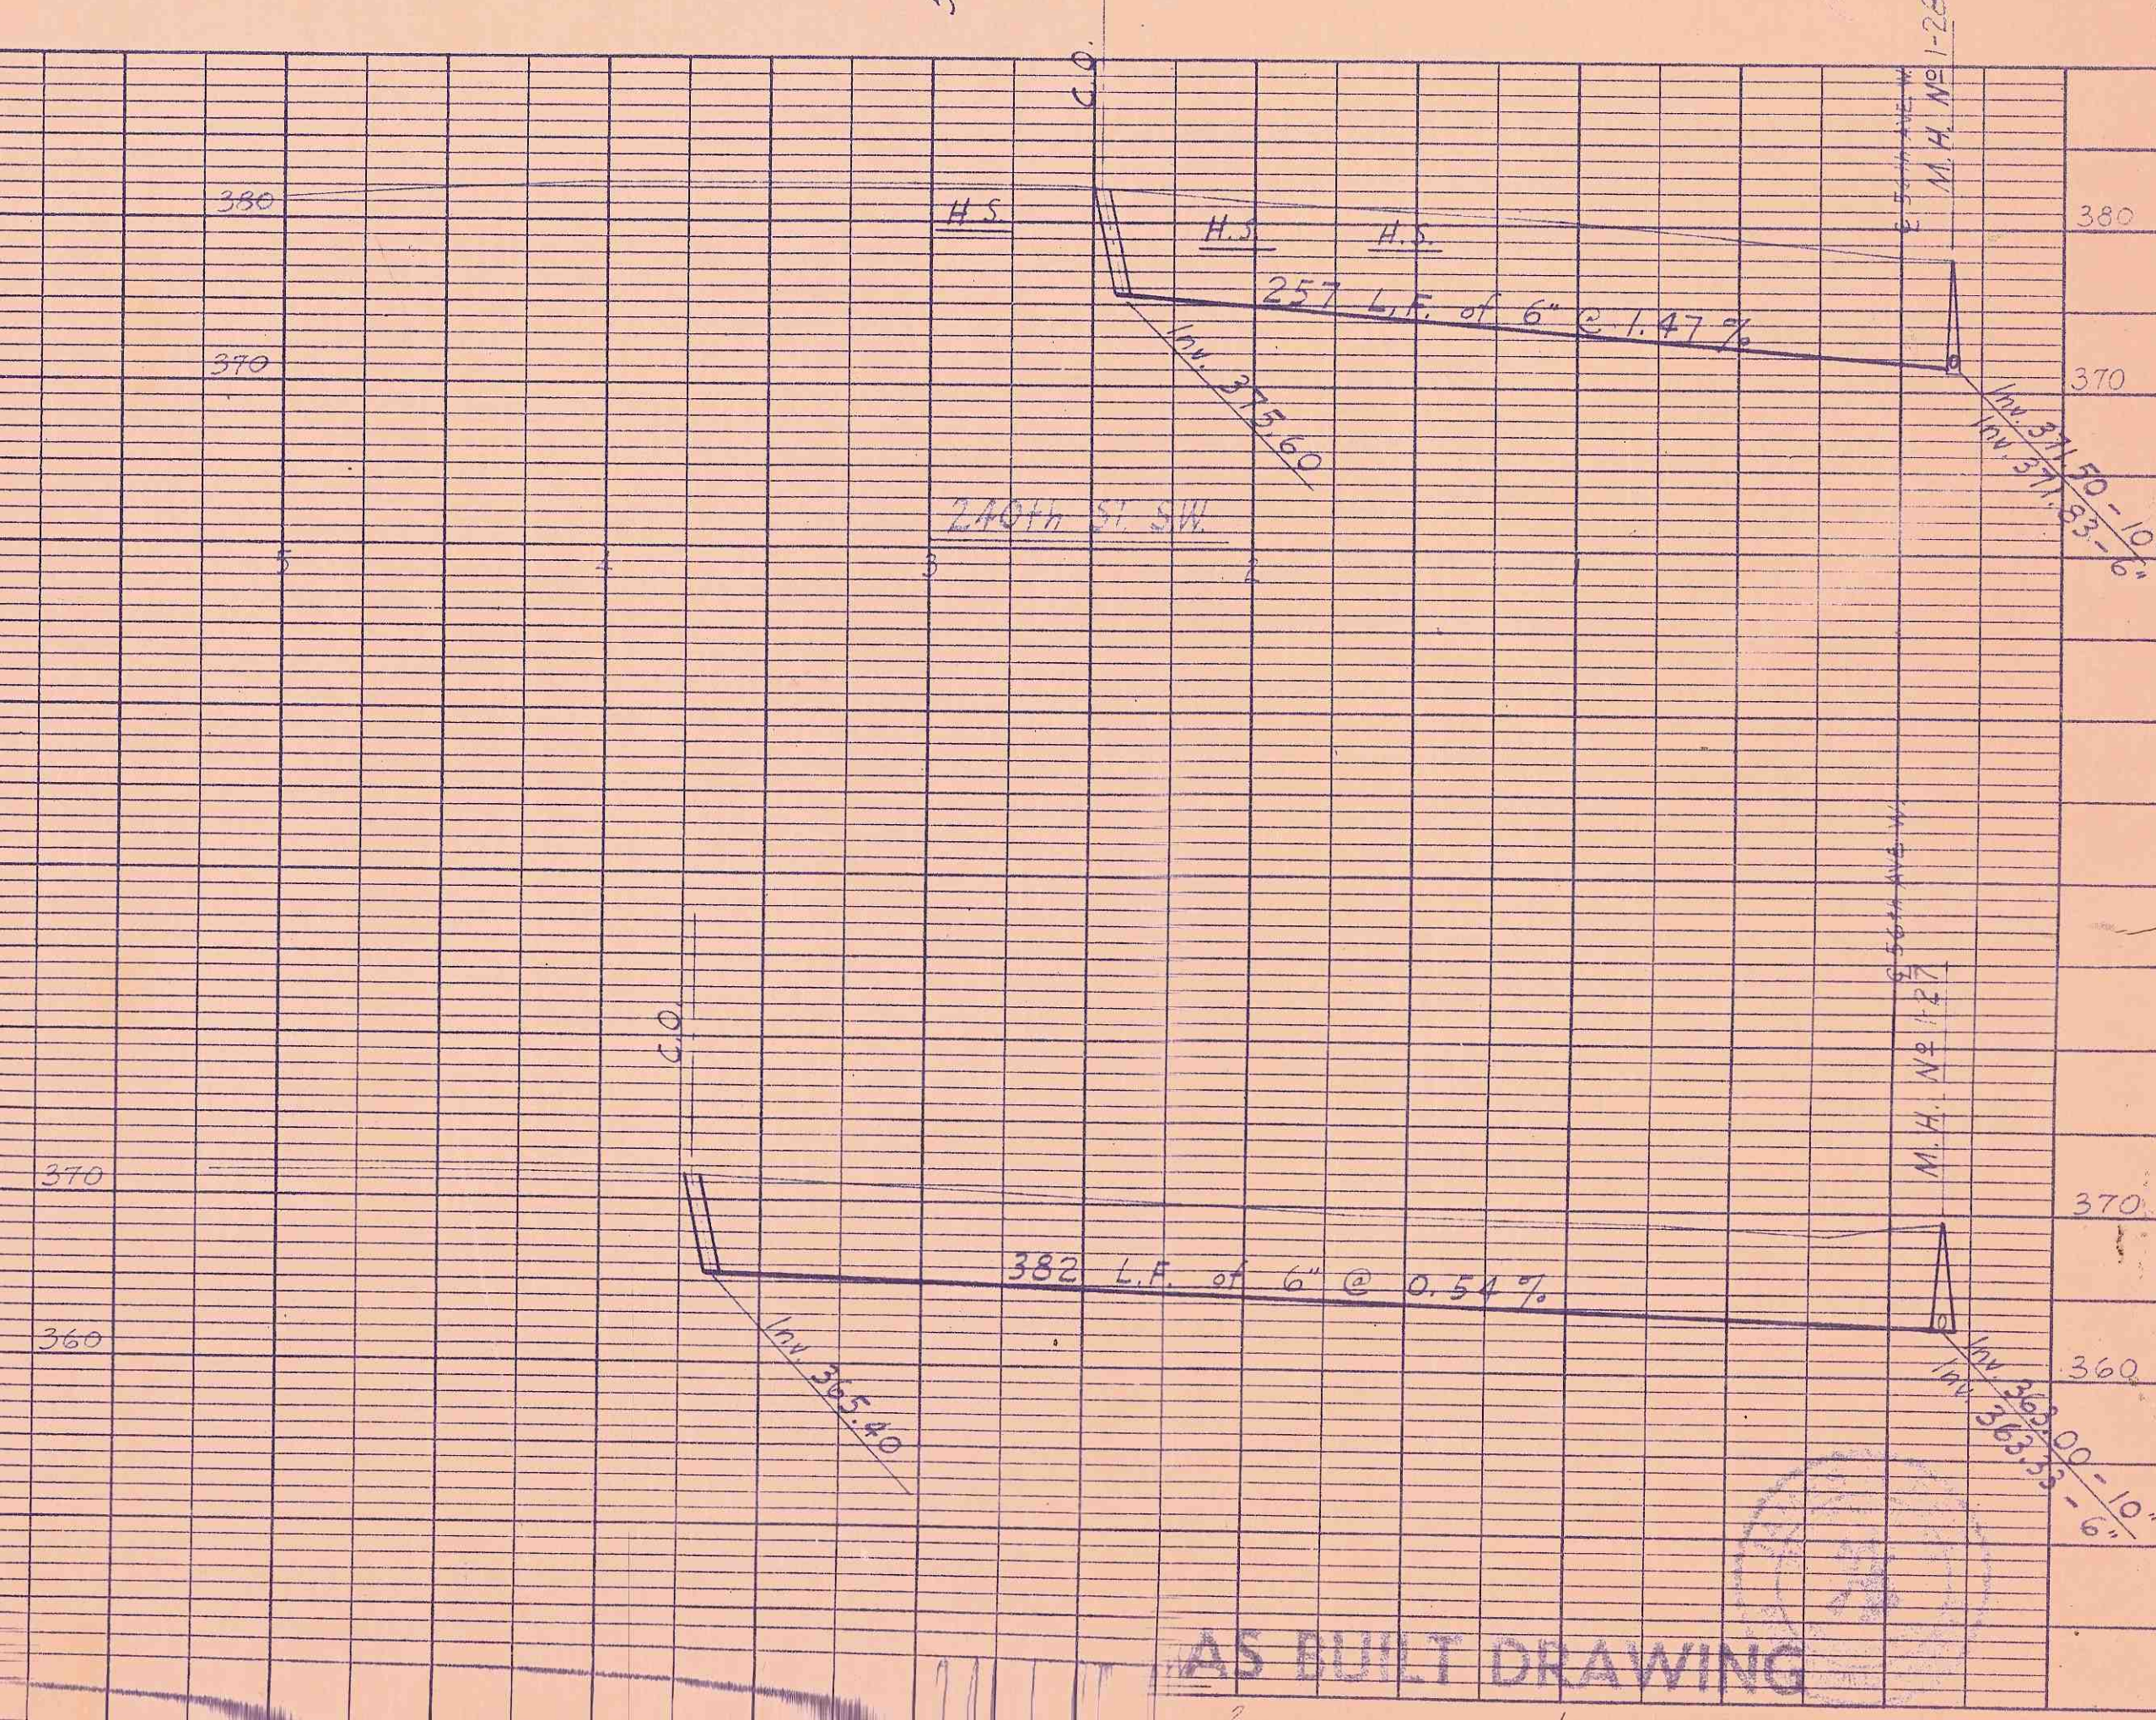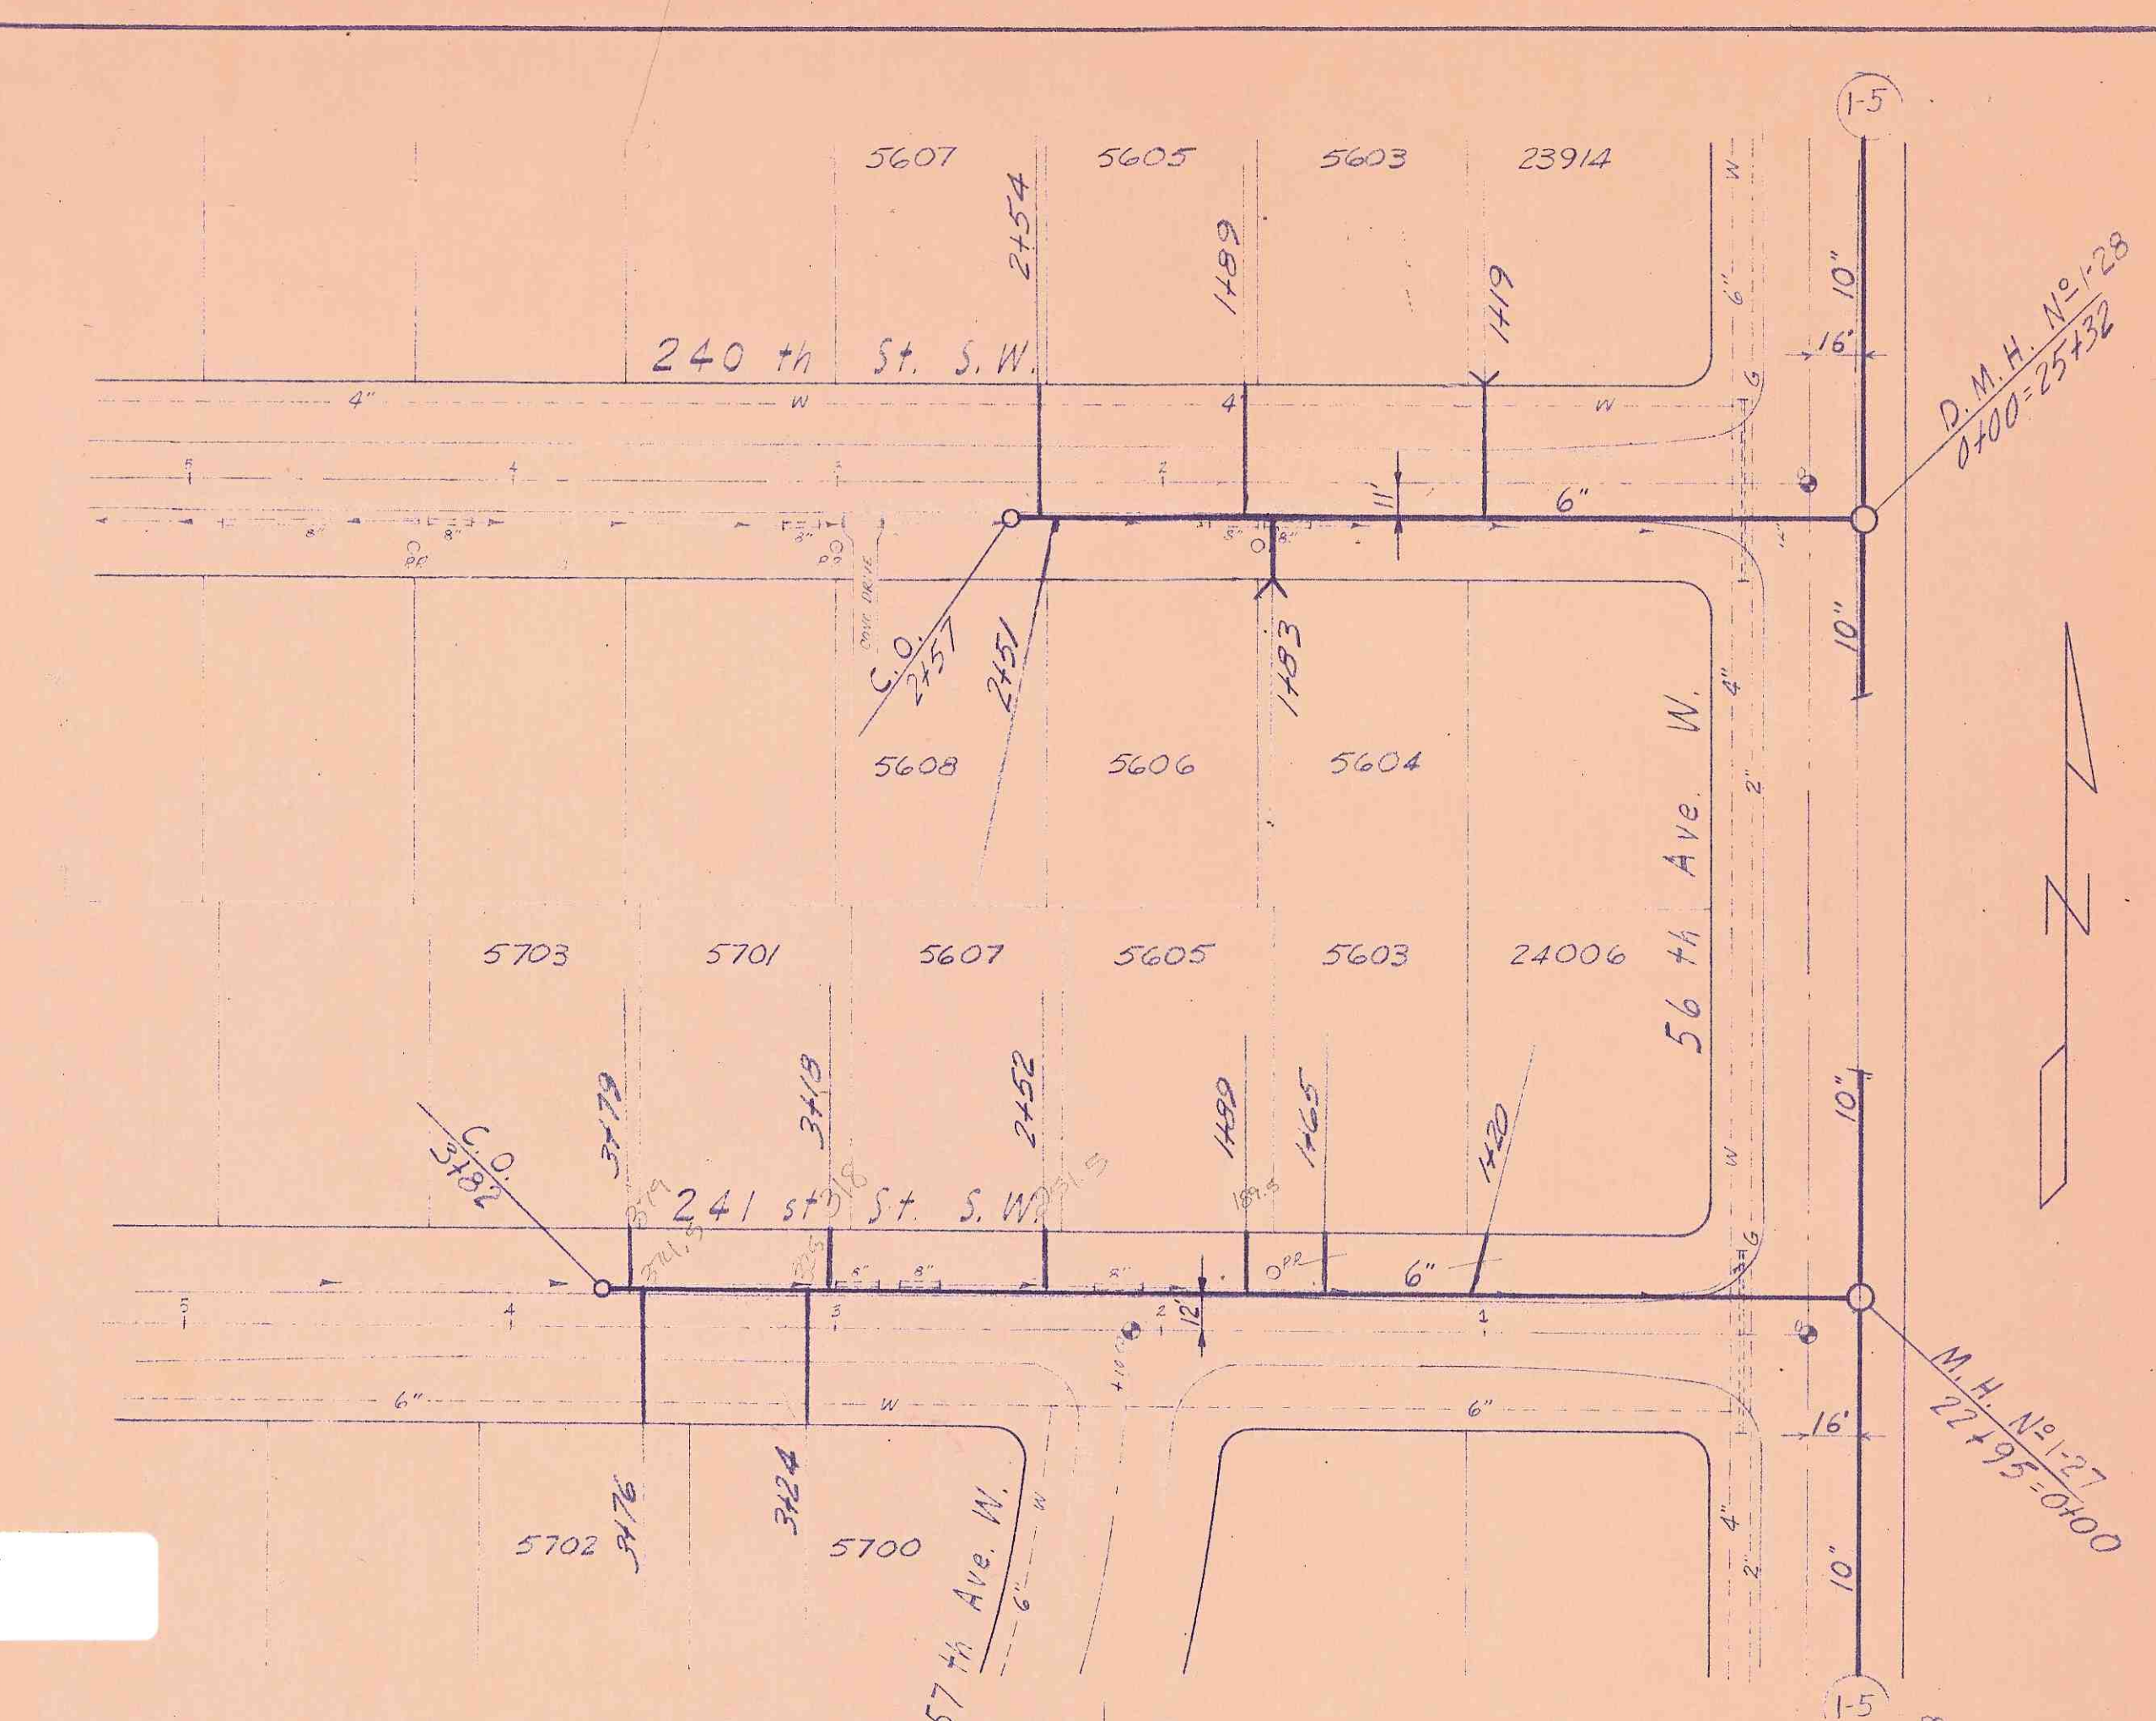

AS BUILT DRAWING

PLATE 1: PLAN - PROFILE - F.A.S.
CLEARPRINT PAPER CO. S.F. CAL.
No. 1000-1

JAMES H. REID & ASSOCIATES
CONSULTING ENGINEERS

DESIGN	DRAWN	CHECKED	DATE	H. SCALE	FILE NO.
M.	DP-HH.	L.N.	3-30-59	1"=50'	5-50/1-8
					SHEET 8
					OF 26