

APPLICATION

for

SIDE SEWER PERMIT

OUTSIDE ☐ INSIDE ☒ REPAIRS ☐

CARD No. _____

EASEMENT No. _____

The City of Mountlake Terrace


OWNER Elmer V. Mass.

CONTRACTOR Lynnwood Septic Tank Co. PERMIT No. 3071

HOUSE No. 4405

STREET _____
AVENUE LOT No. 242 7th SW BLOCK No. 14

NAME ADDR. _____

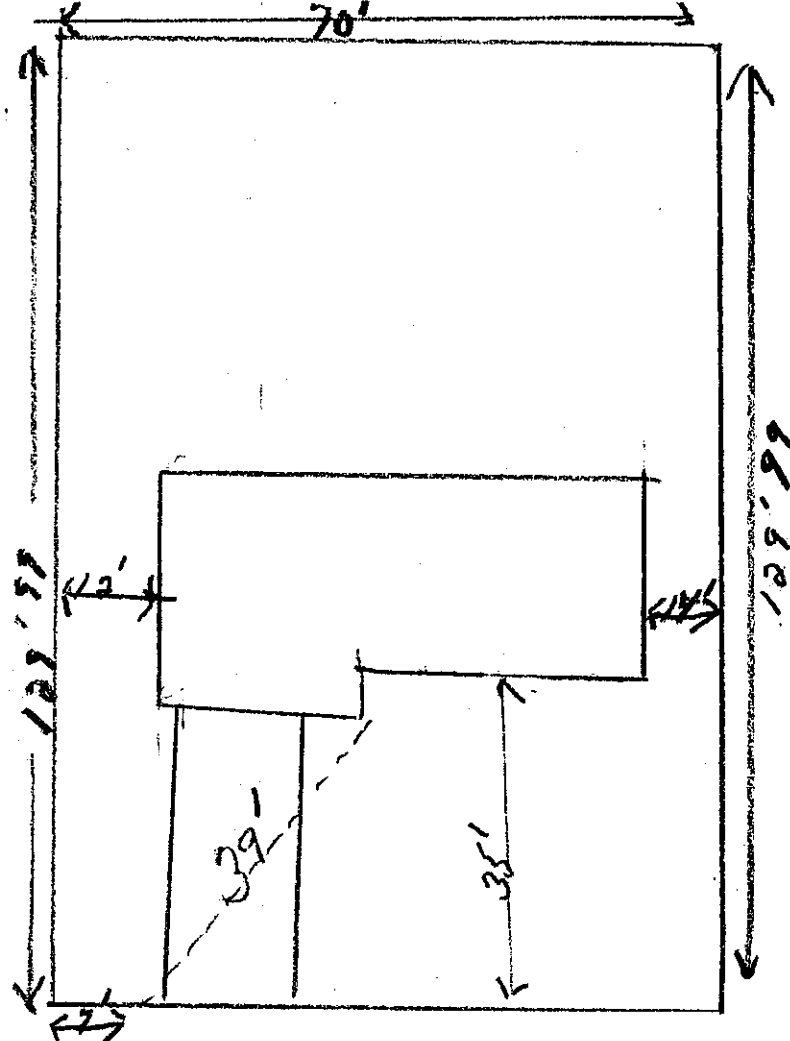

2180-
Bldg-Per.

Date _____

Approved: _____

BACKFILL WORK ORDER ISSUED _____ DEPOSIT, \$ _____

SEWER WORK ORDER ISSUED _____

DATE 4/27/62 BY G. J. D.