


NOTE: 1. AN AS-BUILT SURVEY OF THE STORMWATER DETENTION POND, CERTIFIED BY A LICENCED ENGINEER OR LAND SURVEYOR CONFIRMING THAT THE POND CONTAINS THE REQUIRED STORAGE, MUST BE PROVIDED TO THE CITY PRIOR TO GRANTING ANY CERTIFICATES OF OCCUPANCY.
 2. WYE'S OR SWEEPING TEES ARE REQ'D FOR LATERAL CONNECTIONS TO SANITARY SEWER MAINS.

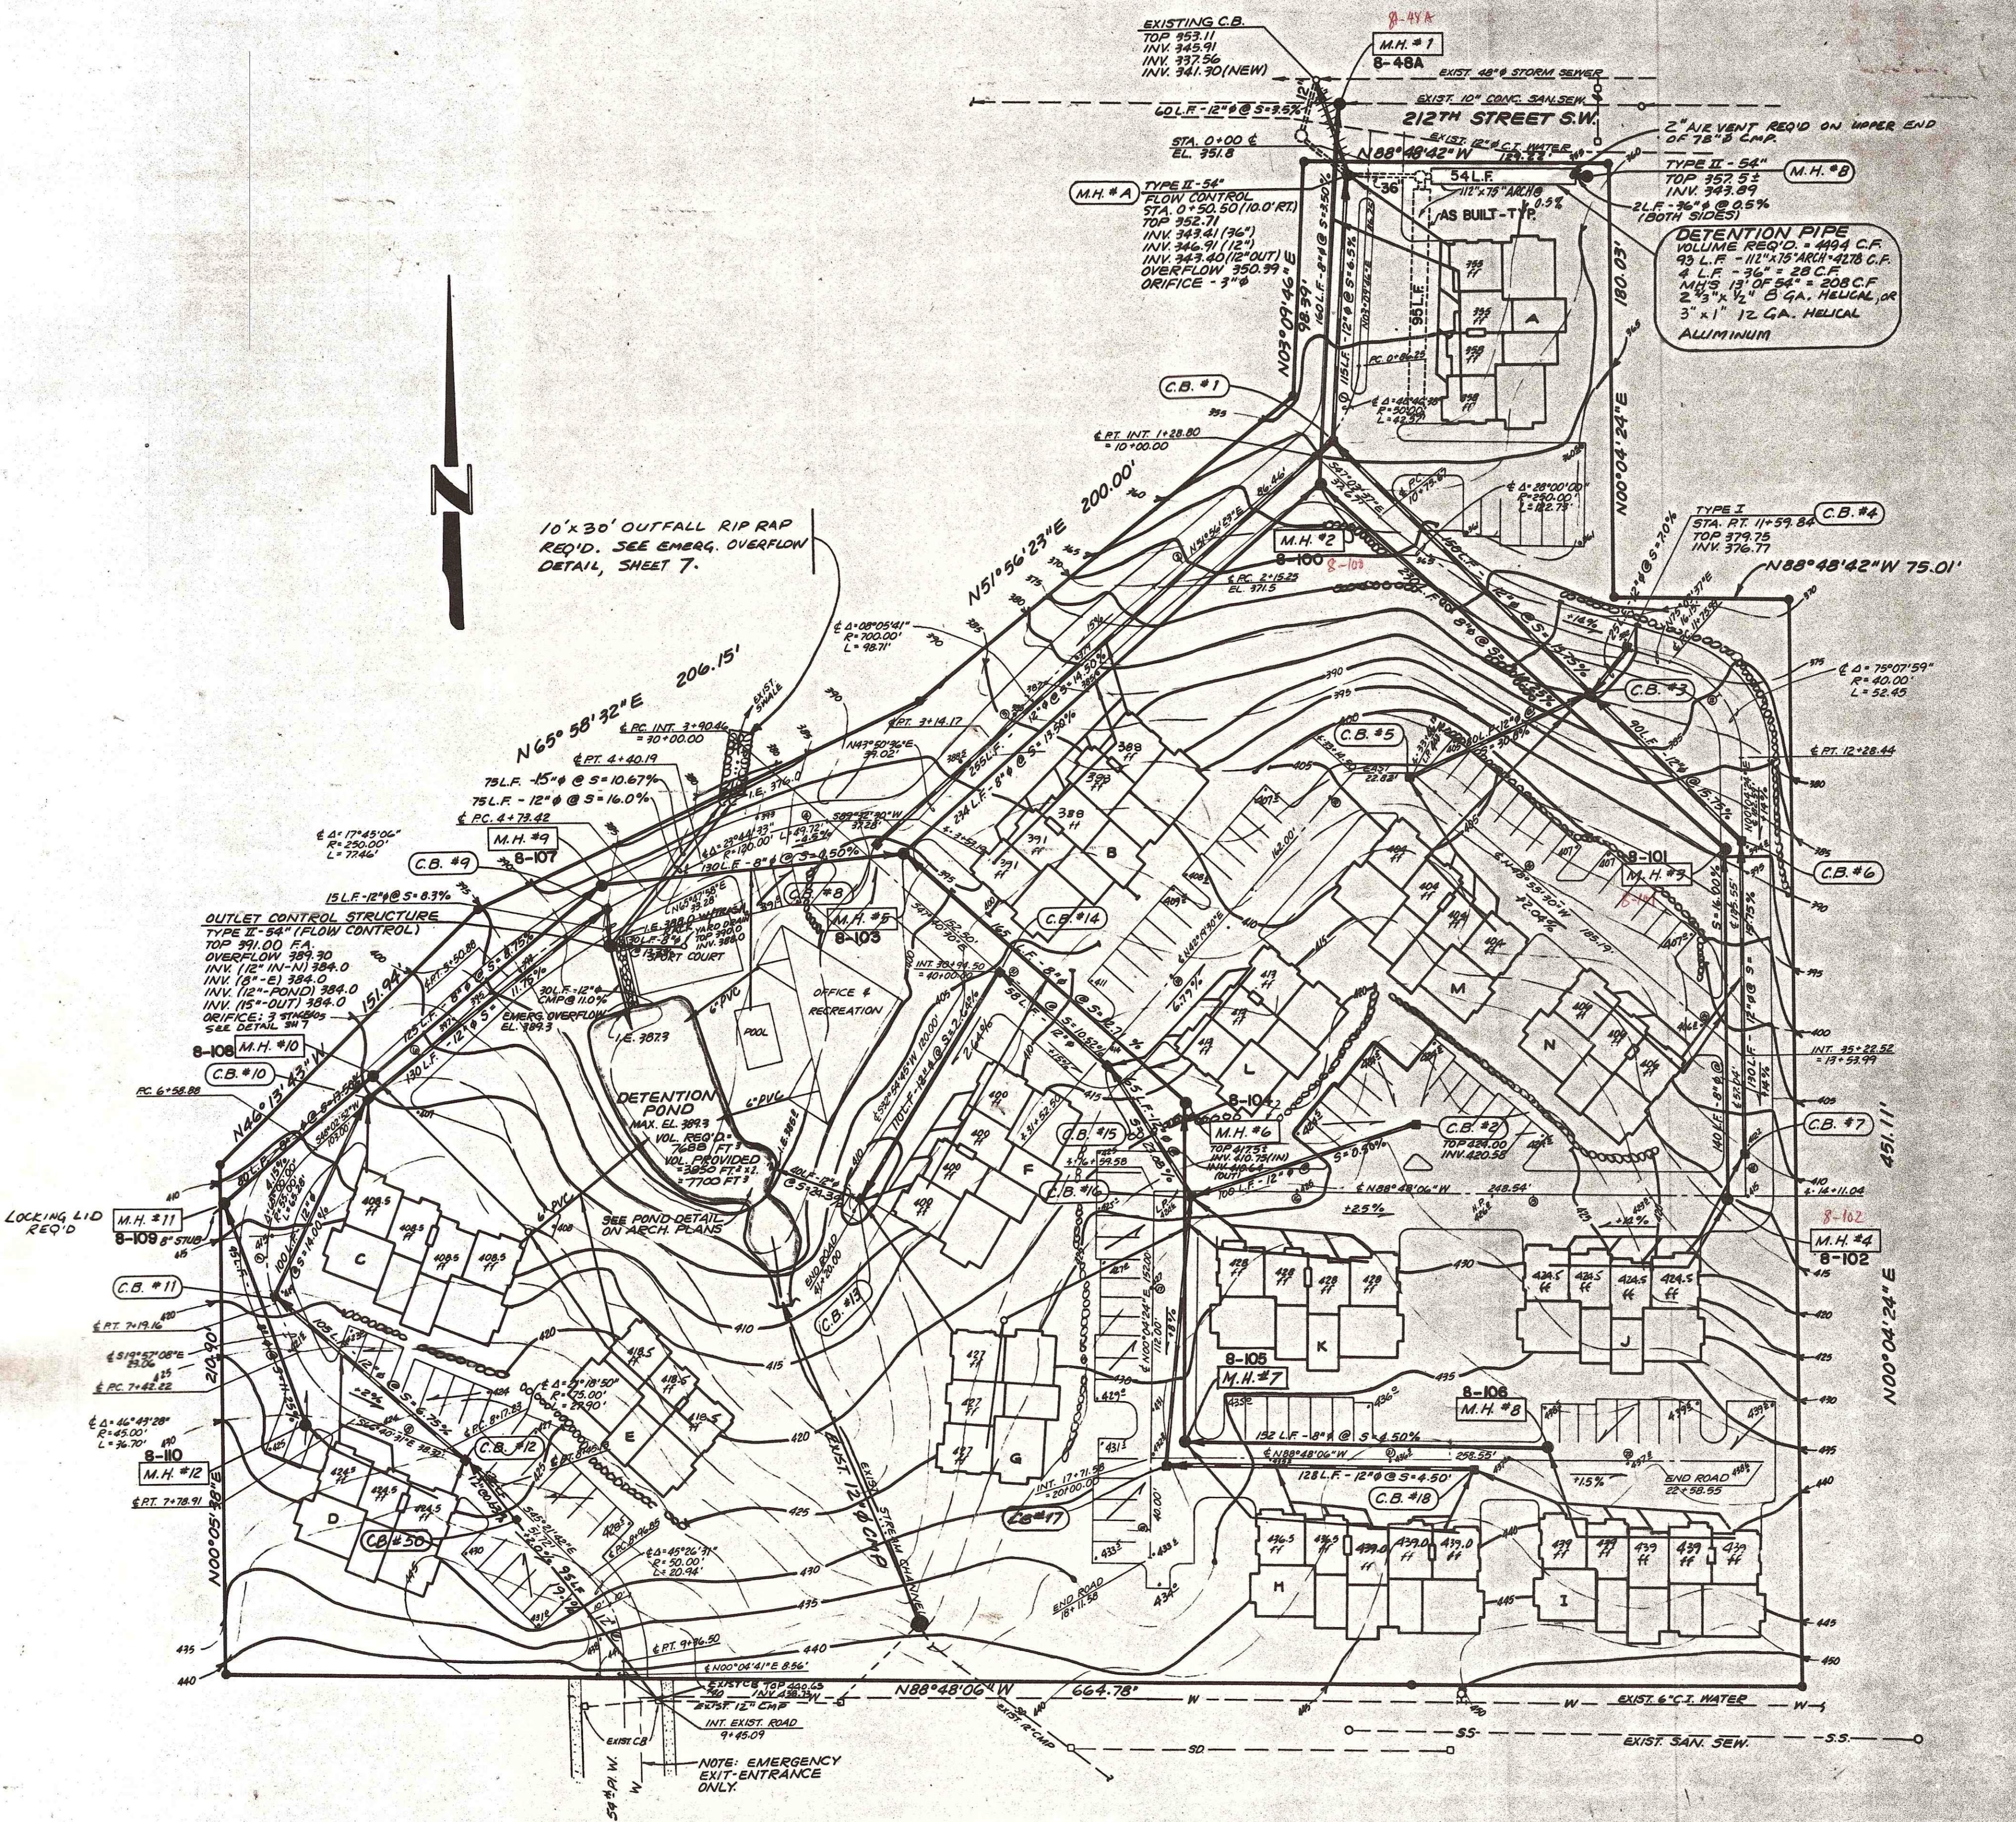

Scan Name: scans06610.pdf
Scan Date:

Sewerage Unit 8-4-A

APPROVED FOR CONSTRUCTION
CITY OF MOUNTLAKE TERRACE
William van Ry June 24, 1985
for Joel Erickson, Ass't City Engineer

MOUNTLAKE TERRACE
MAPLE GLEN APARTMENTS
SAINTY SEWER - STORM DRAINAGE & GRADING PLAN



BOB PARROTT, P.E.
CONSULTING, CIVIL AND
TRANSPORTATION ENGINEERING, SUITE A
1029 MARKET STREET BUILDING, KIRKLAND, WA 98033

AS BUILT - 1985
JOB NO. 86-18
DATE: APRIL 85
SCALE: 1"=40'
DESIGNED
DRAWN: PW
CHECKED: BP
APPROVED: E.P.

2 OF 8