

The City of Mountlake Terrace

APPLICATION

SIDE SEWER PERMIT

OUTSIDE ☐ INSIDE ☐ REPAIRS ☐

CARD No.

EASEMENT No.


OWNER ALBERT M. FLIEHMAN

CONTRACTOR THUNDERBOLT CONST. PERMIT No. 2509

HOUSE No. 22104 52 WEST

STREET 52 WEST AVENUE LOT No. 12 BLOCK No. DIV. 22

NAME ADD.

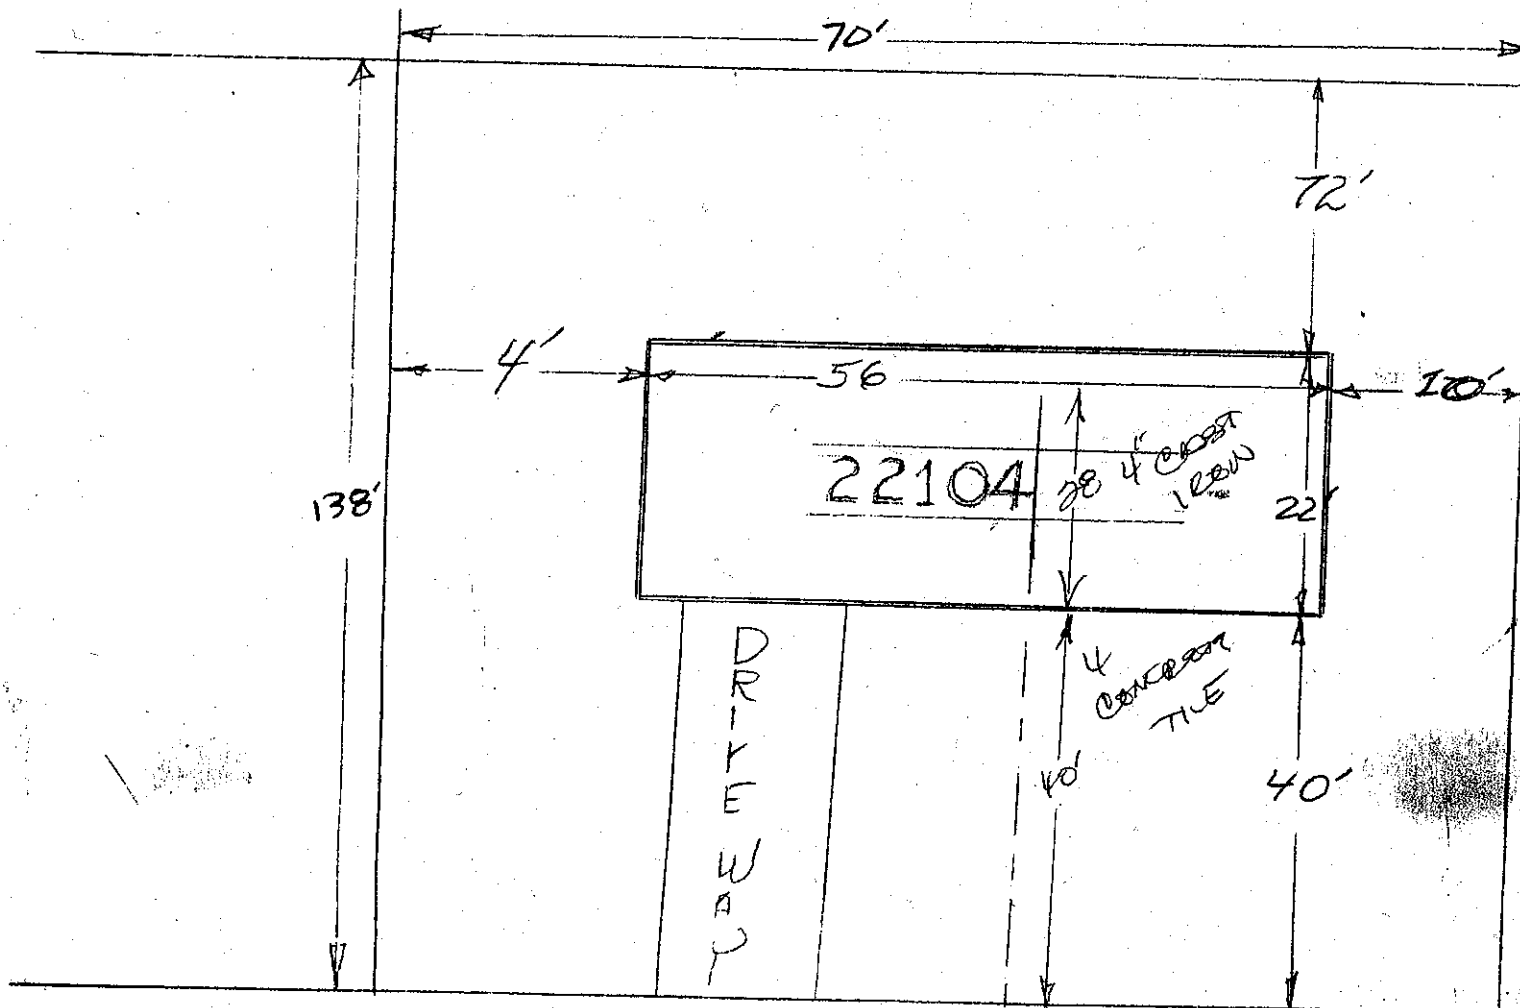

CITY OF MOUNTLAKE TERRACE

APR 22 1960

Plan Approved S. McAfee

PROPOSED SEWER LINE — TO BE CONSTRUCTED OF THE FOLLOWING MATERIALS —
① UNDERHOUSE — 4" CAST IRON — WITH CLEANOUT
② OUTSIDE 4" CONCRETE TILE WITH CLEANOUT

Date

52 WEST Approved:

BACKFILL WORK ORDER ISSUED

DEPOSIT, \$10.00

4/20/60

SEWER WORK ORDER ISSUED

1295

DATE

4-22-60

BY

S. McAfee