

The City of Mountlake Terrace

APPLI ION

for

SIDE SEWER PERMIT


OUTSIDE ☐ INSIDE ☐ REPAIRS ☐

2187

CARD No. _____

EASEMENT No. _____

OWNER Elmer V Moss CONTRACTOR Lynnwood Septic Co PERMIT No. 3200
HOUSE No. 4509 STREET 35
AVENUE LOT No. 35 BLOCK No. 243 pl SW
NAME ADD. Terrace Ridge

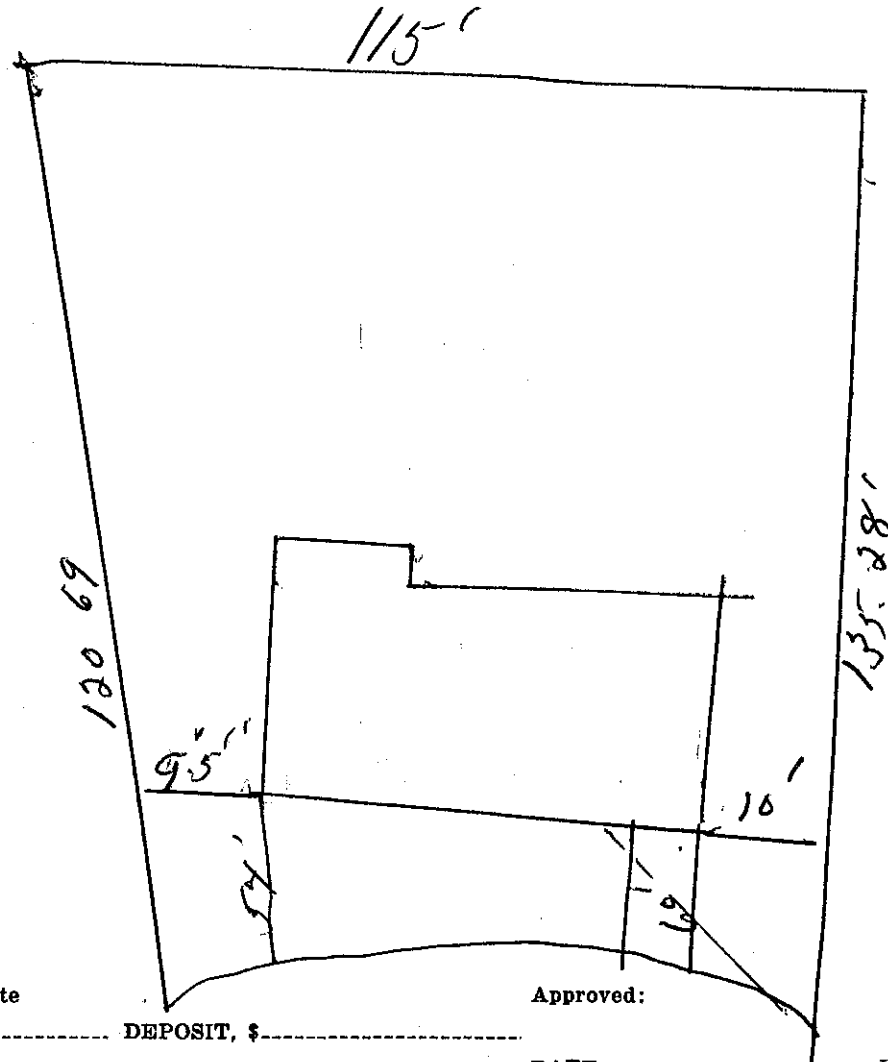

Date _____

Approved: _____

BACKFILL WORK ORDER ISSUED _____ DEPOSIT, \$ _____

SEWER WORK ORDER ISSUED _____

DATE _____ BY _____