

The City of Mountlake Terrace

APPLICATION

for

SIDE SEWER PERMIT

OUTSIDE ☐ INSIDE ☐ REPAIRS ☐

CARD No. _____

EASEMENT No. _____

OWNER Wick Homes

CONTRACTOR North End Septic Tank Co. PERMIT No. _____


HOUSE No. 24215 - 52nd W

STREET

AVENUE LOT No. _____

BLOCK No. _____

NAME ADD. _____

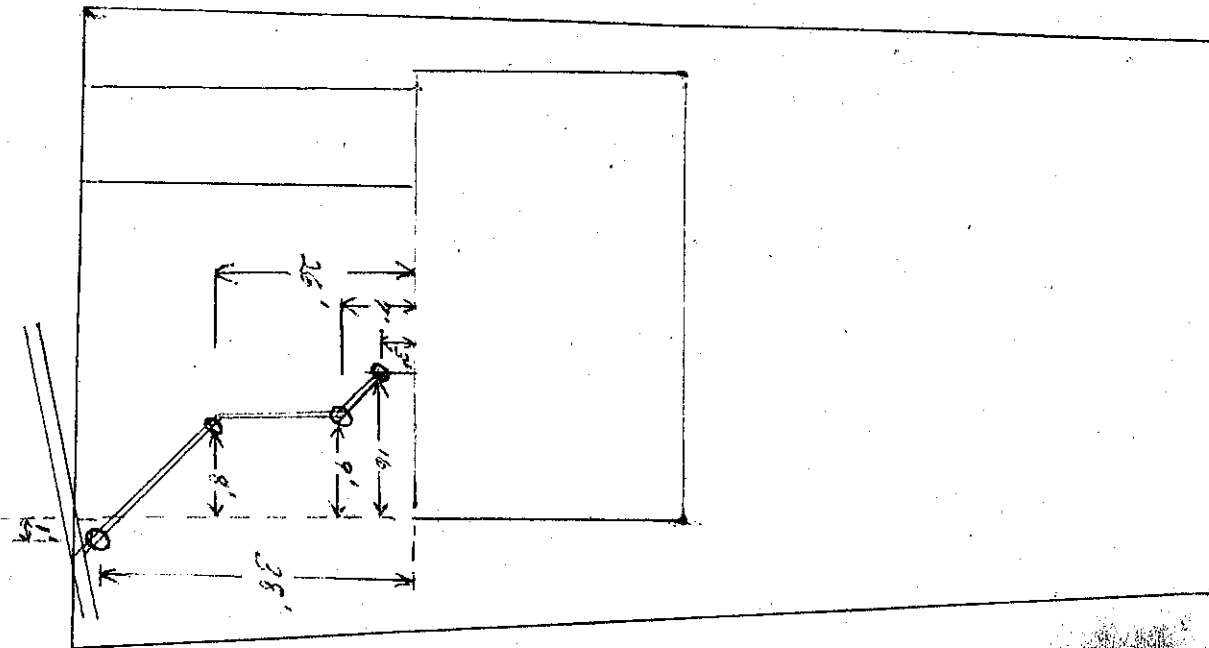

Date

Approved:

BACKFILL WORK ORDER ISSUED _____

DEPOSIT, \$ _____

SEWER WORK ORDER ISSUED _____

DATE

BY