

APPLICATION

The City of Mountlake Terrace


SIDE SEWER PERMIT

CARD No. _____

OUTSIDE ☐ INSIDE ☐ REPAIRS ☐

EASEMENT No. _____

OWNER Parkwood Homes Inc CONTRACTOR Lynnwood Septic Tank Co PERMIT No. 3966
 HOUSE No. 4506 - 219th St STREET 2195 W Lot 11 BLOCK No. # 14159
 NAME ADDR Parkwood lanes

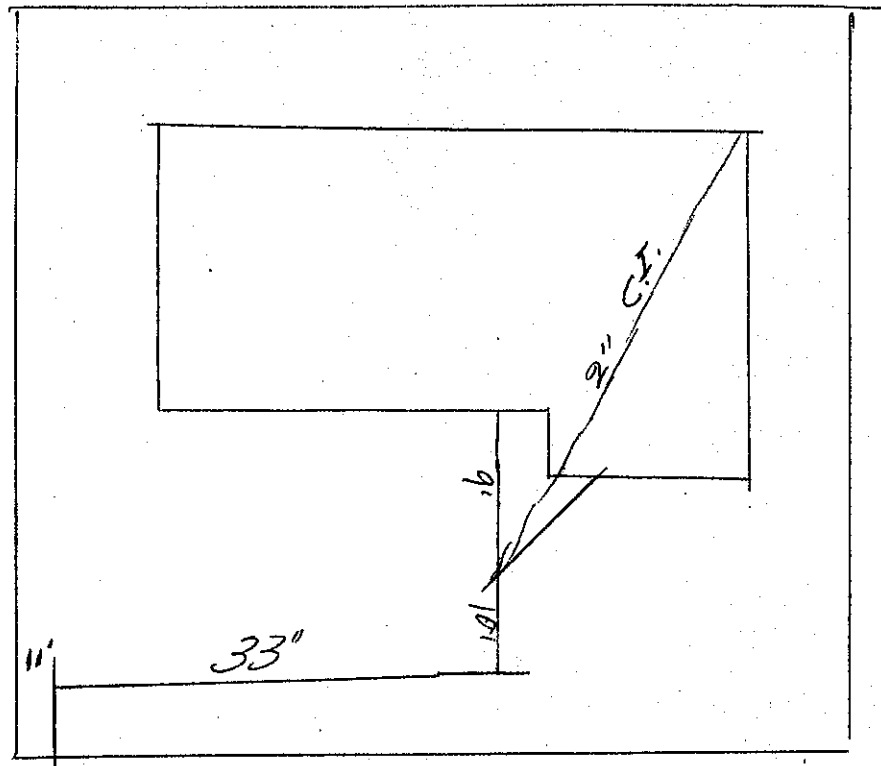

CITY OF
MOUNTLAKE TERRACE

JUL 9
Plan Approved [Signature]

Date

Approved:

BACKFILL WORK ORDER ISSUED _____ DEPOSIT, \$ _____

SEWER WORK ORDER ISSUED _____

DATE _____ BY _____